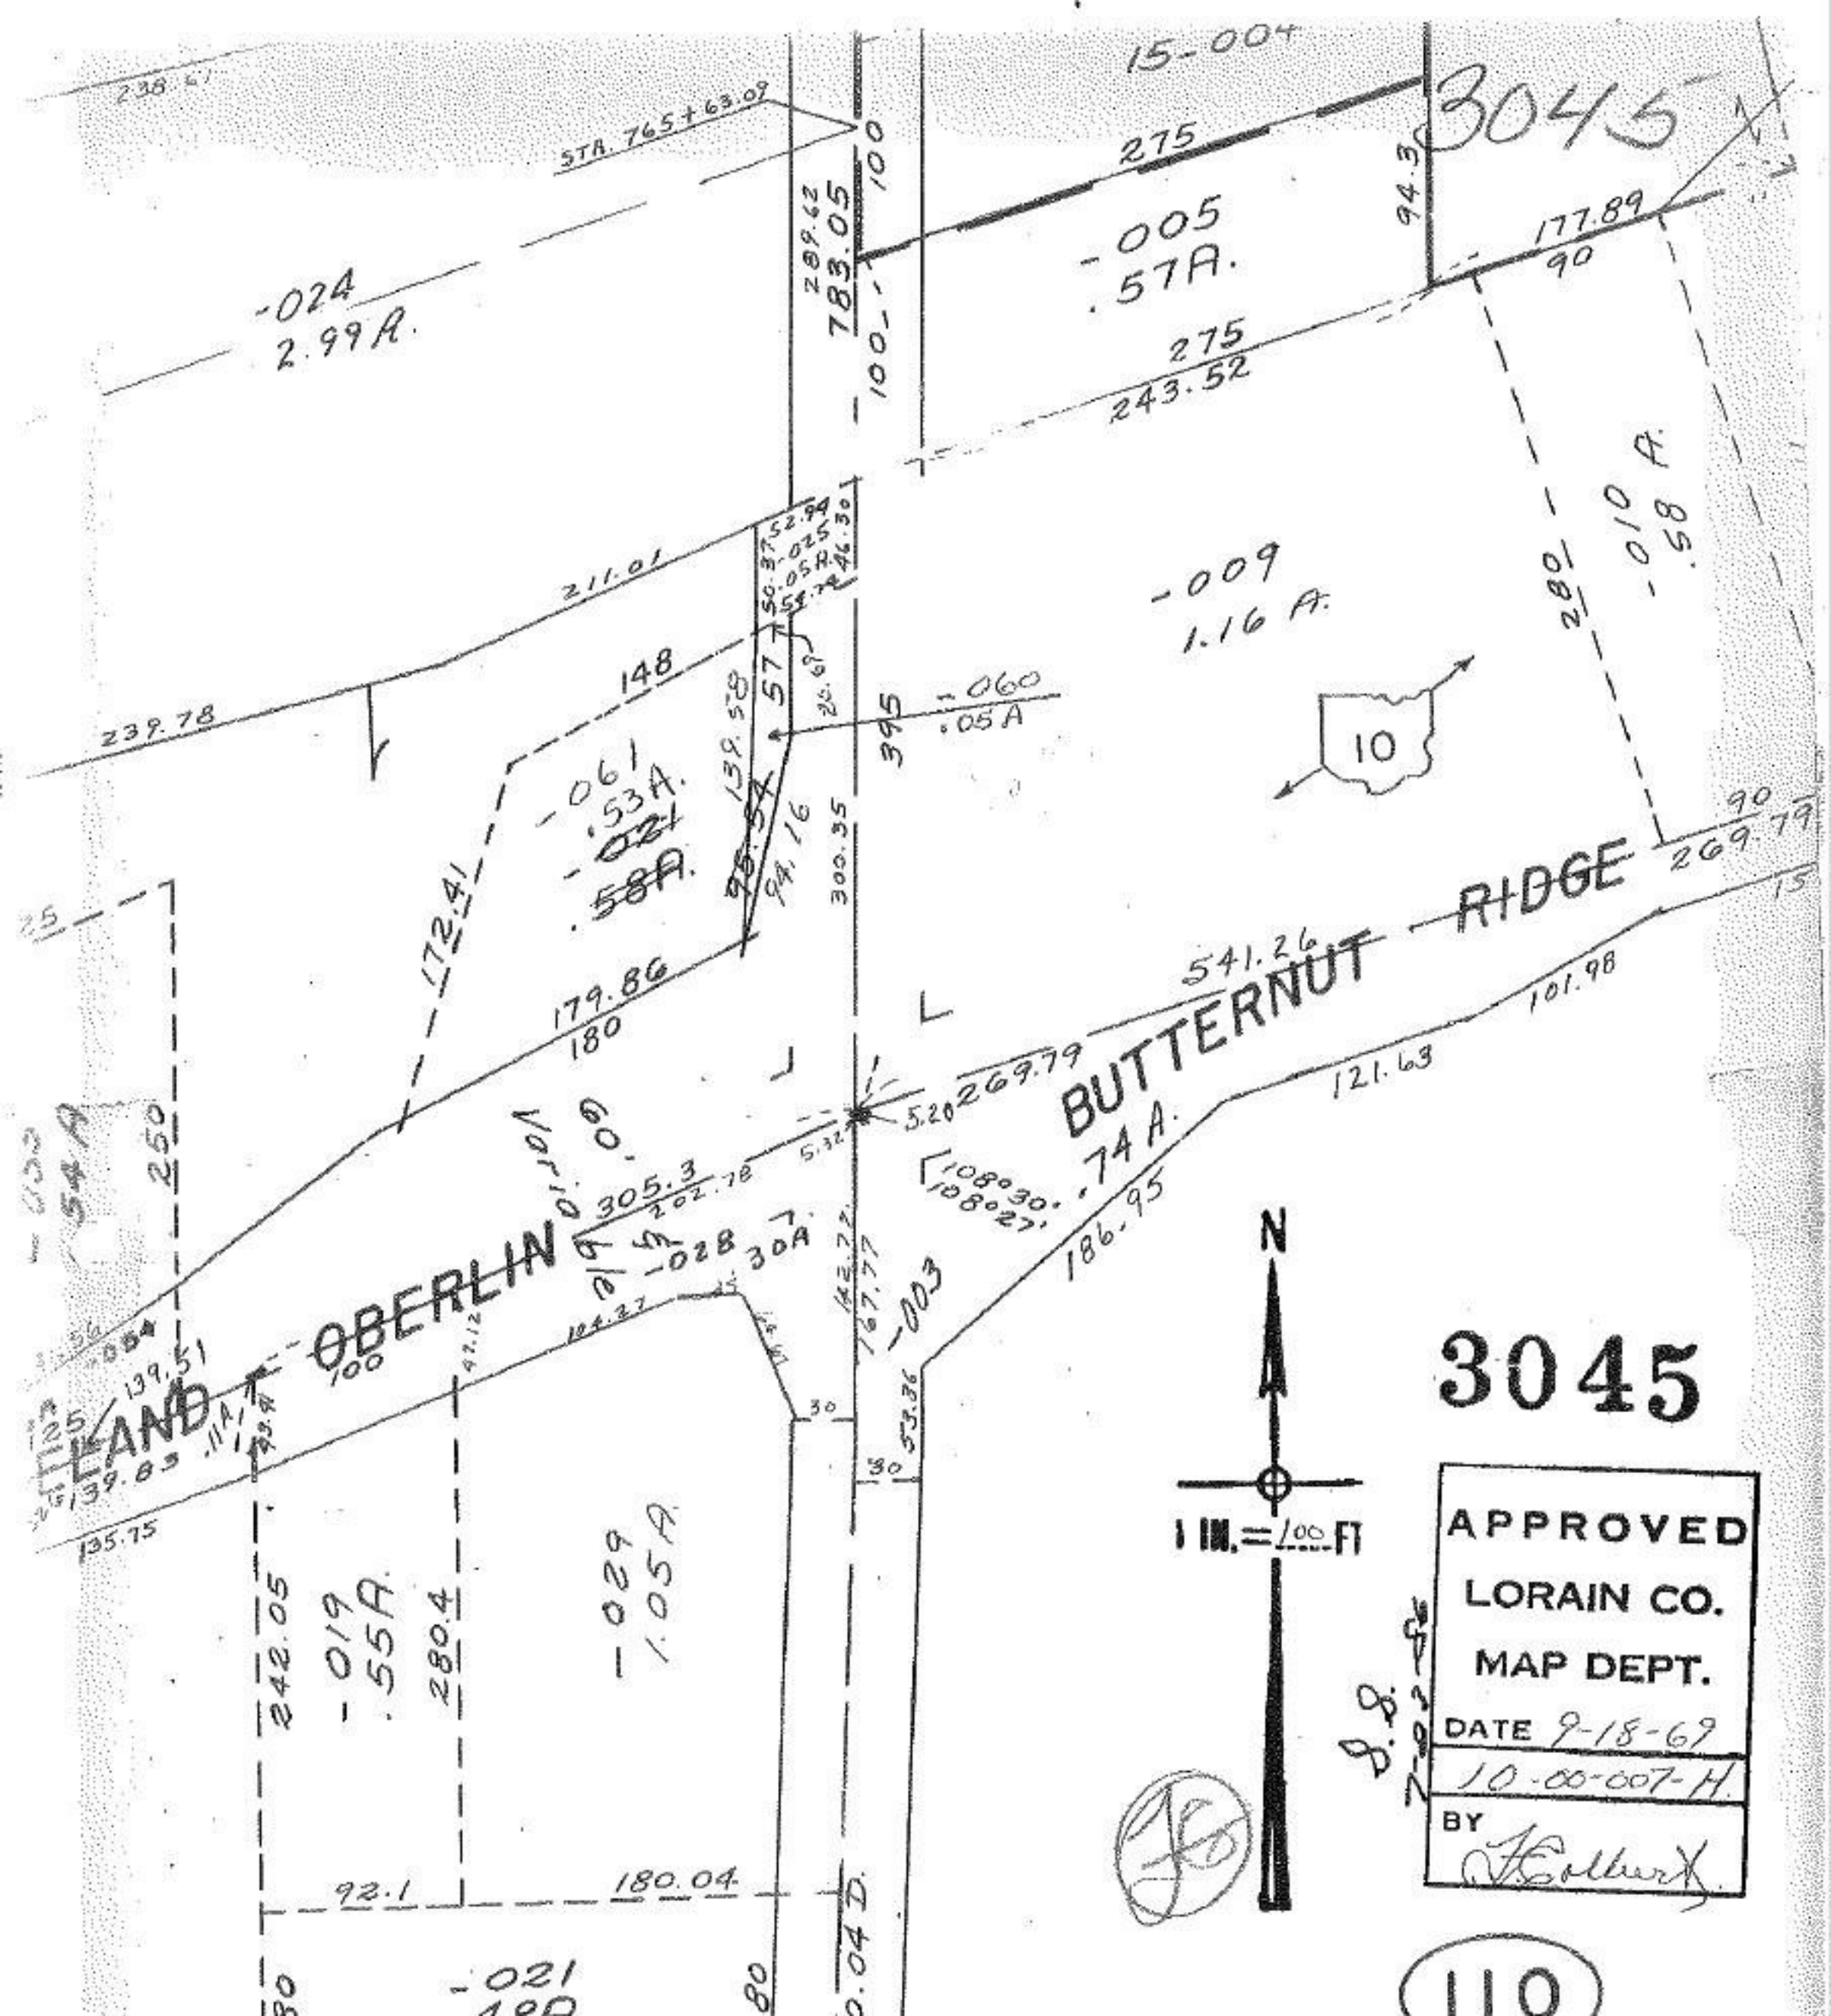

15-004
3045
STA. 765+63.09
275
-005
.57A.
-024
2.99A.
177.89
90
275
243.52
211.01
-009
1.16 A.
-010
.58 A.
148
239.78
-060
.05 A
395
10
-061
.53A.
-021
.58A.
172.41
179.86
180
541.26
BUTTERNUT RIDGE
269.79
101.98
121.63
.74 A.
186.95
305.3
202.78
-028
30A
-003
OBERLIN
LAND
139.51
139.83
135.75
242.05
-019
.55A.
280.4
-029
1.05A.
92.1
180.04
-021
N
1 IN. = 100 FT
3045
APPROVED
LORAIN CO.
MAP DEPT.
DATE 9-18-69
10-00-007-H
BY
110