985-205

3047

OCT 8 1969

3047
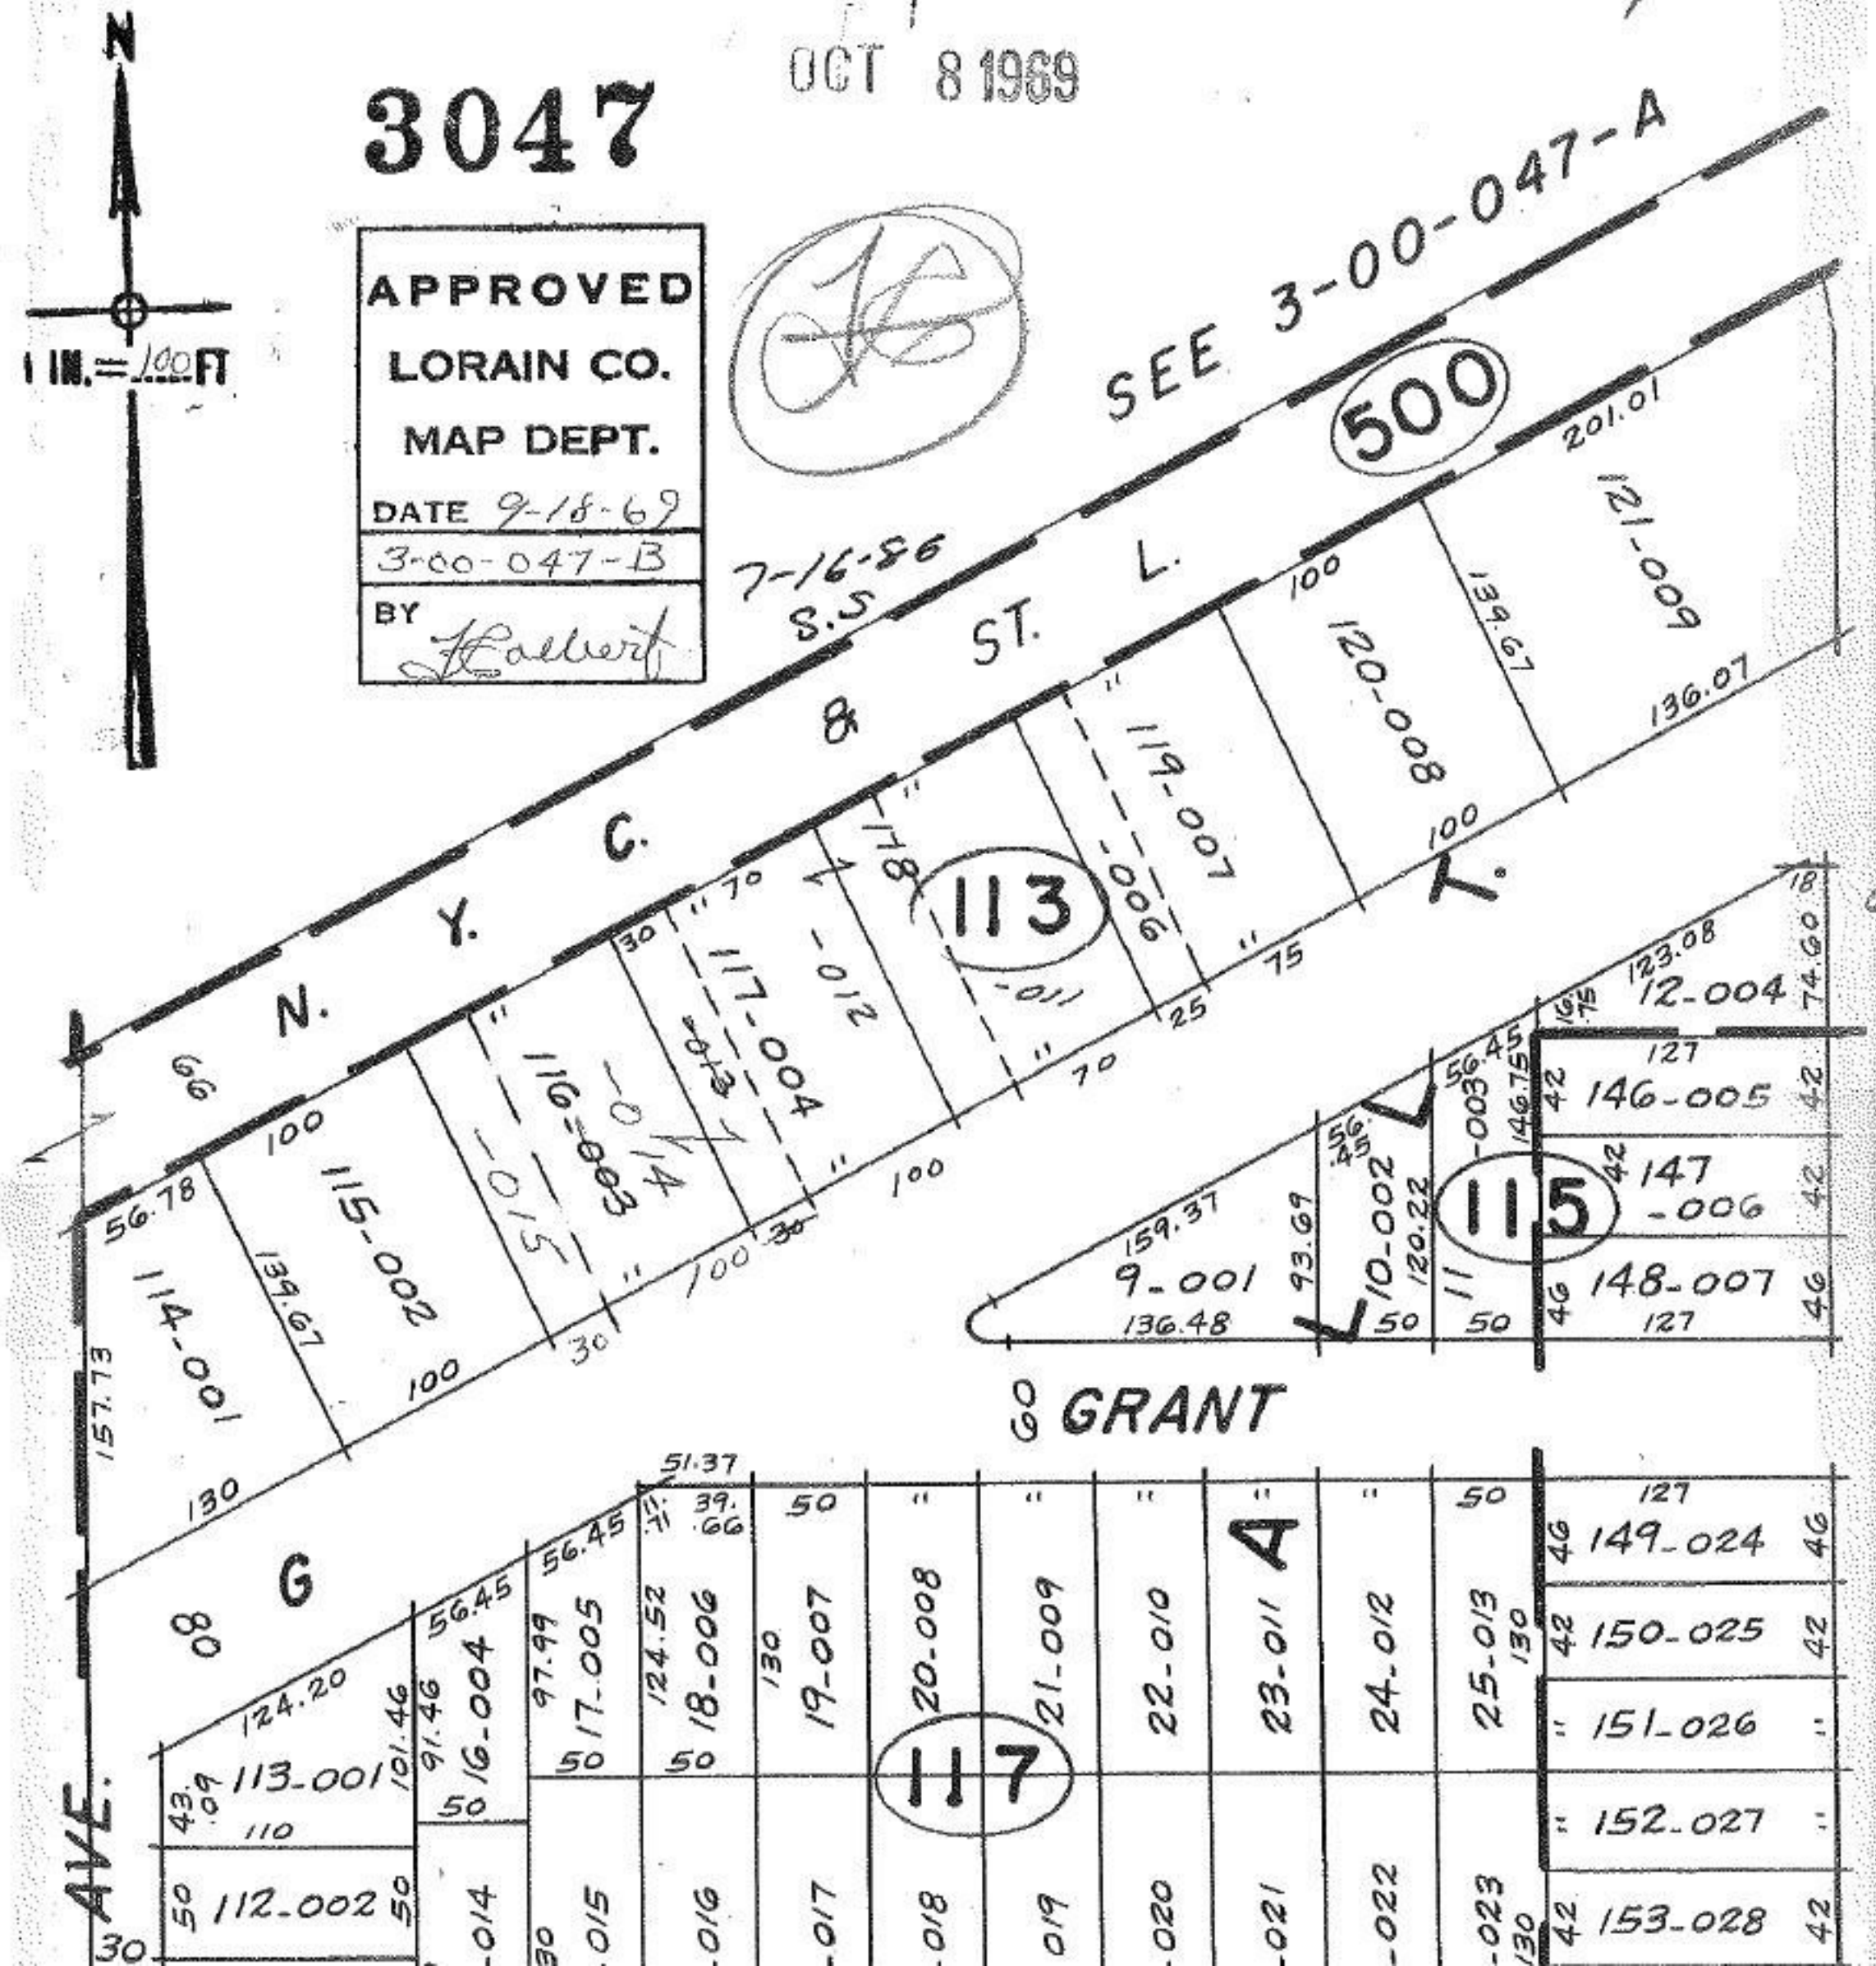
APPROVED
LORAIN CO.
MAP DEPT.
DATE 9-18-69
3-00-047-B
BY [signature]