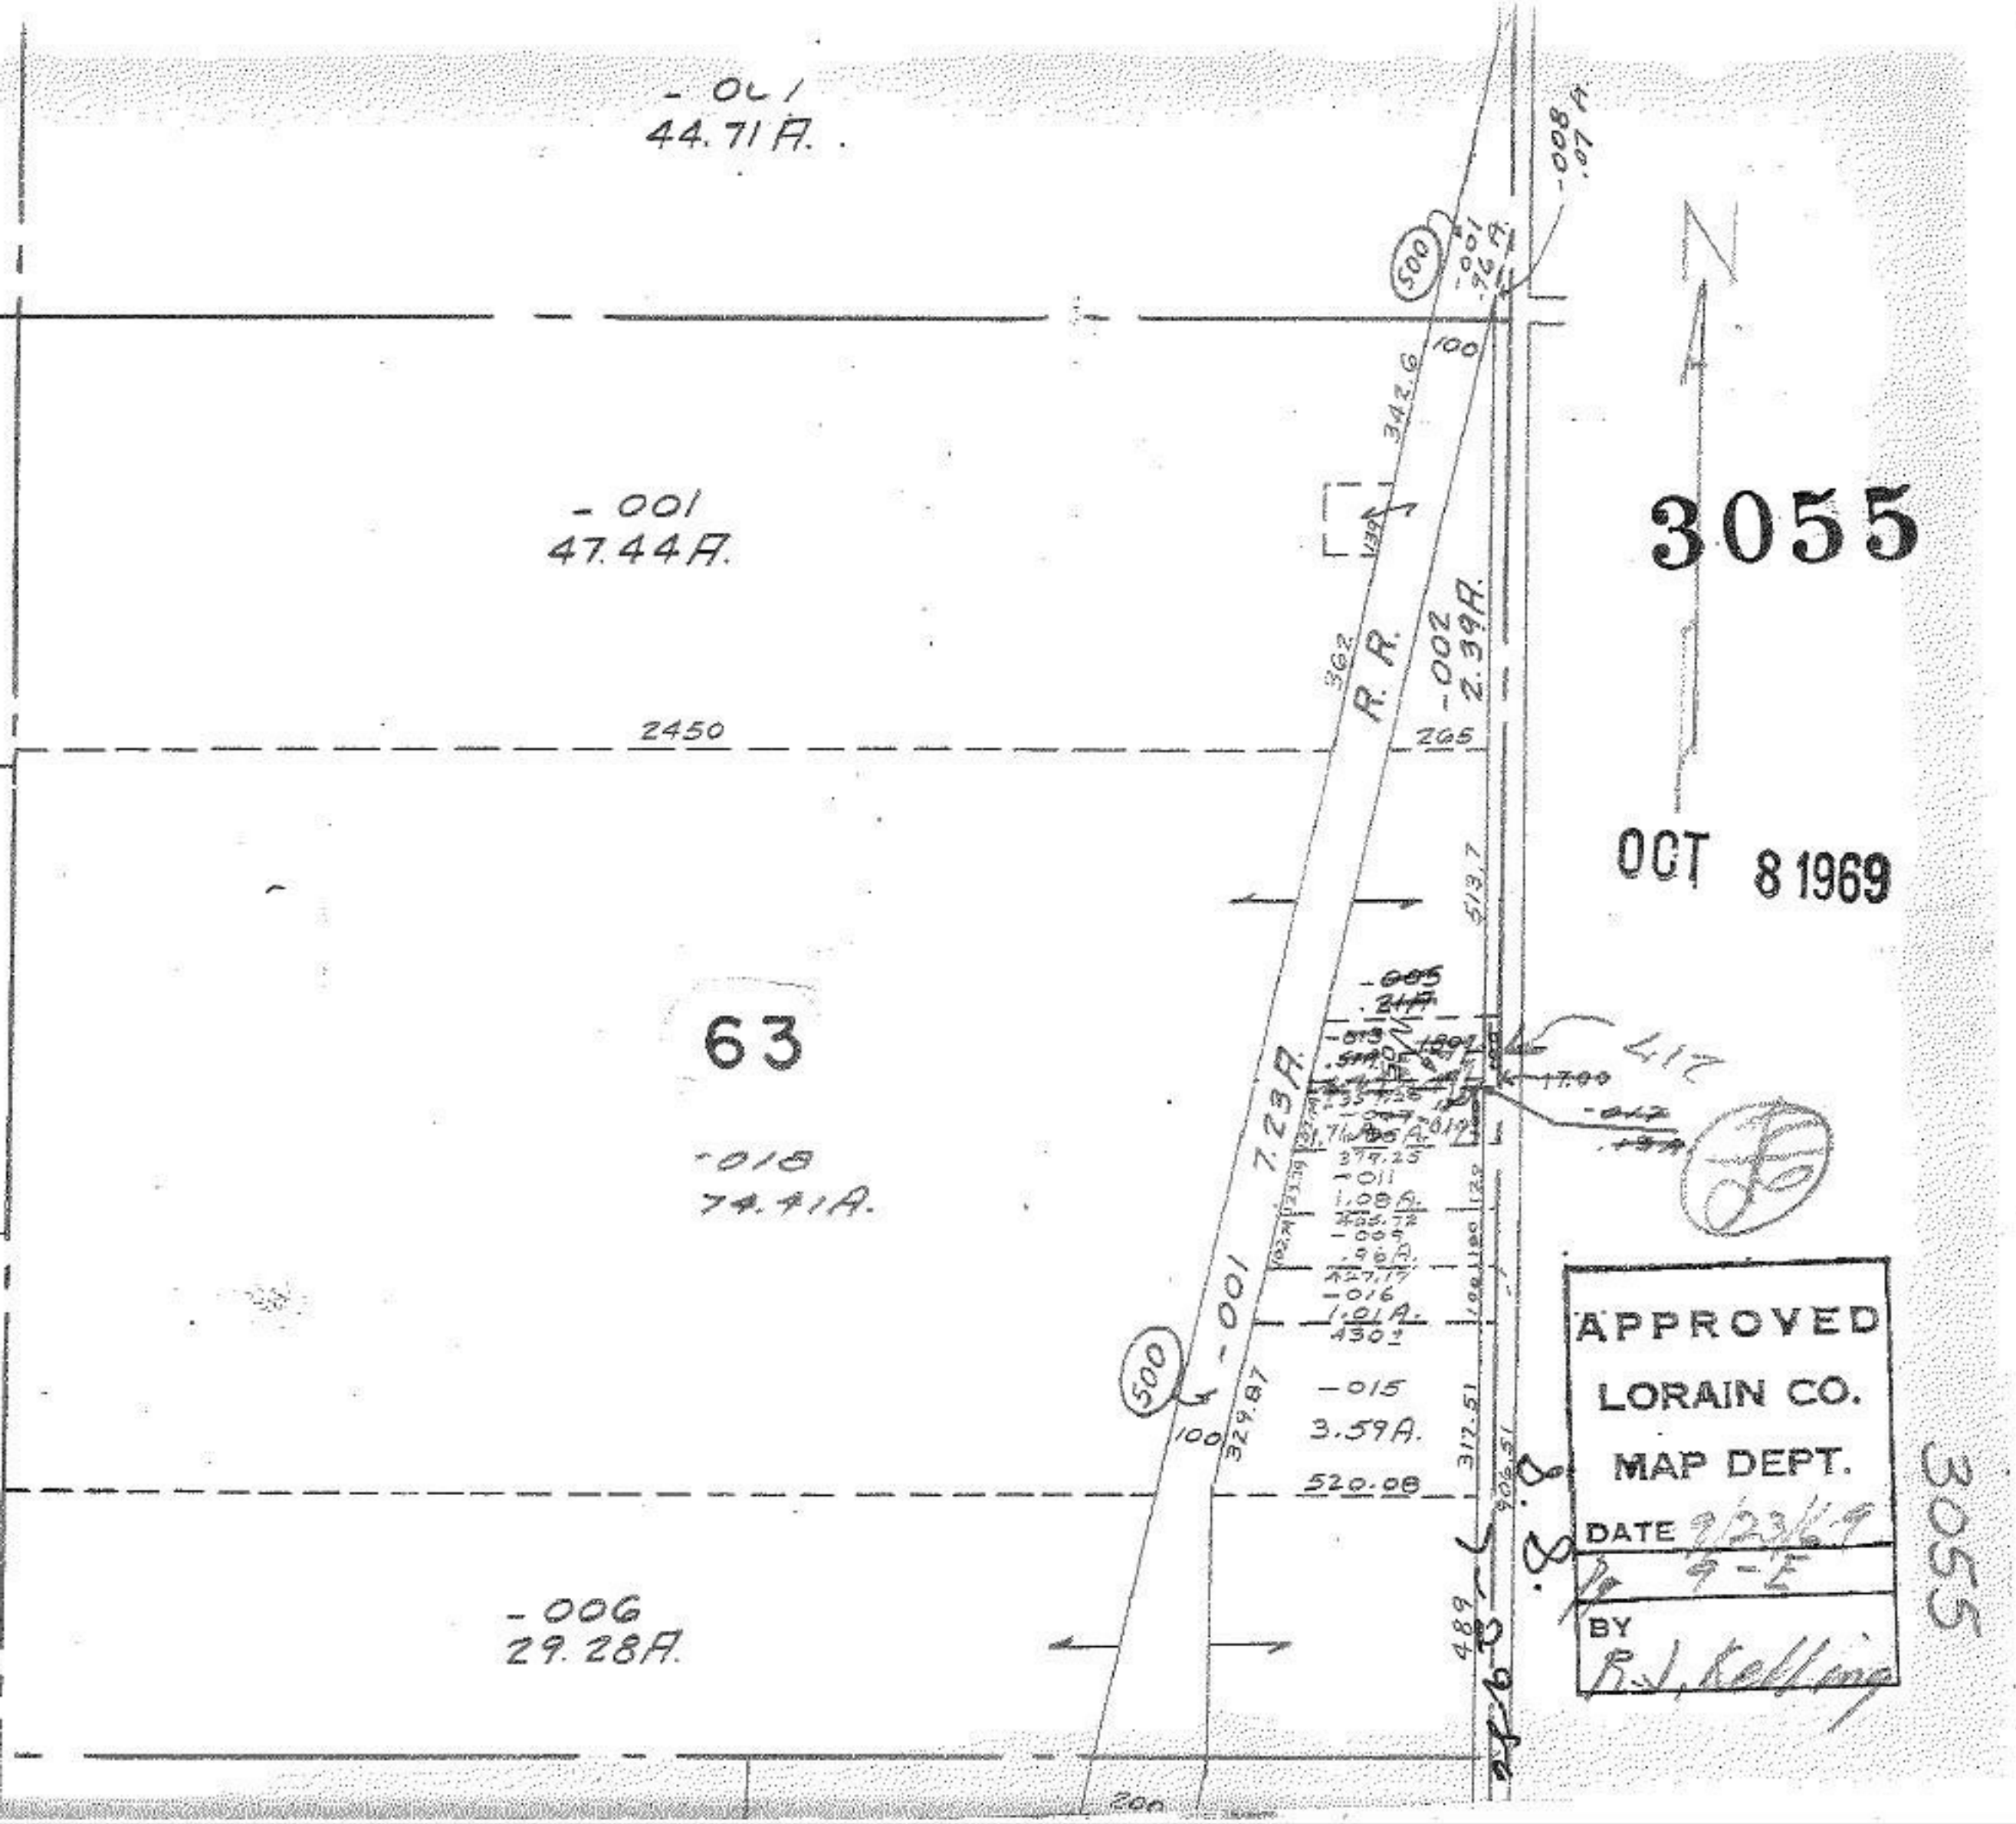

-001
44.71A.
-001
47.44A.
2450
63
-018
74.41A.
-006
29.28A.
500
100
342.6
362
R.R.
-002
2.39A.
265
513.7
-005
-013
-017
-011
1.08A.
-009
.96A.
-016
1.01A.
430±
-015
3.59A.
520.08
329.87
317.51
489
-001
7.23A.
-008
.07A.
-001
.96A.
417
17.00
N
3055
OCT 8 1969
APPROVED
LORAIN CO.
MAP DEPT.
DATE 9/23/69
9-E
BY
R.J. Kelling
3055