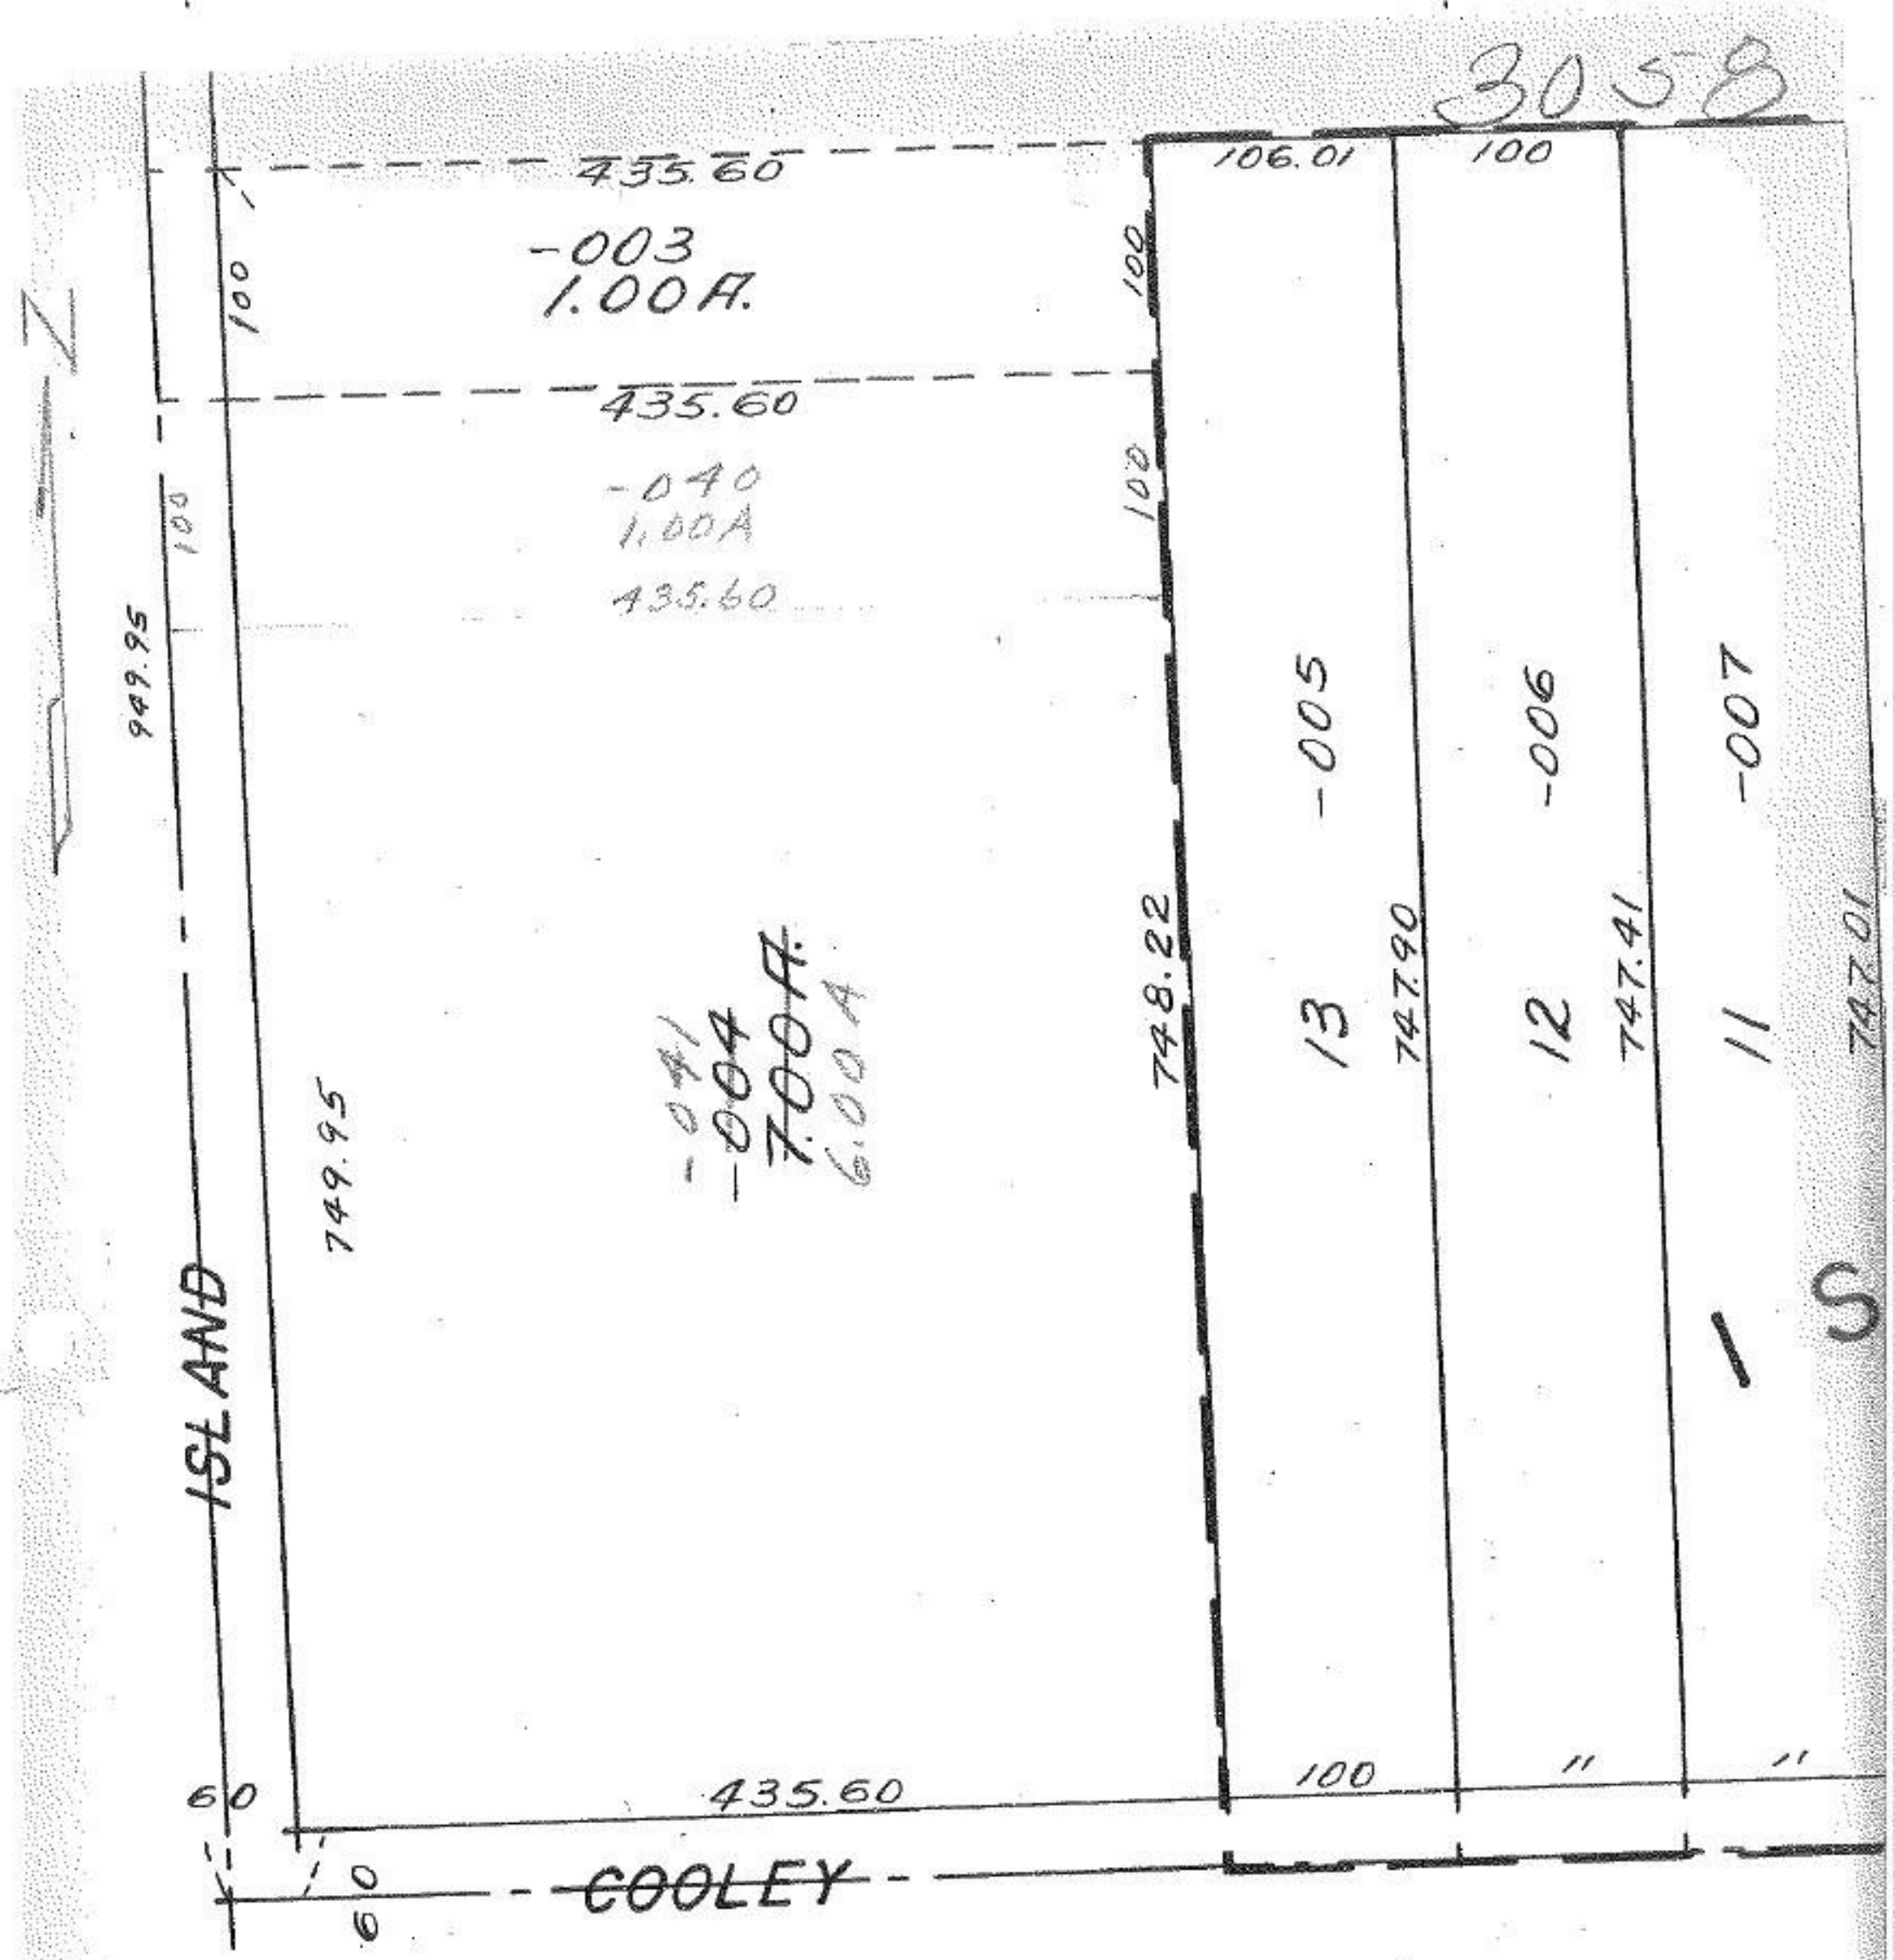

APPROVED
LORAIN CO.

OCT 8 1969