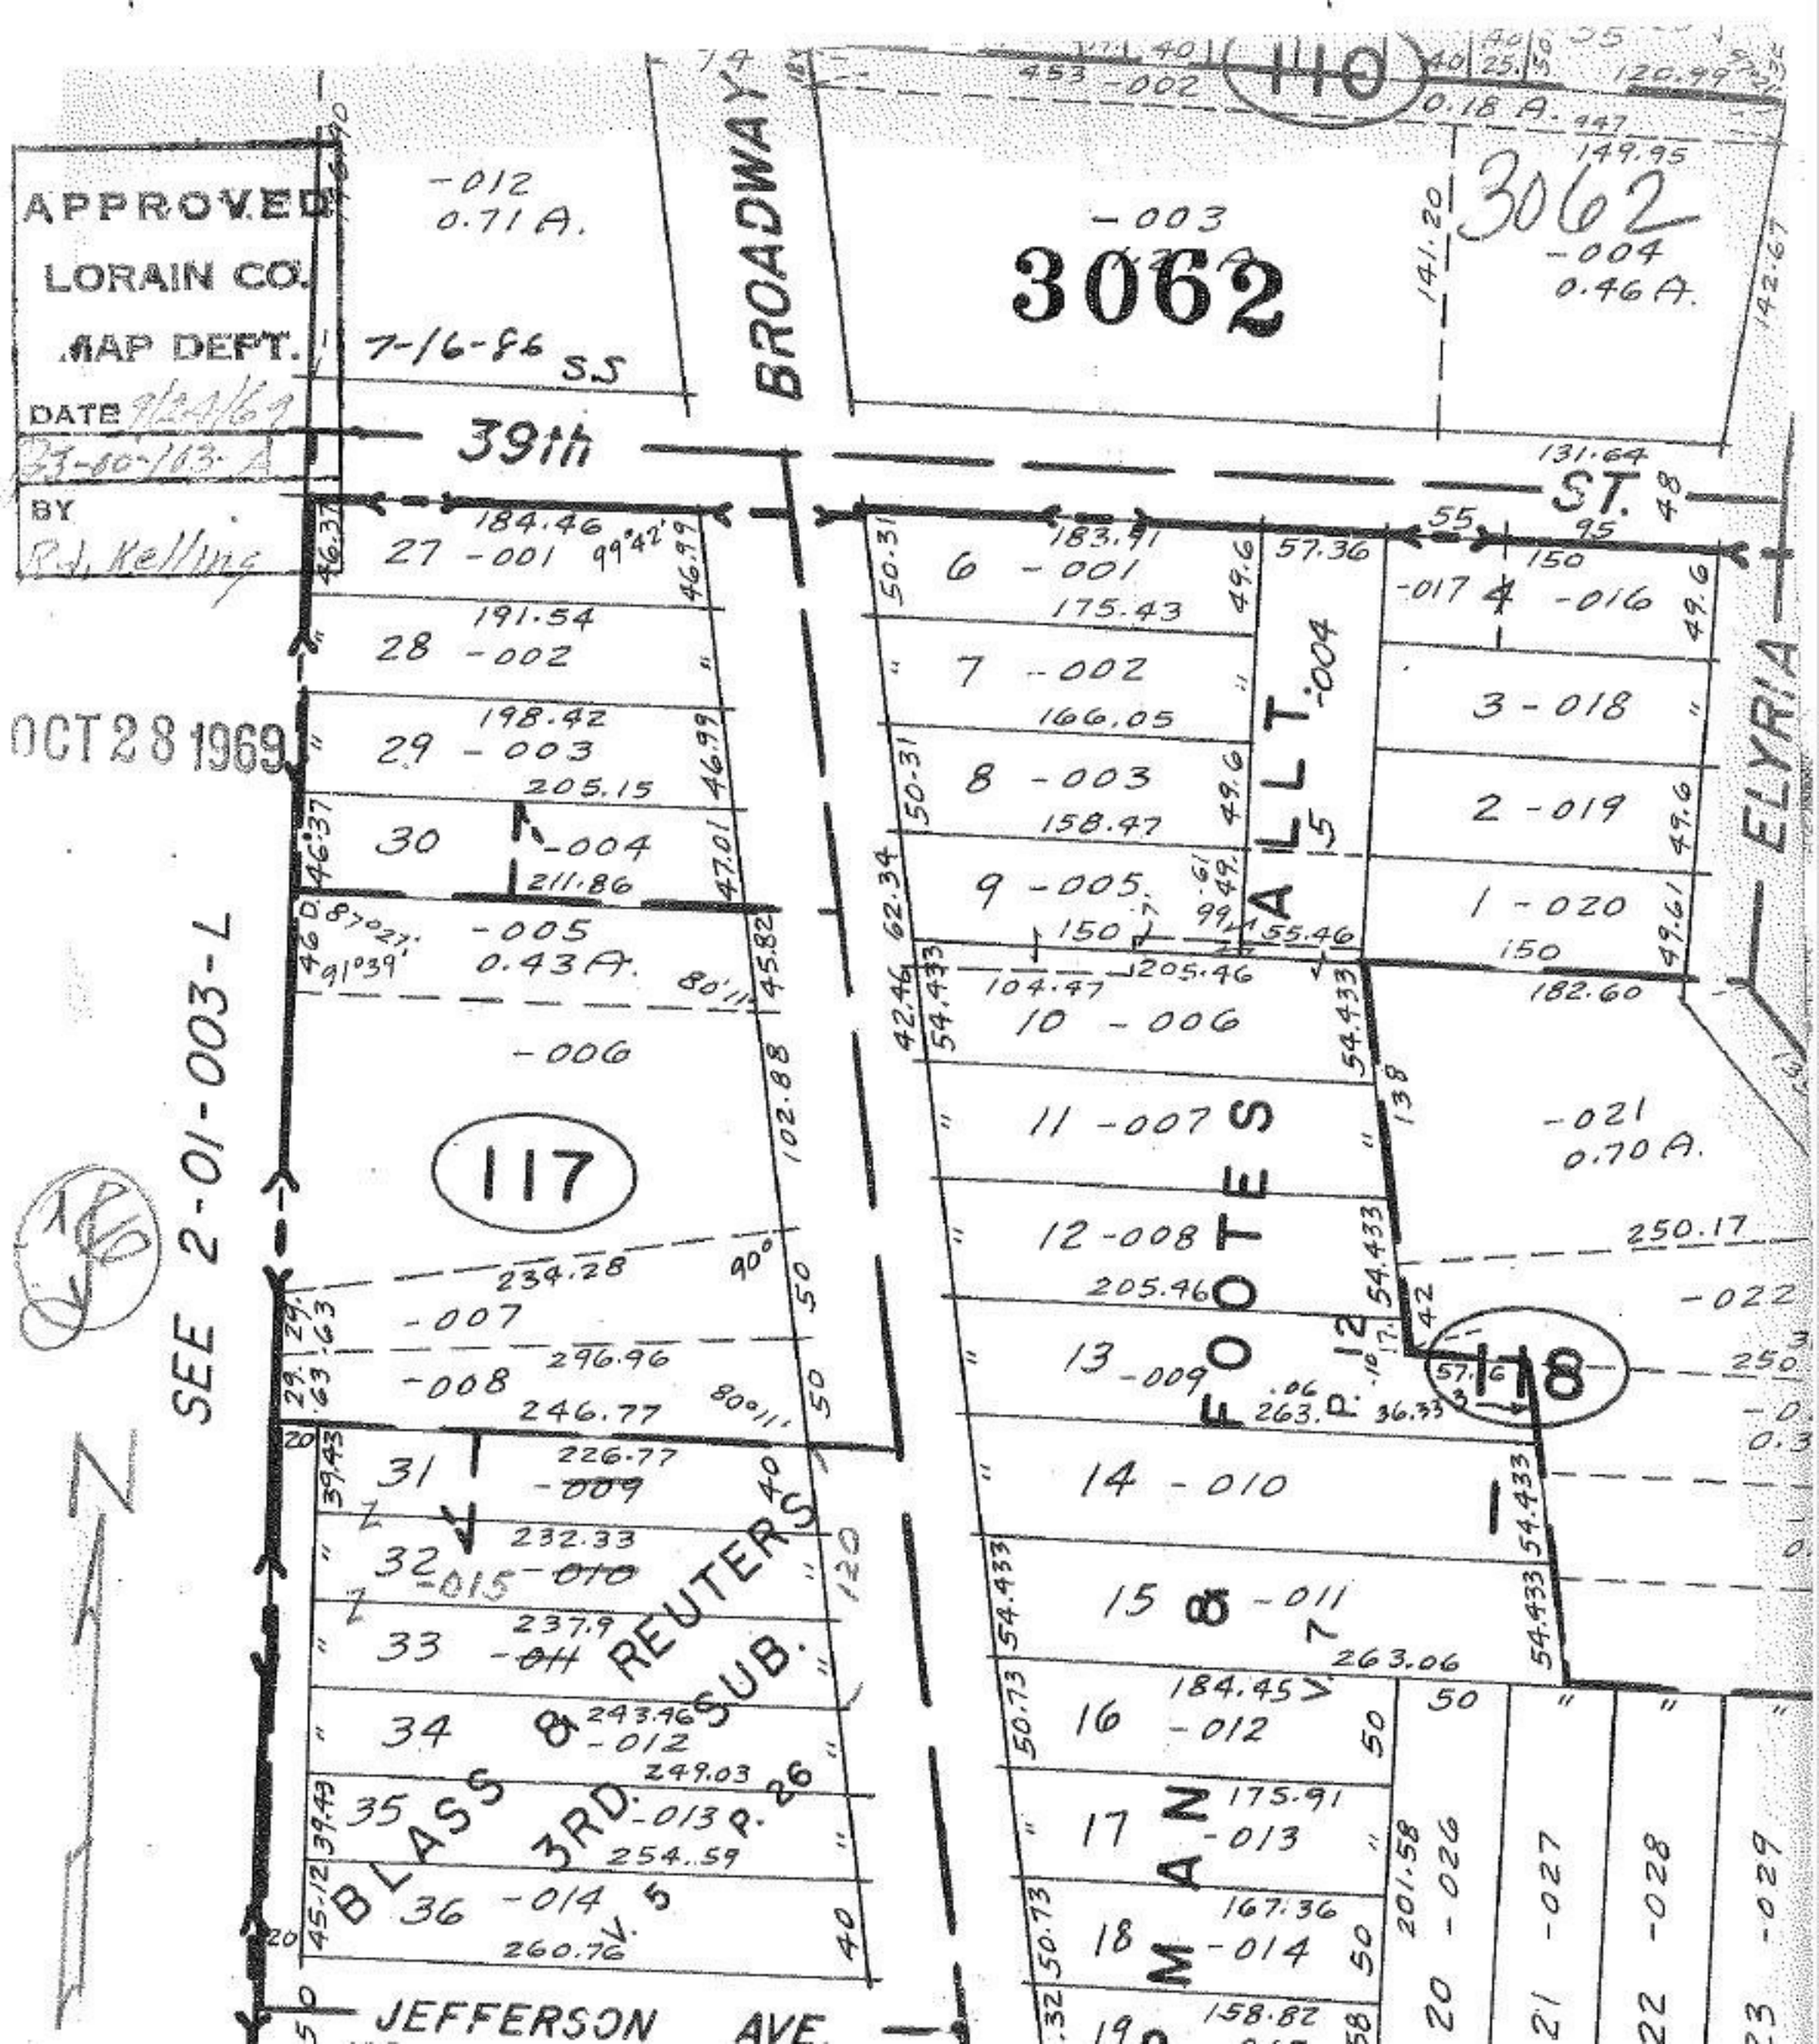
APPROVED
LORAIN CO.
MAP DEPT.
DATE 9/24/69
BY R.J. Kelling
OCT 28 1969
SEE 2-01-003-L
BROADWAY
39th ST.
ELYRIA
JEFFERSON AVE.
BLASS & REUTERS 3RD. SUB.
FOOTES ALLT.
117
118
3062
-012 0.71 A.
-003
-004 0.46 A.
-005 0.43 A.
-006
-007
-008
-009
-010
-011
-012
-013
-014
-015
-016
-017
-018
-019
-020
-021 0.70 A.
-022
-023
-024
-025
-026
-027
-028
-029
27 -001
28 -002
29 -003
30 -004
31
32
33
34
35
36
6 -001
7 -002
8 -003
9 -005
10 -006
11 -007
12 -008
13 -009
14 -010
15 -011
16 -012
17 -013
18 -014
19
20
21
22
23
4 -016
3 -018
2 -019
1 -020
184.46
191.54
198.42
205.15
211.86
234.28
296.96
246.77
226.77
232.33
237.9
243.46
249.03
254.59
260.76
183.91
175.43
166.05
158.47
150
104.47
205.46
205.46
263.06
184.45
175.91
167.36
158.82
182.60
250.17
131.64
149.95
120.99
141.20
142.67
99°42'
87°27'
91°39'
80°11'
90°
120
55
95
48
50
40
20
50.31
49.6
57.36
62.34
54.433
42.46
138
42
57.6
36.33
50.73
201.58
45.12
39.43
46.37
46.99
47.01
45.82
102.88
29.63
45.12
20
40
50
120
55
95
150
49.6
49.61
55.46
54.433
57.6
36.33
50.73
50
40
20
21
22
23
-024
-025
-026
-027
-028
-029