SEE 9-00-075-

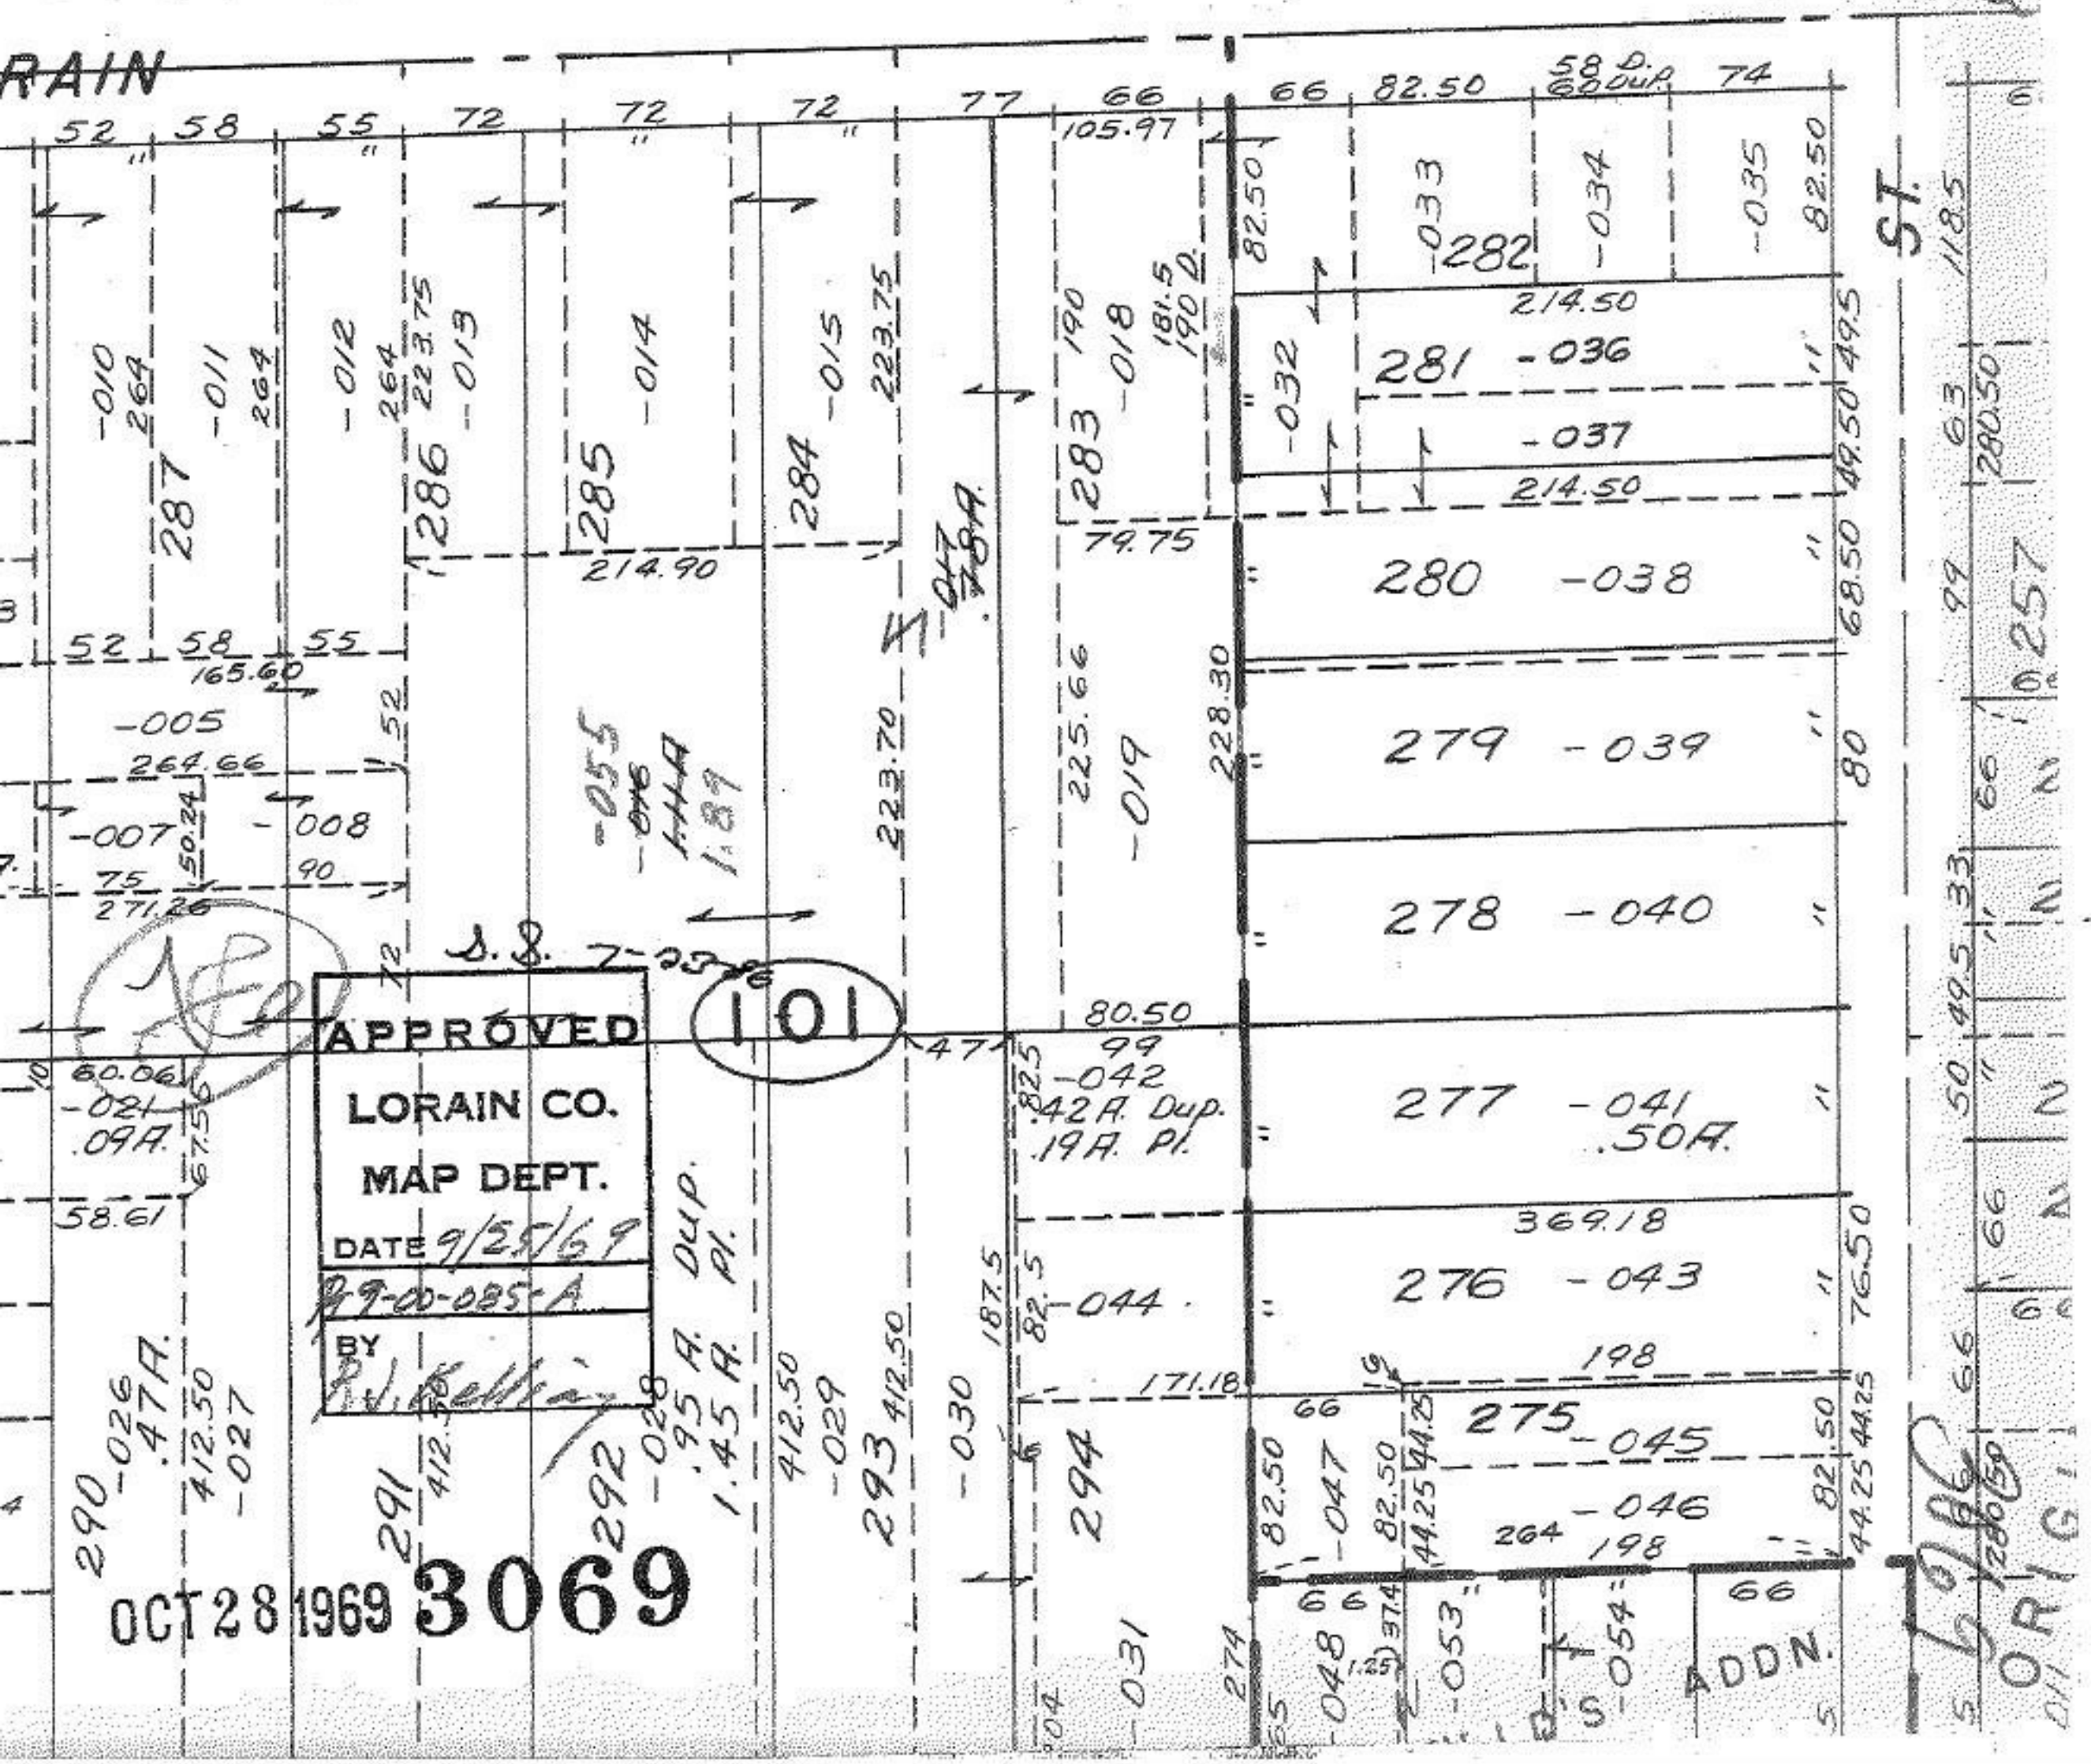

RAIN
ST.
101
APPROVED
LORAIN CO.
MAP DEPT.
DATE 9/25/69
9-00-085-A
BY
OCT 28 1969
3069
ADDN.