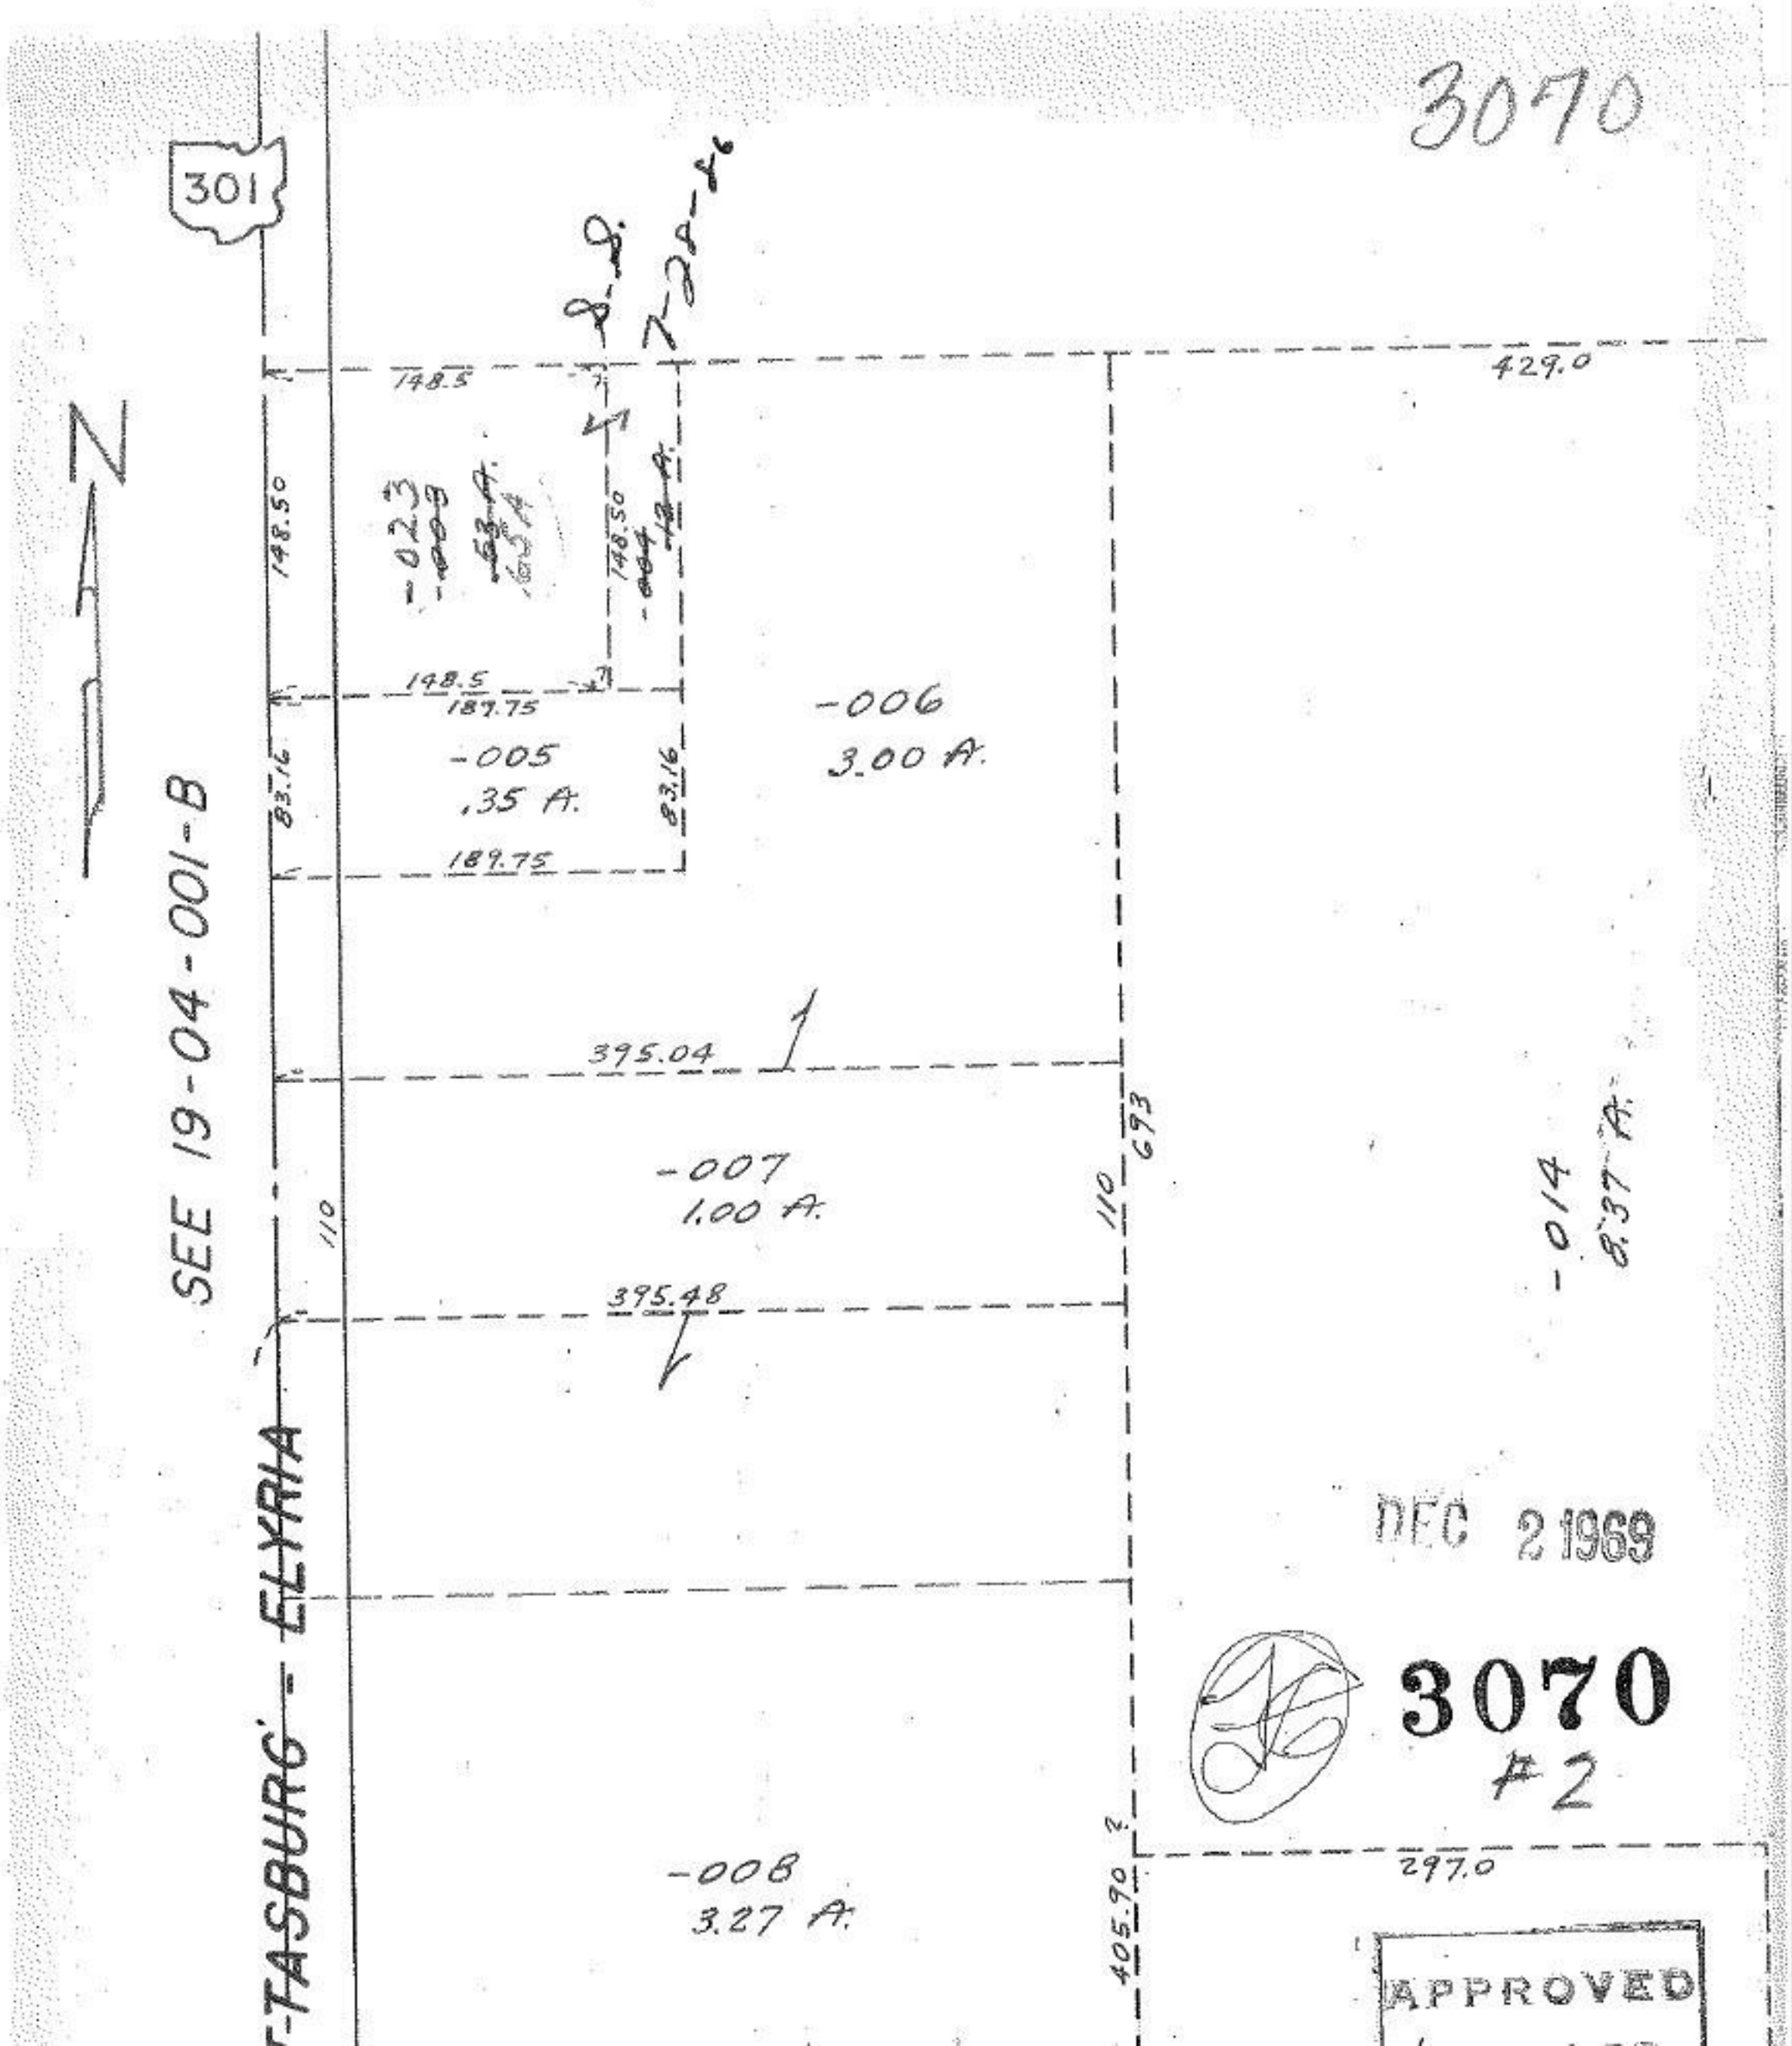
3070
301
N
SEE 19-04-001-B
TASBURG - ELYRIA
148.5
148.50
148.5
187.75
83.16
189.75
-023
-005
.35 A.
-006
3.00 A.
429.0
395.04
-007
1.00 A.
110
693
-014
8.37 A.
395.48
-008
3.27 A.
405.90
297.0
DEC 2 1969
3070
#2
APPROVED