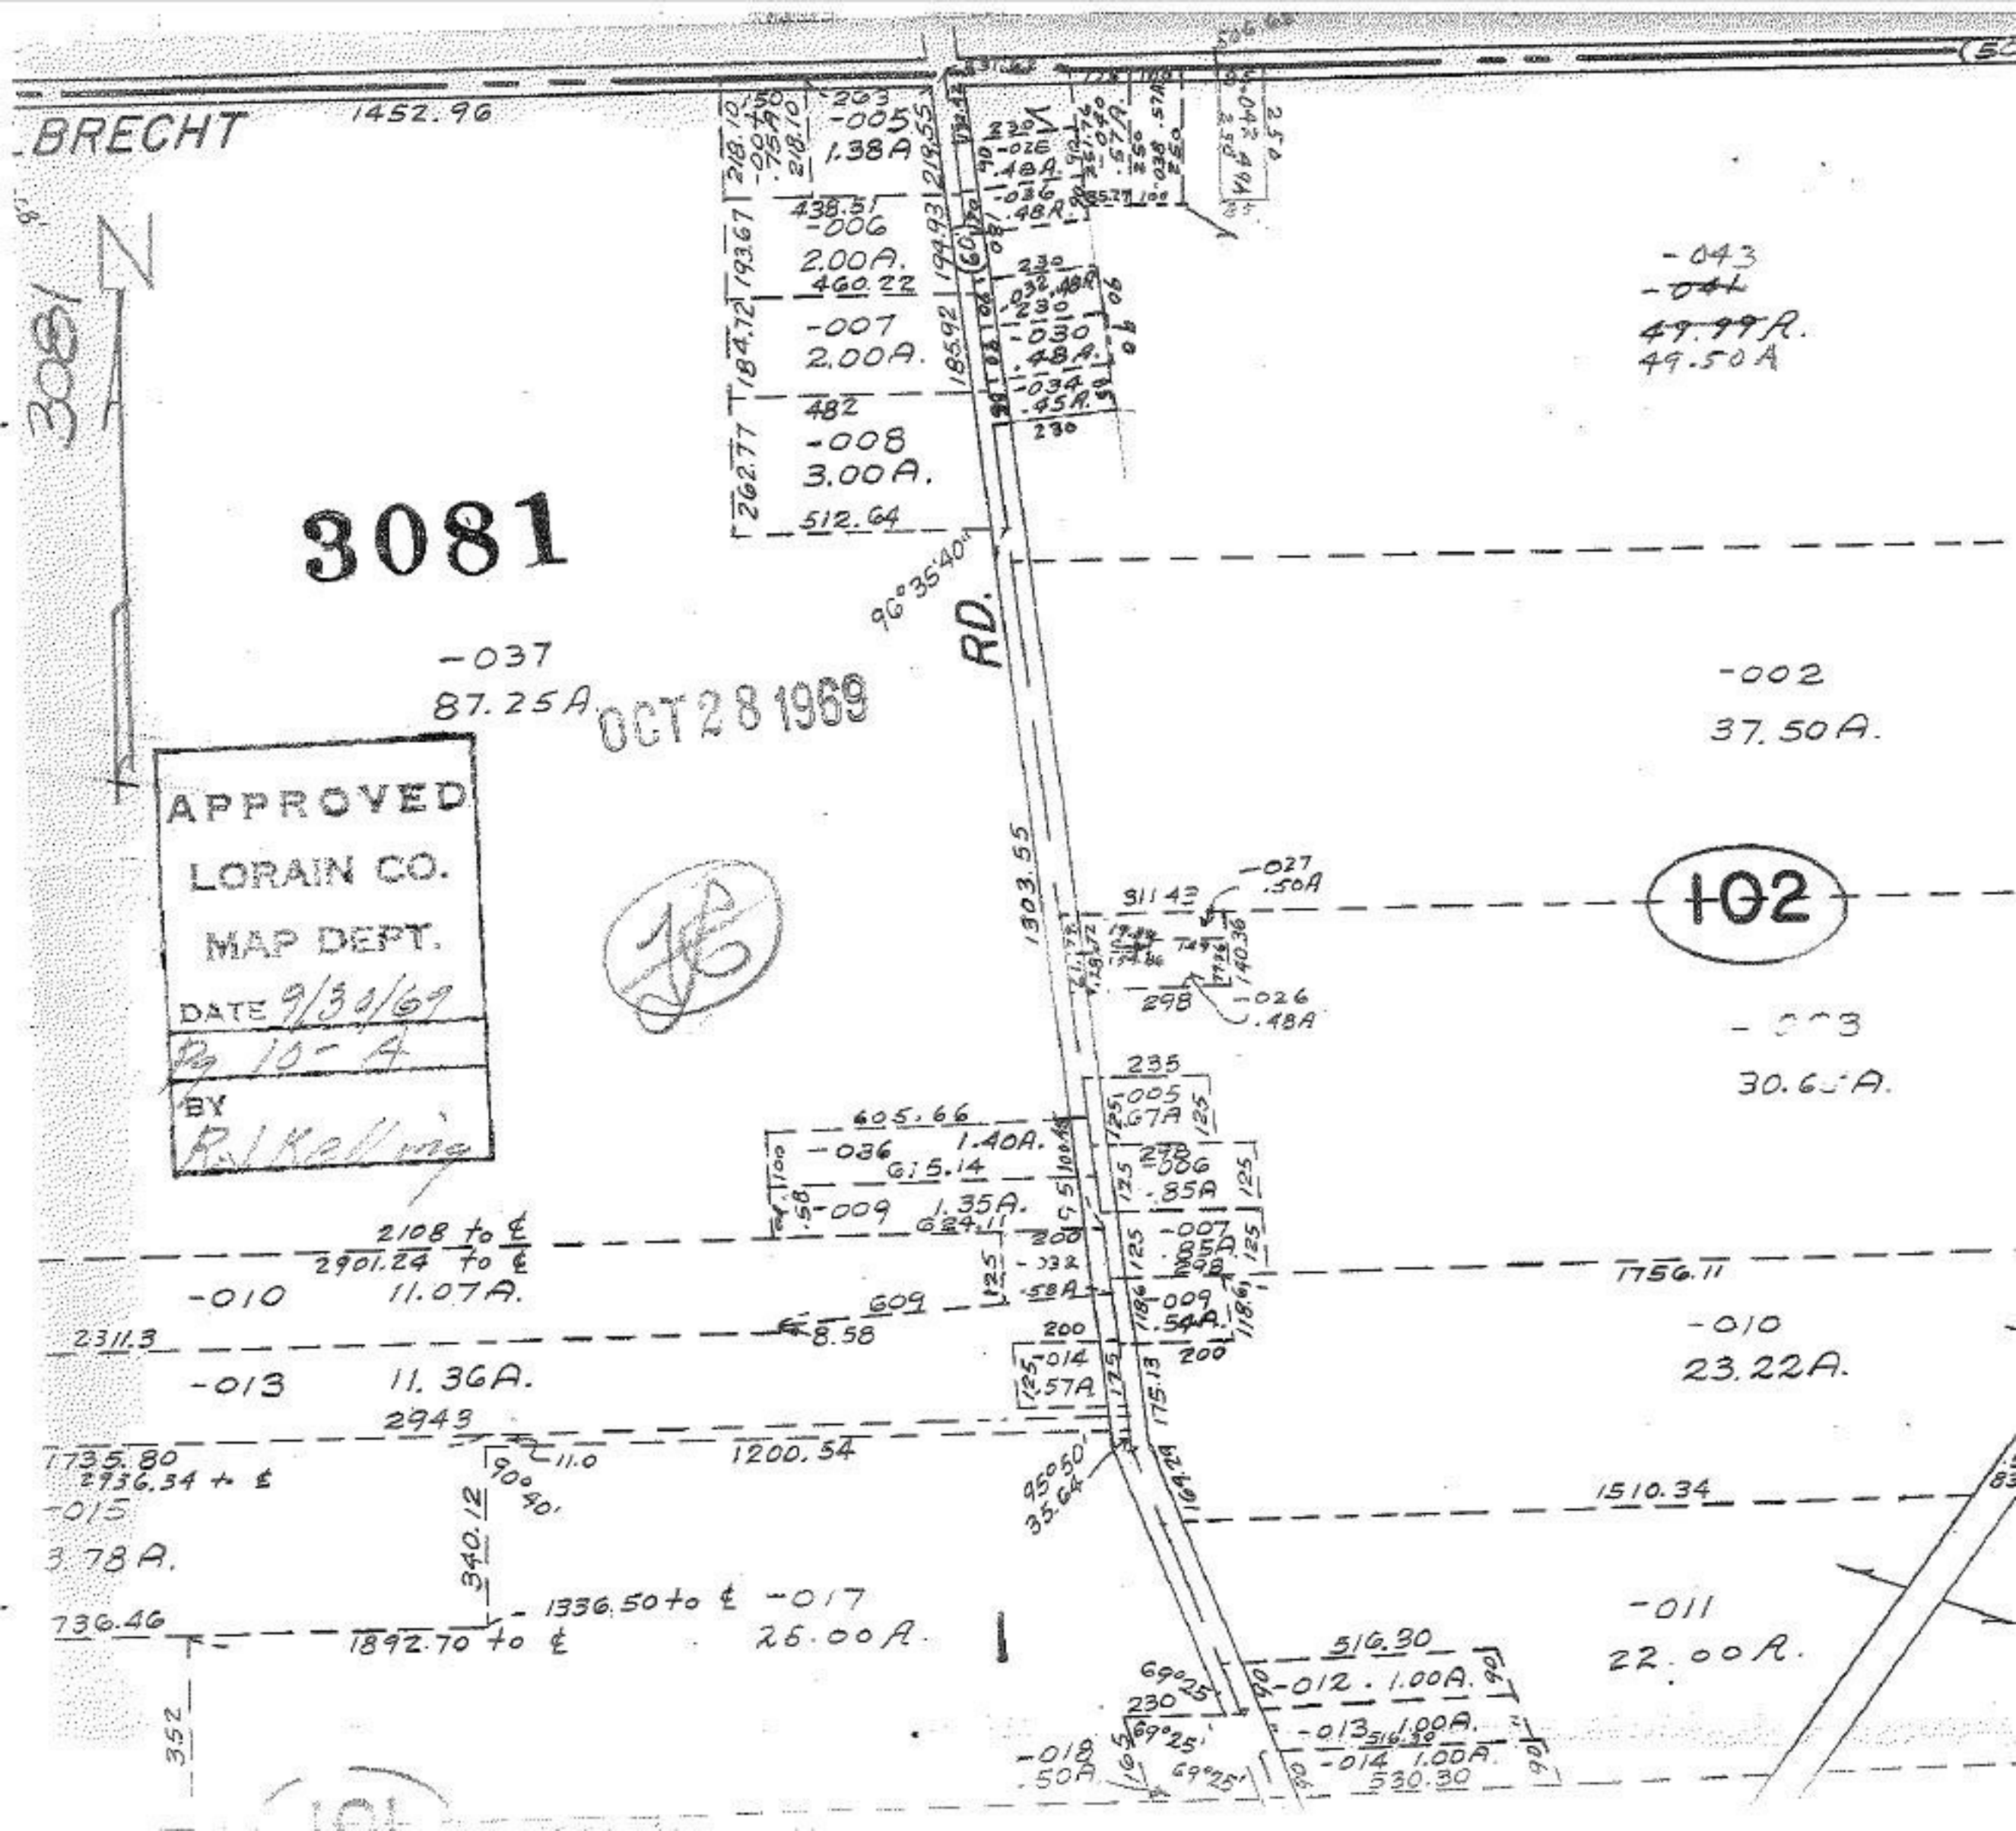

BRECHT
1452.96
3081
N
3081
-005
1.38A
-006
2.00A.
460.22
-007
2.00A.
482
-008
3.00A.
512.64
-037
87.25A.
OCT 28 1969
APPROVED
LORAIN CO.
MAP DEPT.
DATE 9/30/69
Pg 10-A
BY
RJ Kelling
96°35'40"
RD.
-043
49.50A
-002
37.50A.
102
-027
.50A
-026
.48A
-003
30.65A.
-005
.67A
-036
1.40A.
-009
1.35A.
-007
.85A
-009
.54A
-014
.57A
2108 to ℄
2901.24 to ℄
-010
11.07A.
2311.3
-013
11.36A.
2943
1735.80
2936.34 to ℄
-015
3.78A.
1200.54
1756.11
-010
23.22A.
1510.34
-011
22.00A.
1336.50 to ℄
-017
25.00A.
1892.70 to ℄
736.46
516.30
-012
1.00A.
-013
1.00A.
-014
1.00A.
530.30
-018
.50A
69°25'
95°50'
35.64