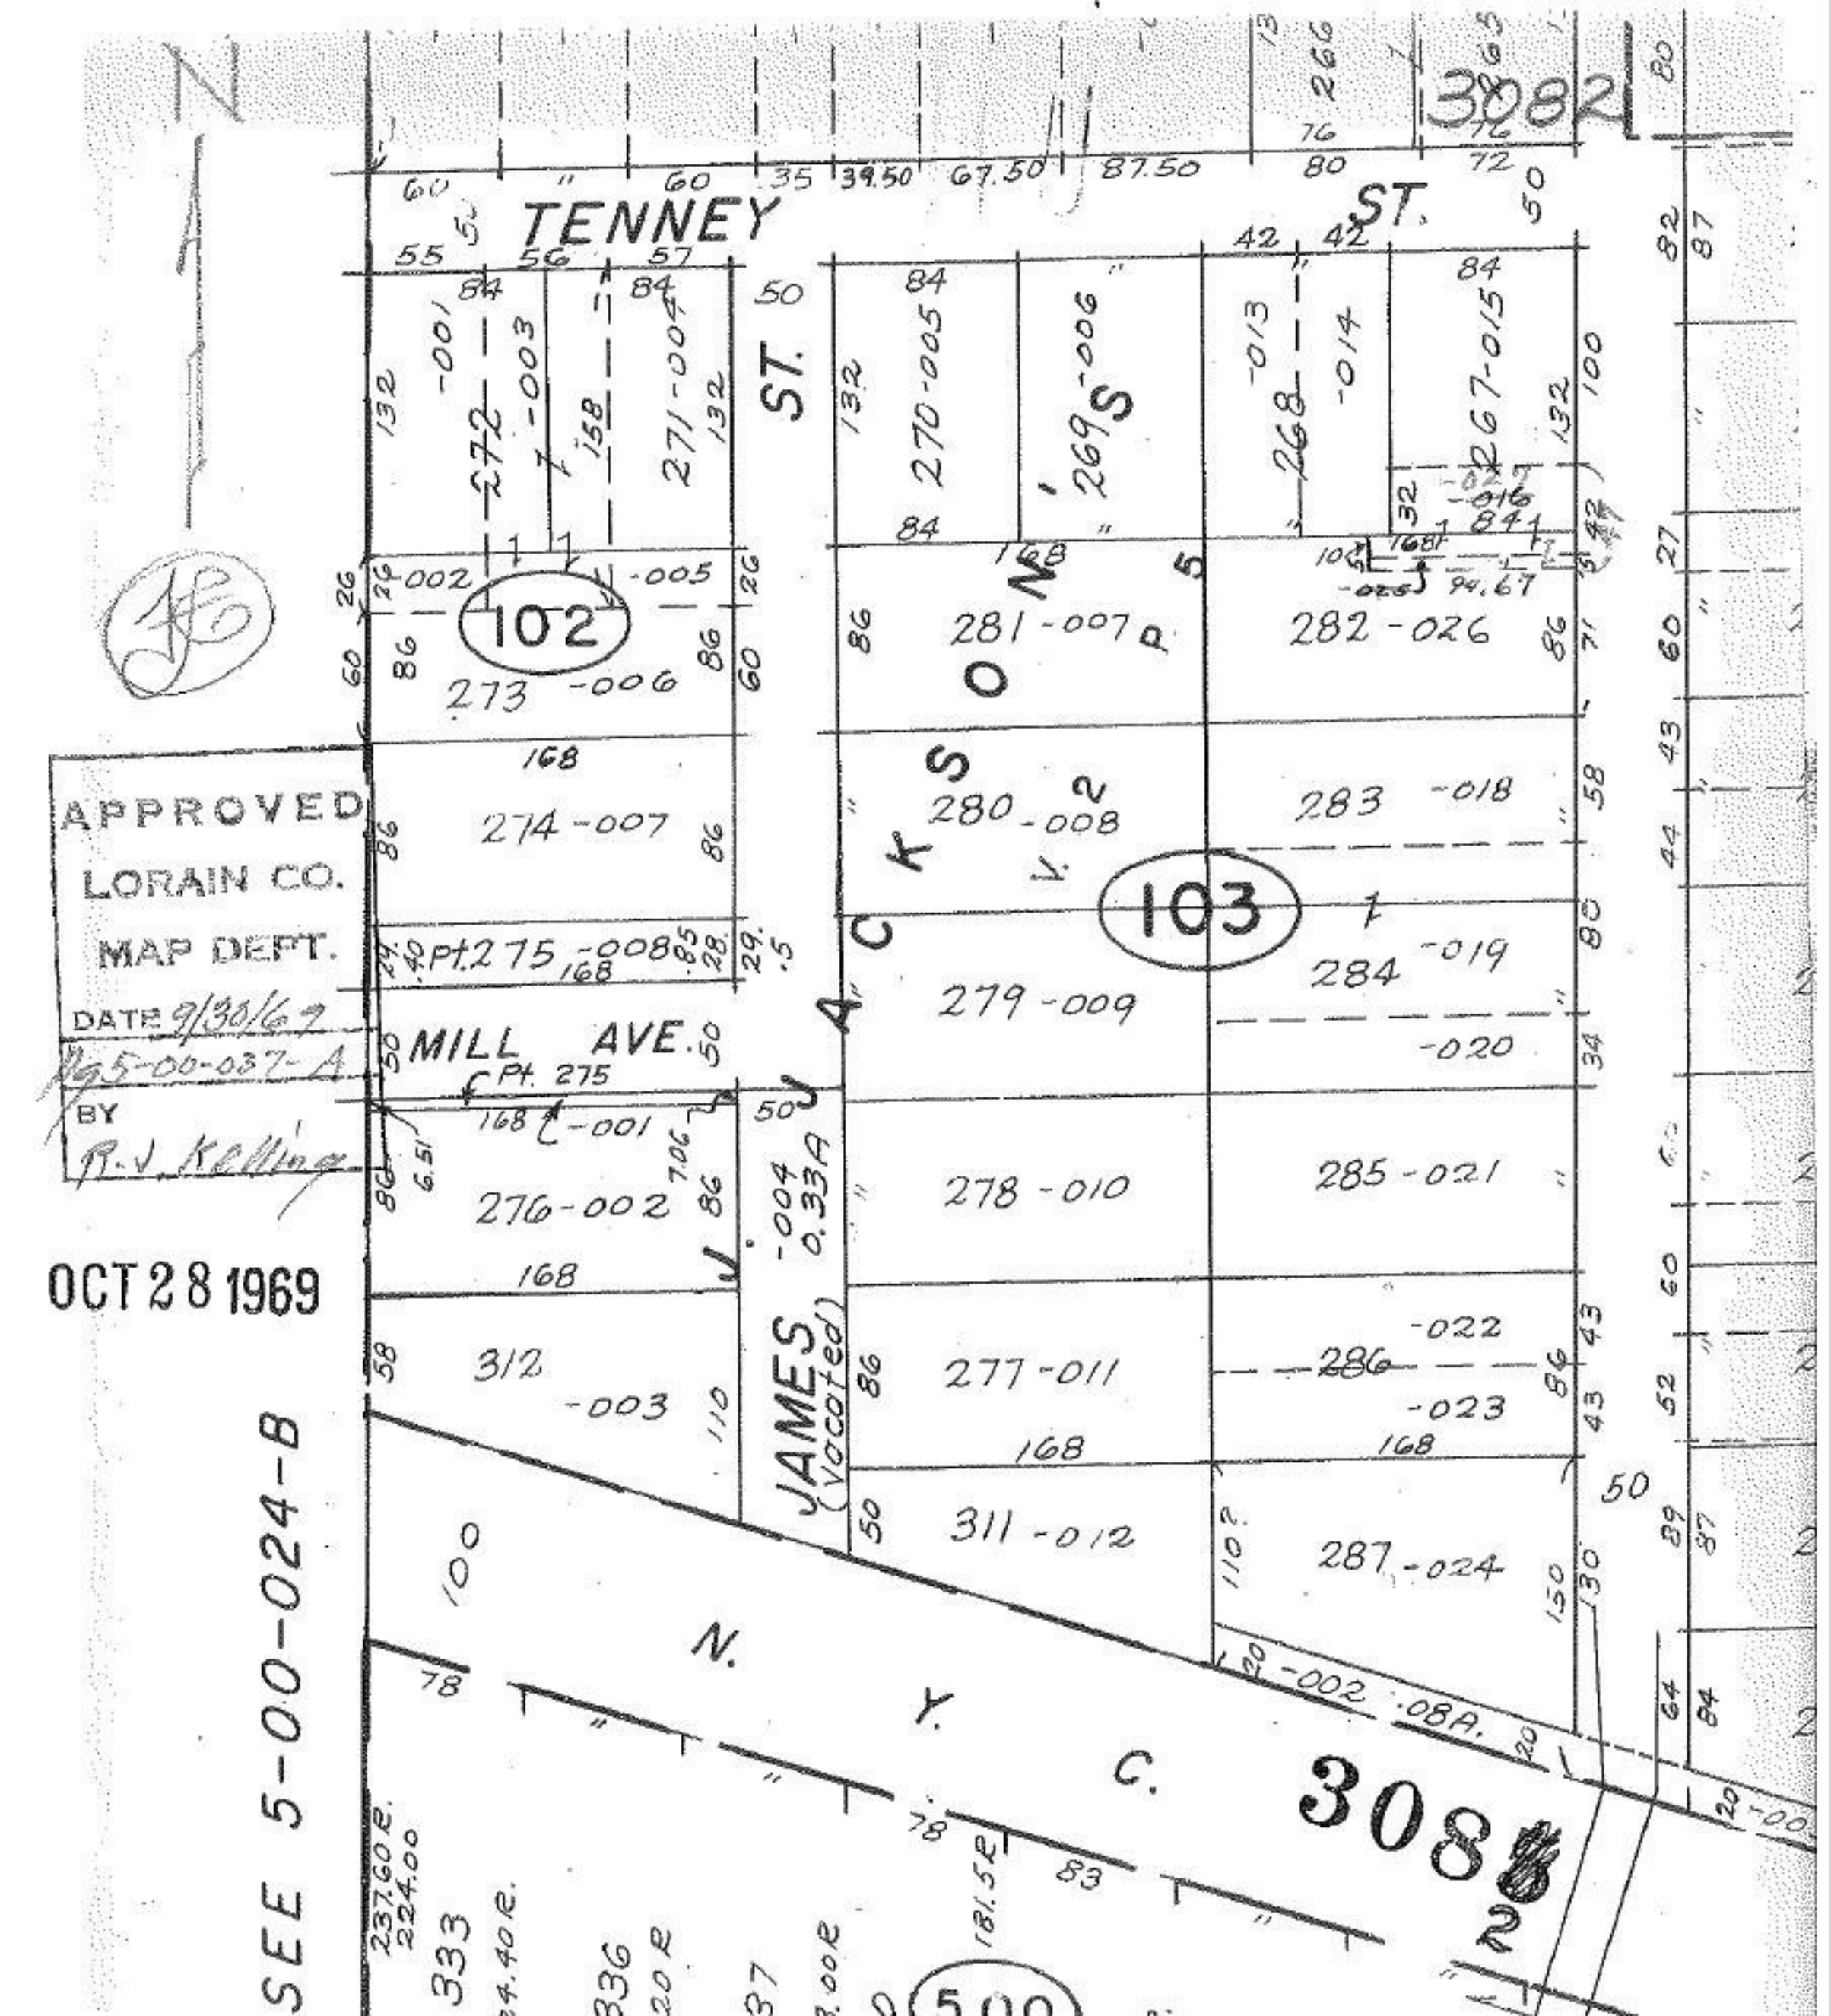

N
TENNEY ST.
MILL AVE.
JAMES (Vacated)
JACKSON
N. Y. C.
102
103
3082
3082
SEE 5-00-024-B
APPROVED
LORAIN CO.
MAP DEPT.
DATE 9/30/69
Pg 5-00-037-A
BY
R.J. Kelling
OCT 28 1969