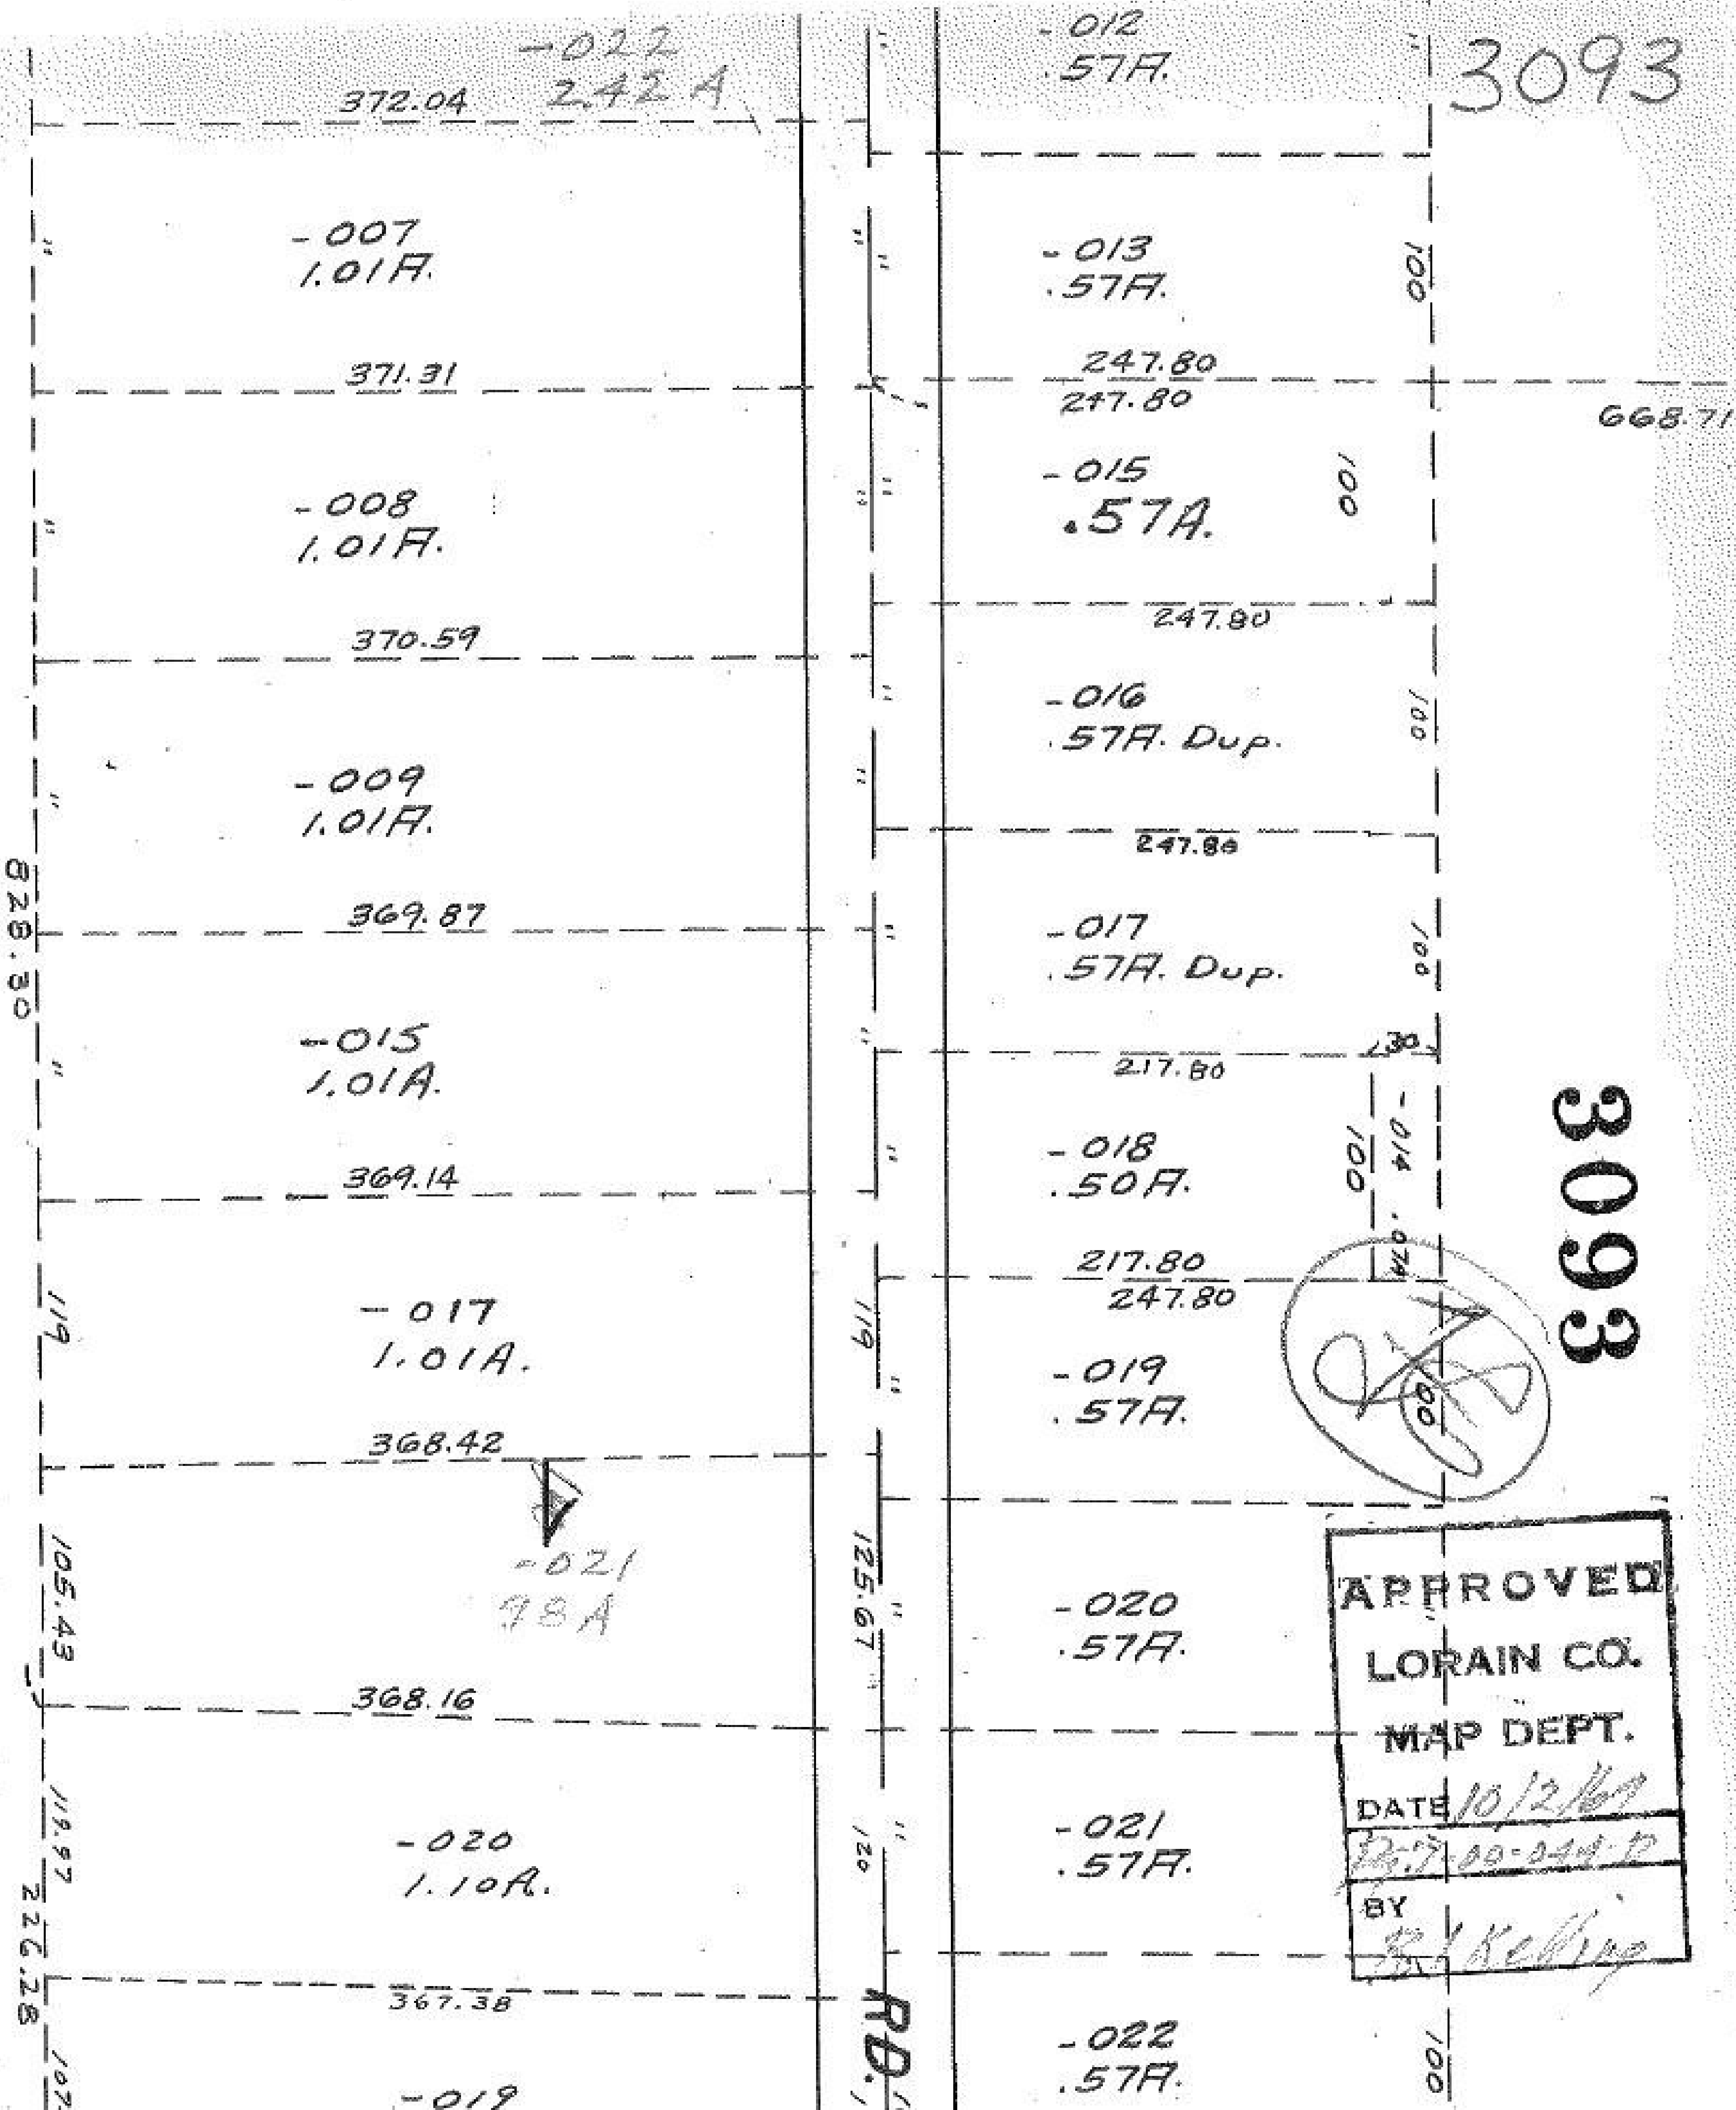
3093
-022
2.42 A
372.04
-012
.57A.
-007
1.01A.
-013
.57A.
371.31
247.80
247.80
668.71
-008
1.01A.
-015
.57A.
370.59
247.80
-016
.57A. Dup.
-009
1.01A.
828.30
369.87
247.80
-017
.57A. Dup.
-015
1.01A.
217.80
-018
.50A.
-014
369.14
217.80
247.80
-017
1.01A.
-019
.57A.
368.42
-021
.78A
105.43
125.67
-020
.57A.
368.16
APPROVED
LORAIN CO.
MAP DEPT.
DATE 10/2/
BY
-020
1.10A.
-021
.57A.
226.28
367.38
RD.
-022
.57A.
-019
100
119
120
3093