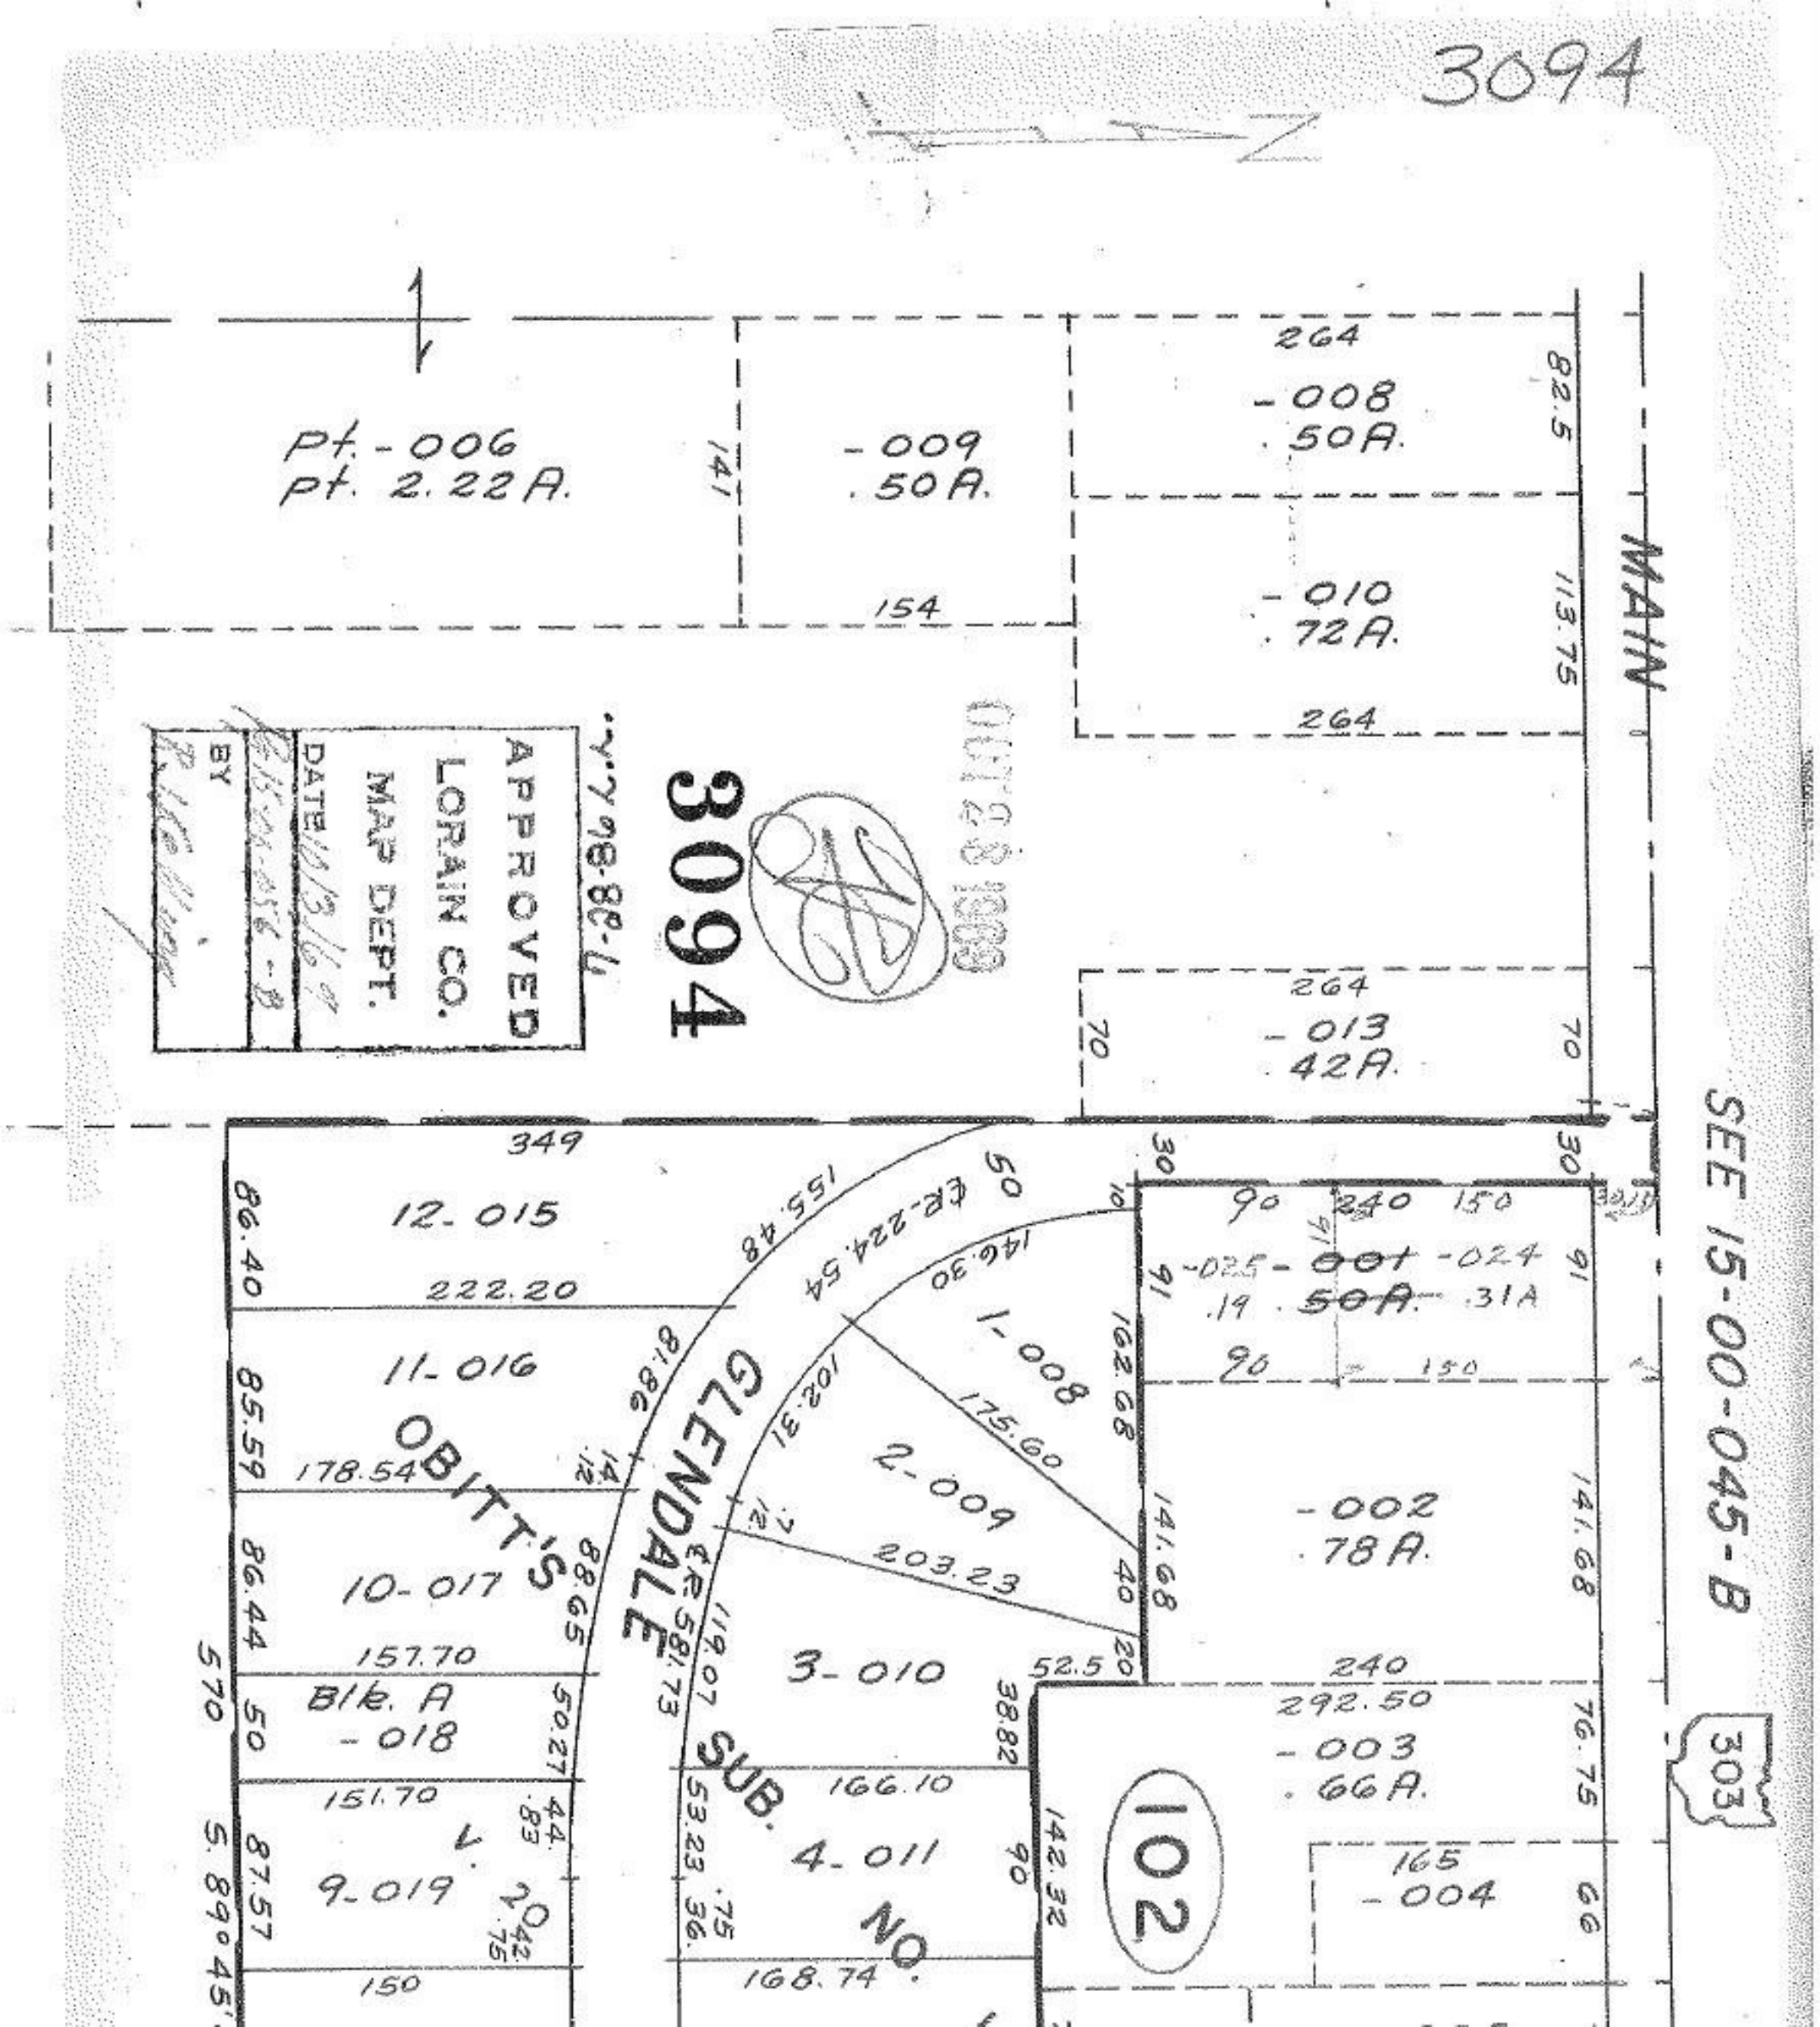
3094
Pt.-006
Pt. 2.22A.
-009
.50A.
264
-008
.50A.
-010
.72A.
264
MAIN
82.5
113.75
154
141
264
-013
.42A.
70
70
SEE 15-00-045-B
303
349
12-015
222.20
11-016
178.54
10-017
157.70
Blk. A
-018
151.70
9-019
150
86.40
85.59
86.44
570
87.57
S. 89°45'
155.48
50
℄R-224.54
146.30
1-008
175.60
2-009
203.23
3-010
166.10
4-011
168.74
GLENDALE
SUB.
NO.
102
90
240
150
-025
-001
-024
.19
.50A.
.31A
90
150
-002
.78A.
240
292.50
-003
.66A.
165
-004
142.32
162.68
141.68
141.68
76.75
66
30
30
10
91
91
40
20
52.5
38.82
90
53.23
36.75
119.07
88.65
50.27
44.83
42.75
81.86
14.12
7.12
102.31
.75
.12
℄R-581.73
S.R. 20
OBITT'S
APPROVED
LORAIN CO.
MAP DEPT.
DATE 10/3/69
BY
OUT 28 1969
3094