3096 & 3097

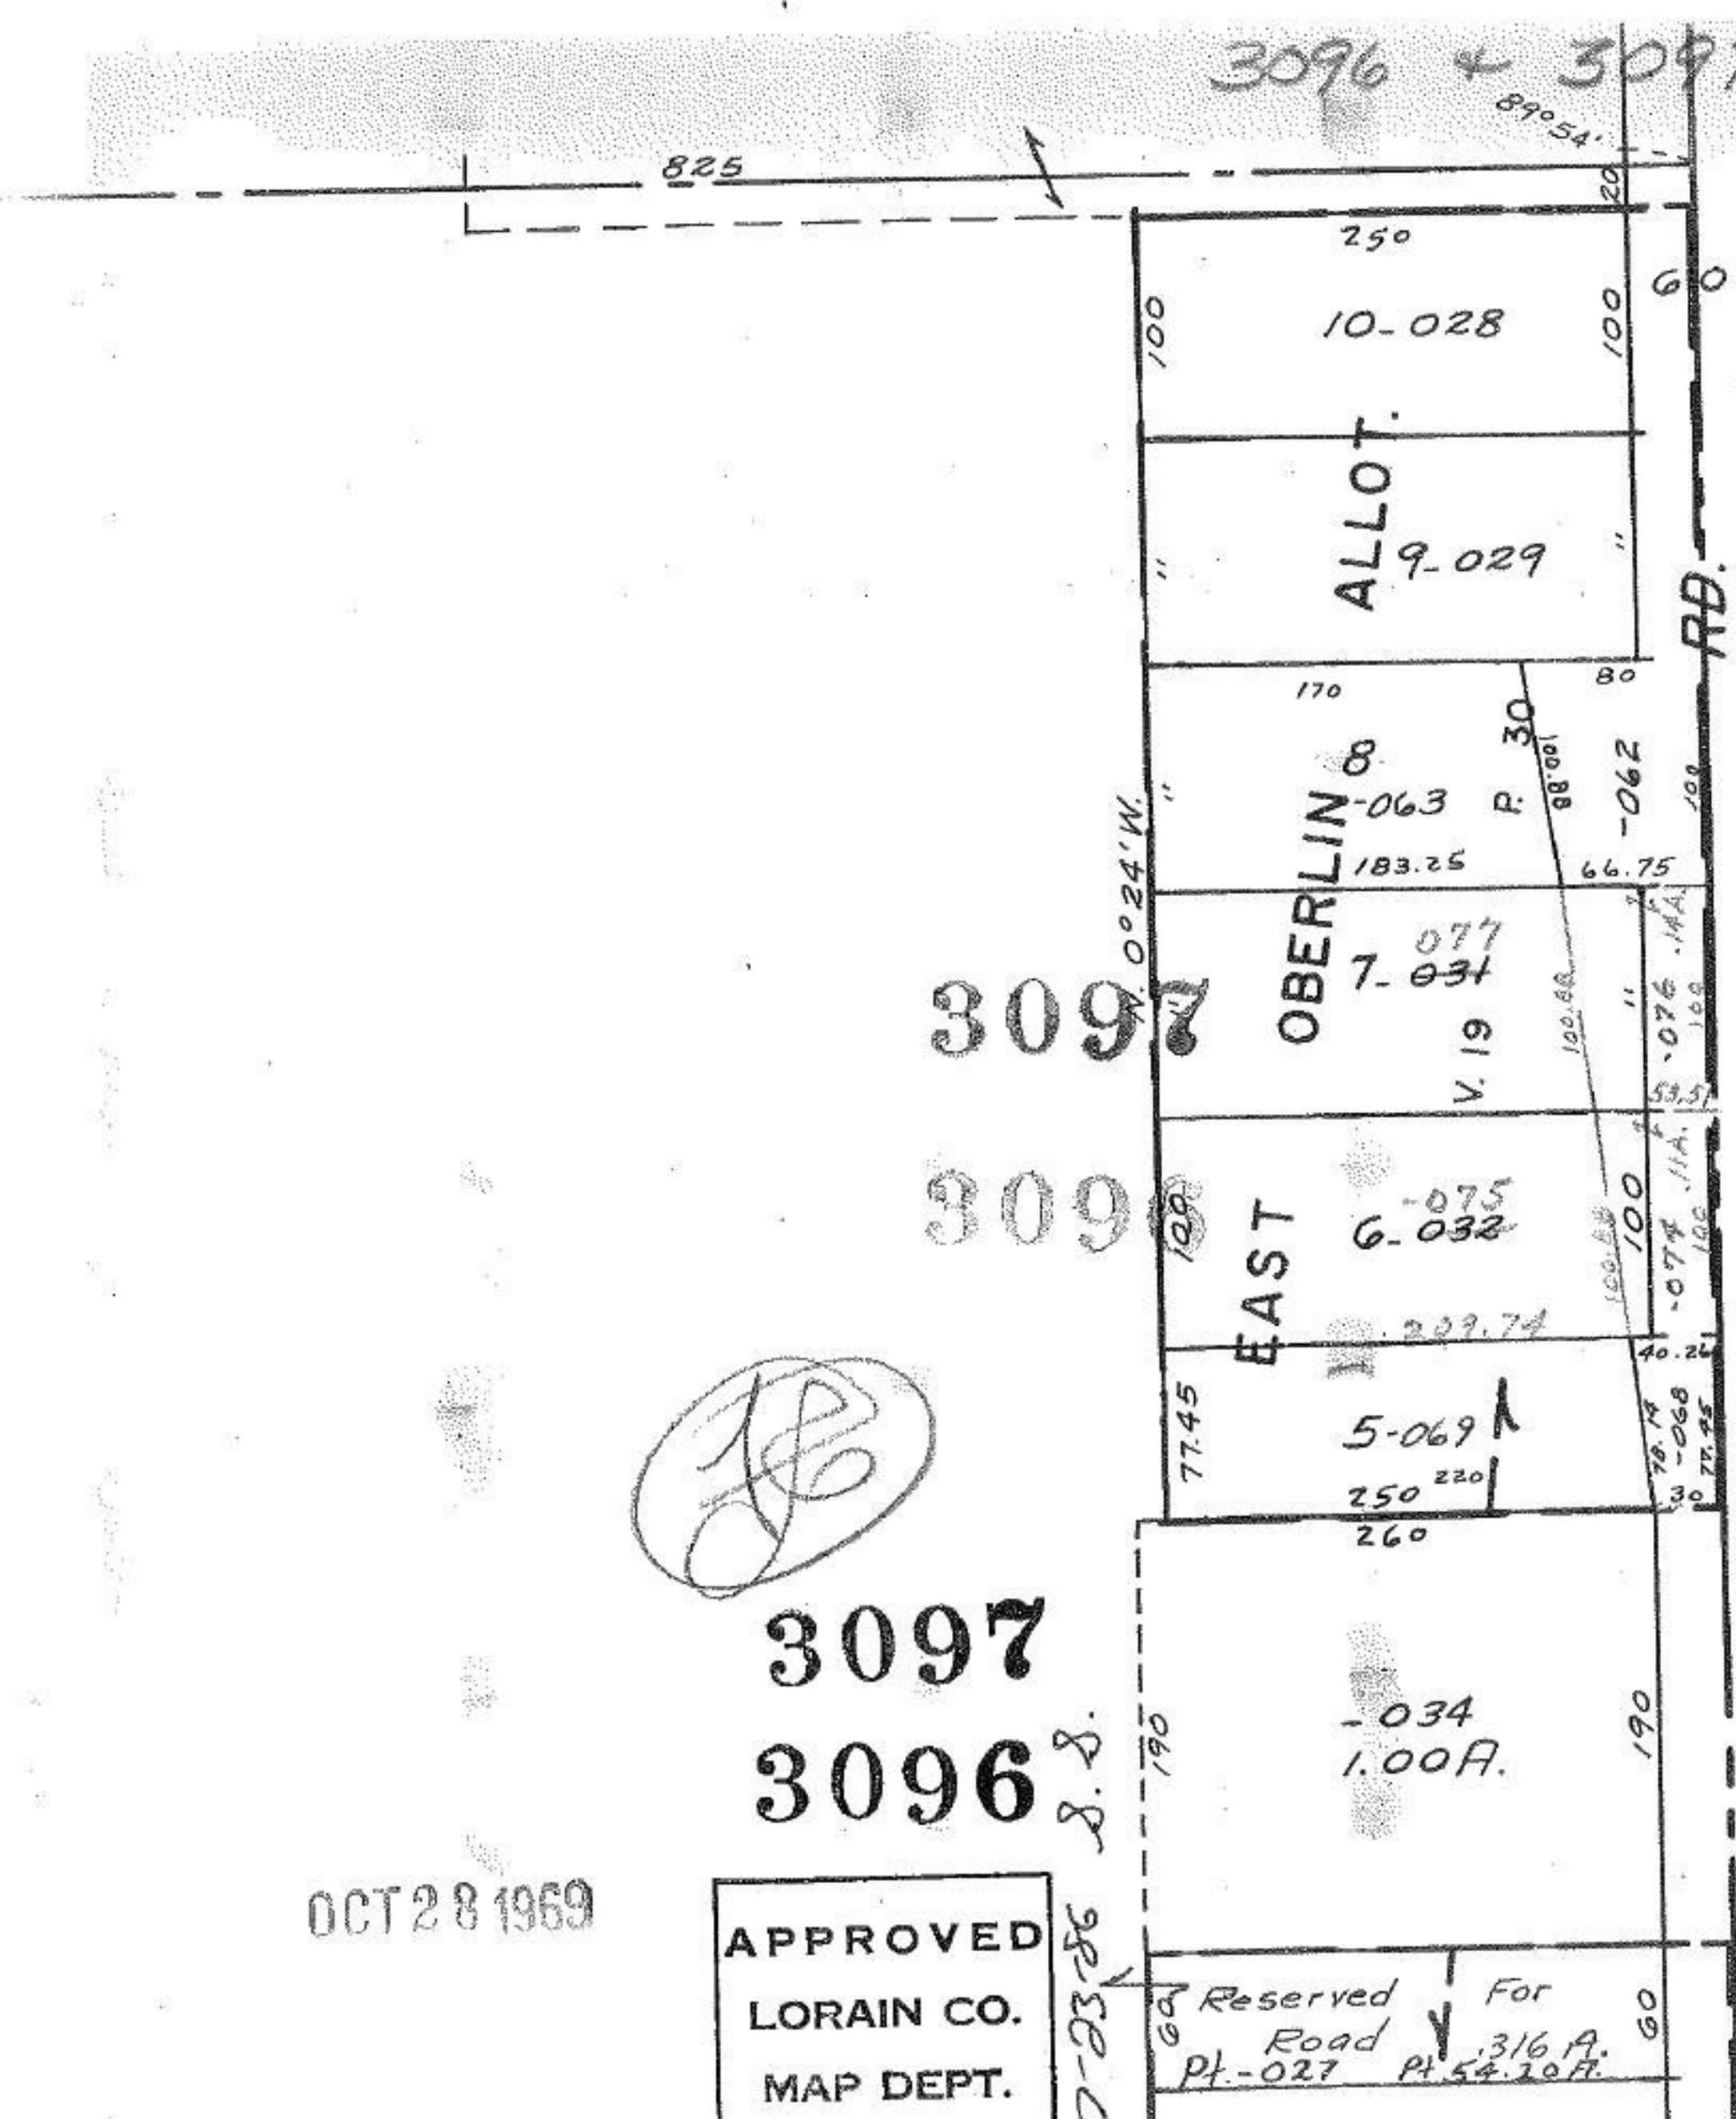

OCT 28 1969

APPROVED
LORAIN CO.
MAP DEPT.