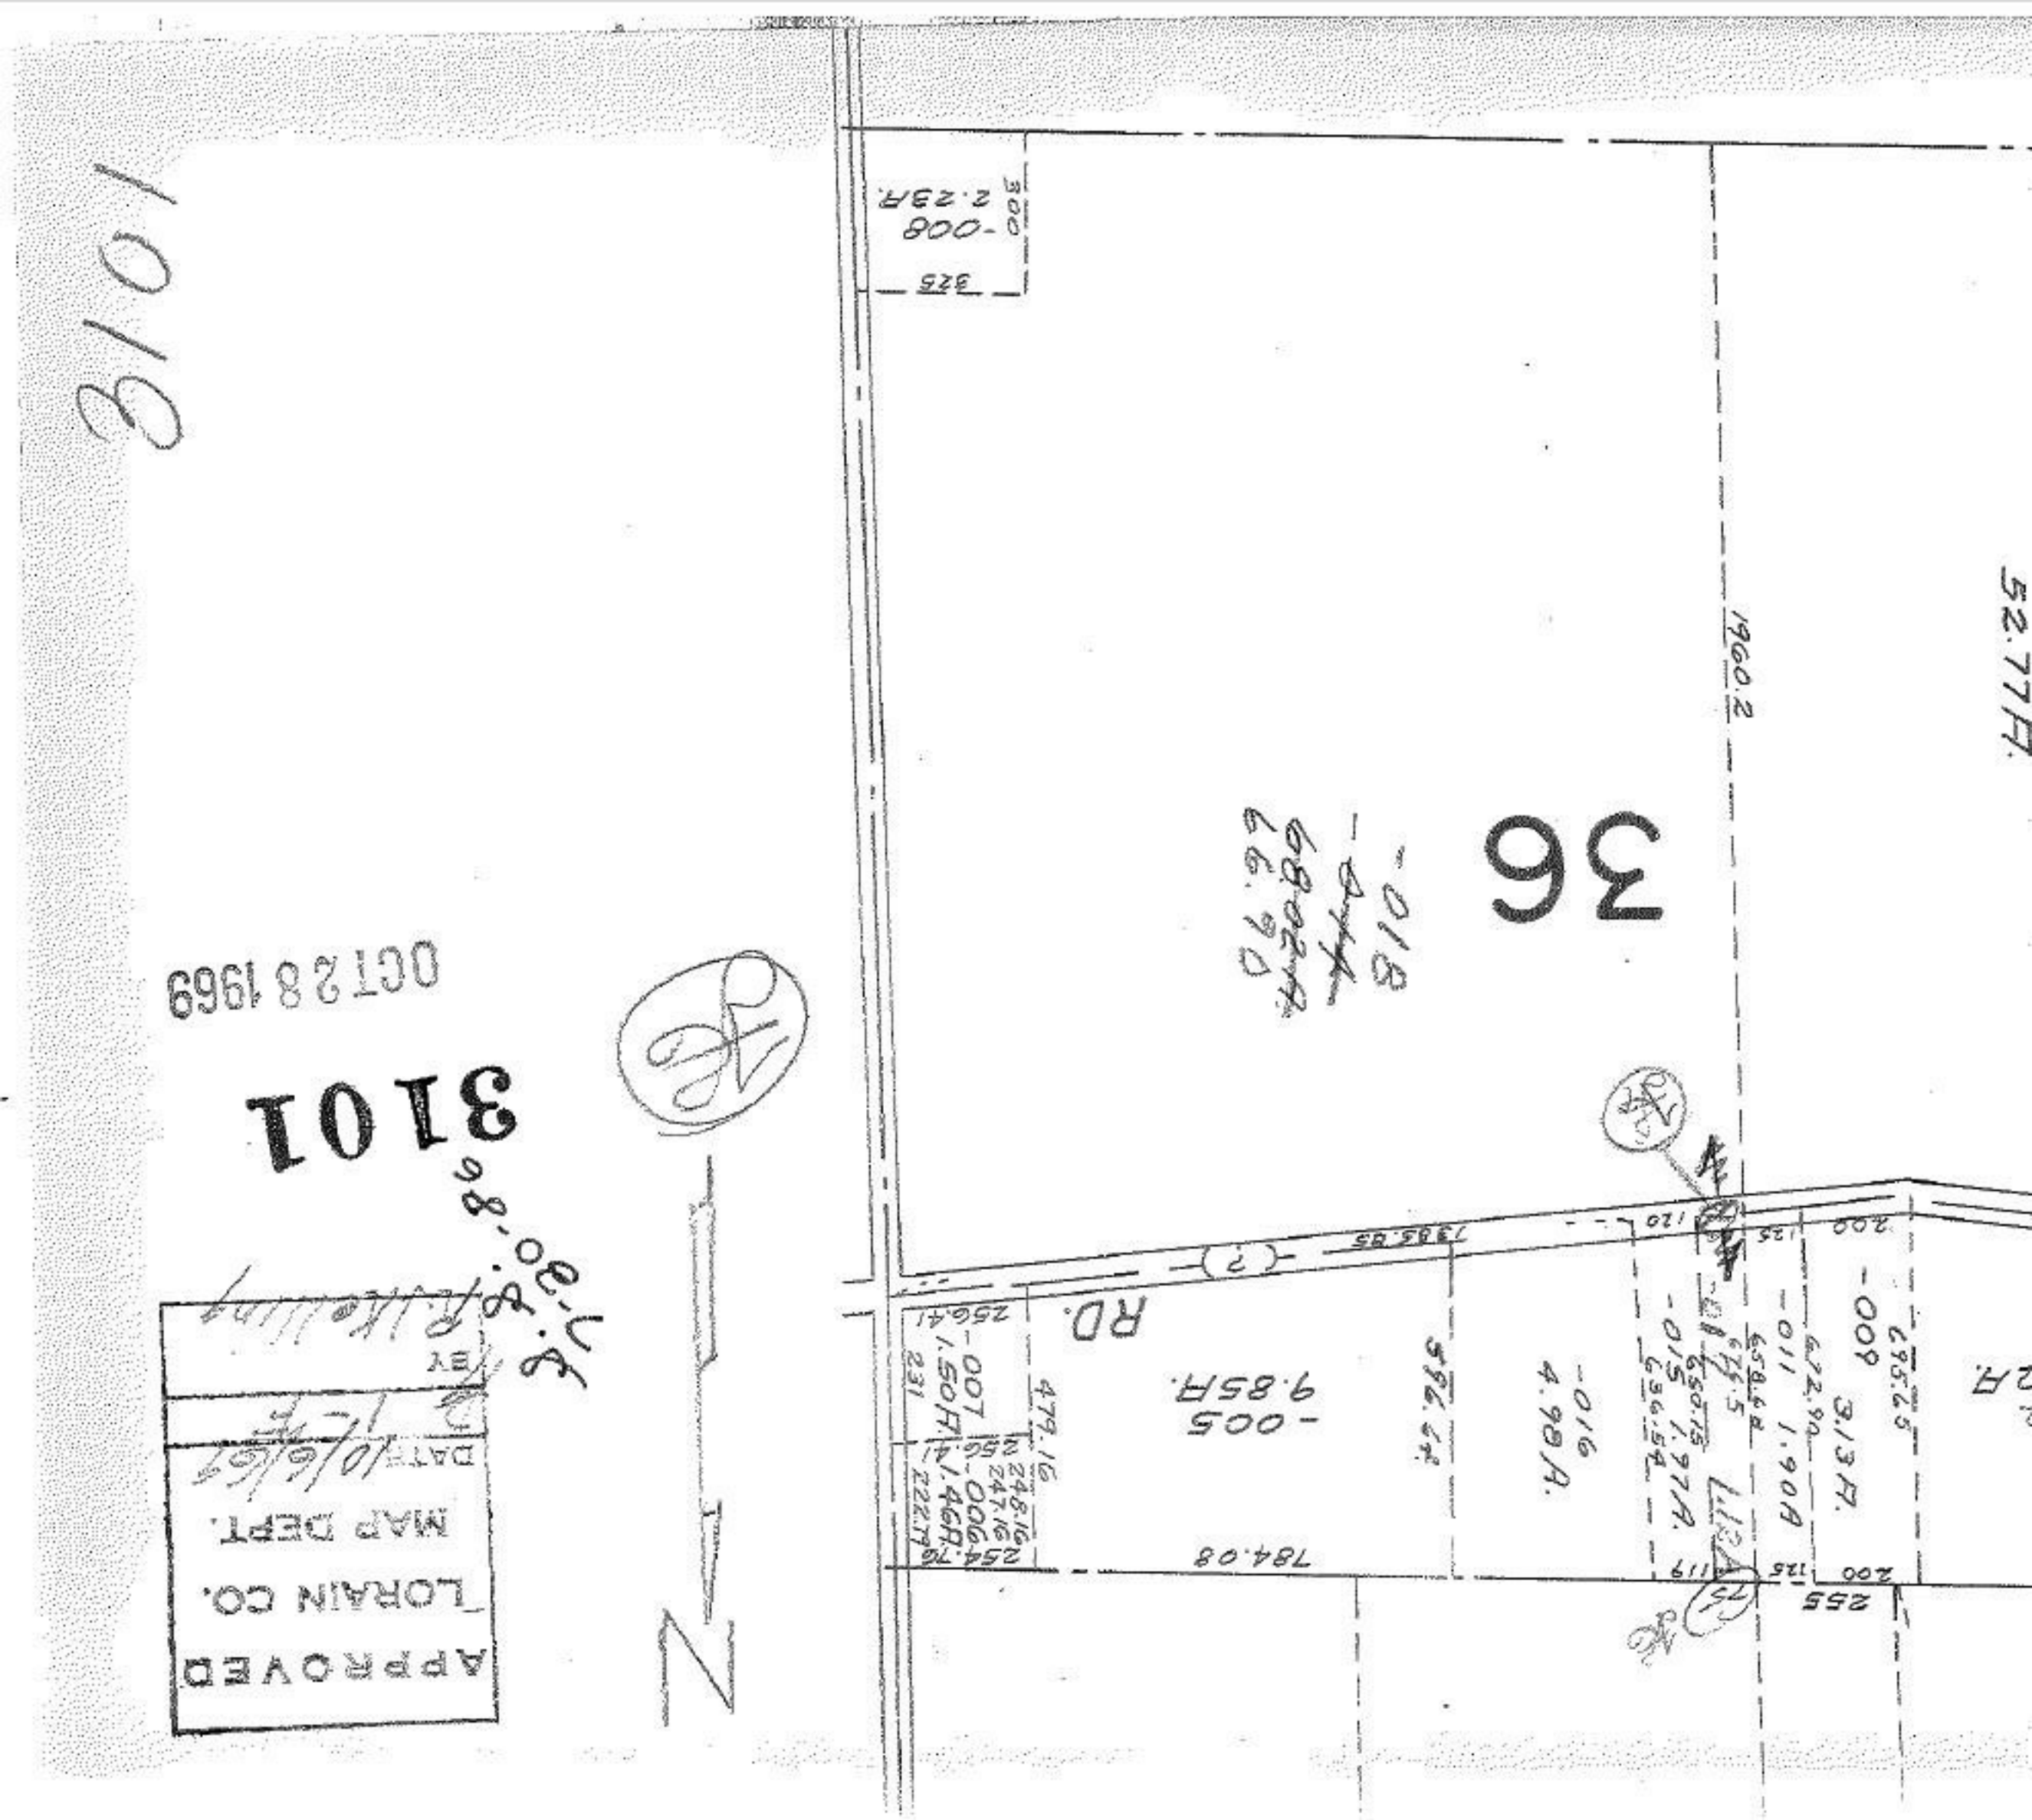

3101
OCT 28 1969
APPROVED
LORAIN CO.
MAP DEPT.
DATE 10/6/69
BY
36
RD.
-005
9.85A.
-016
4.98A.
-009
3.13A.
-011
1.90A
-015
1.97A.
-007
1.50A.
-006
1.46A.
-008
2.23A.
52.77A.
1960.2
784.08
1385.85