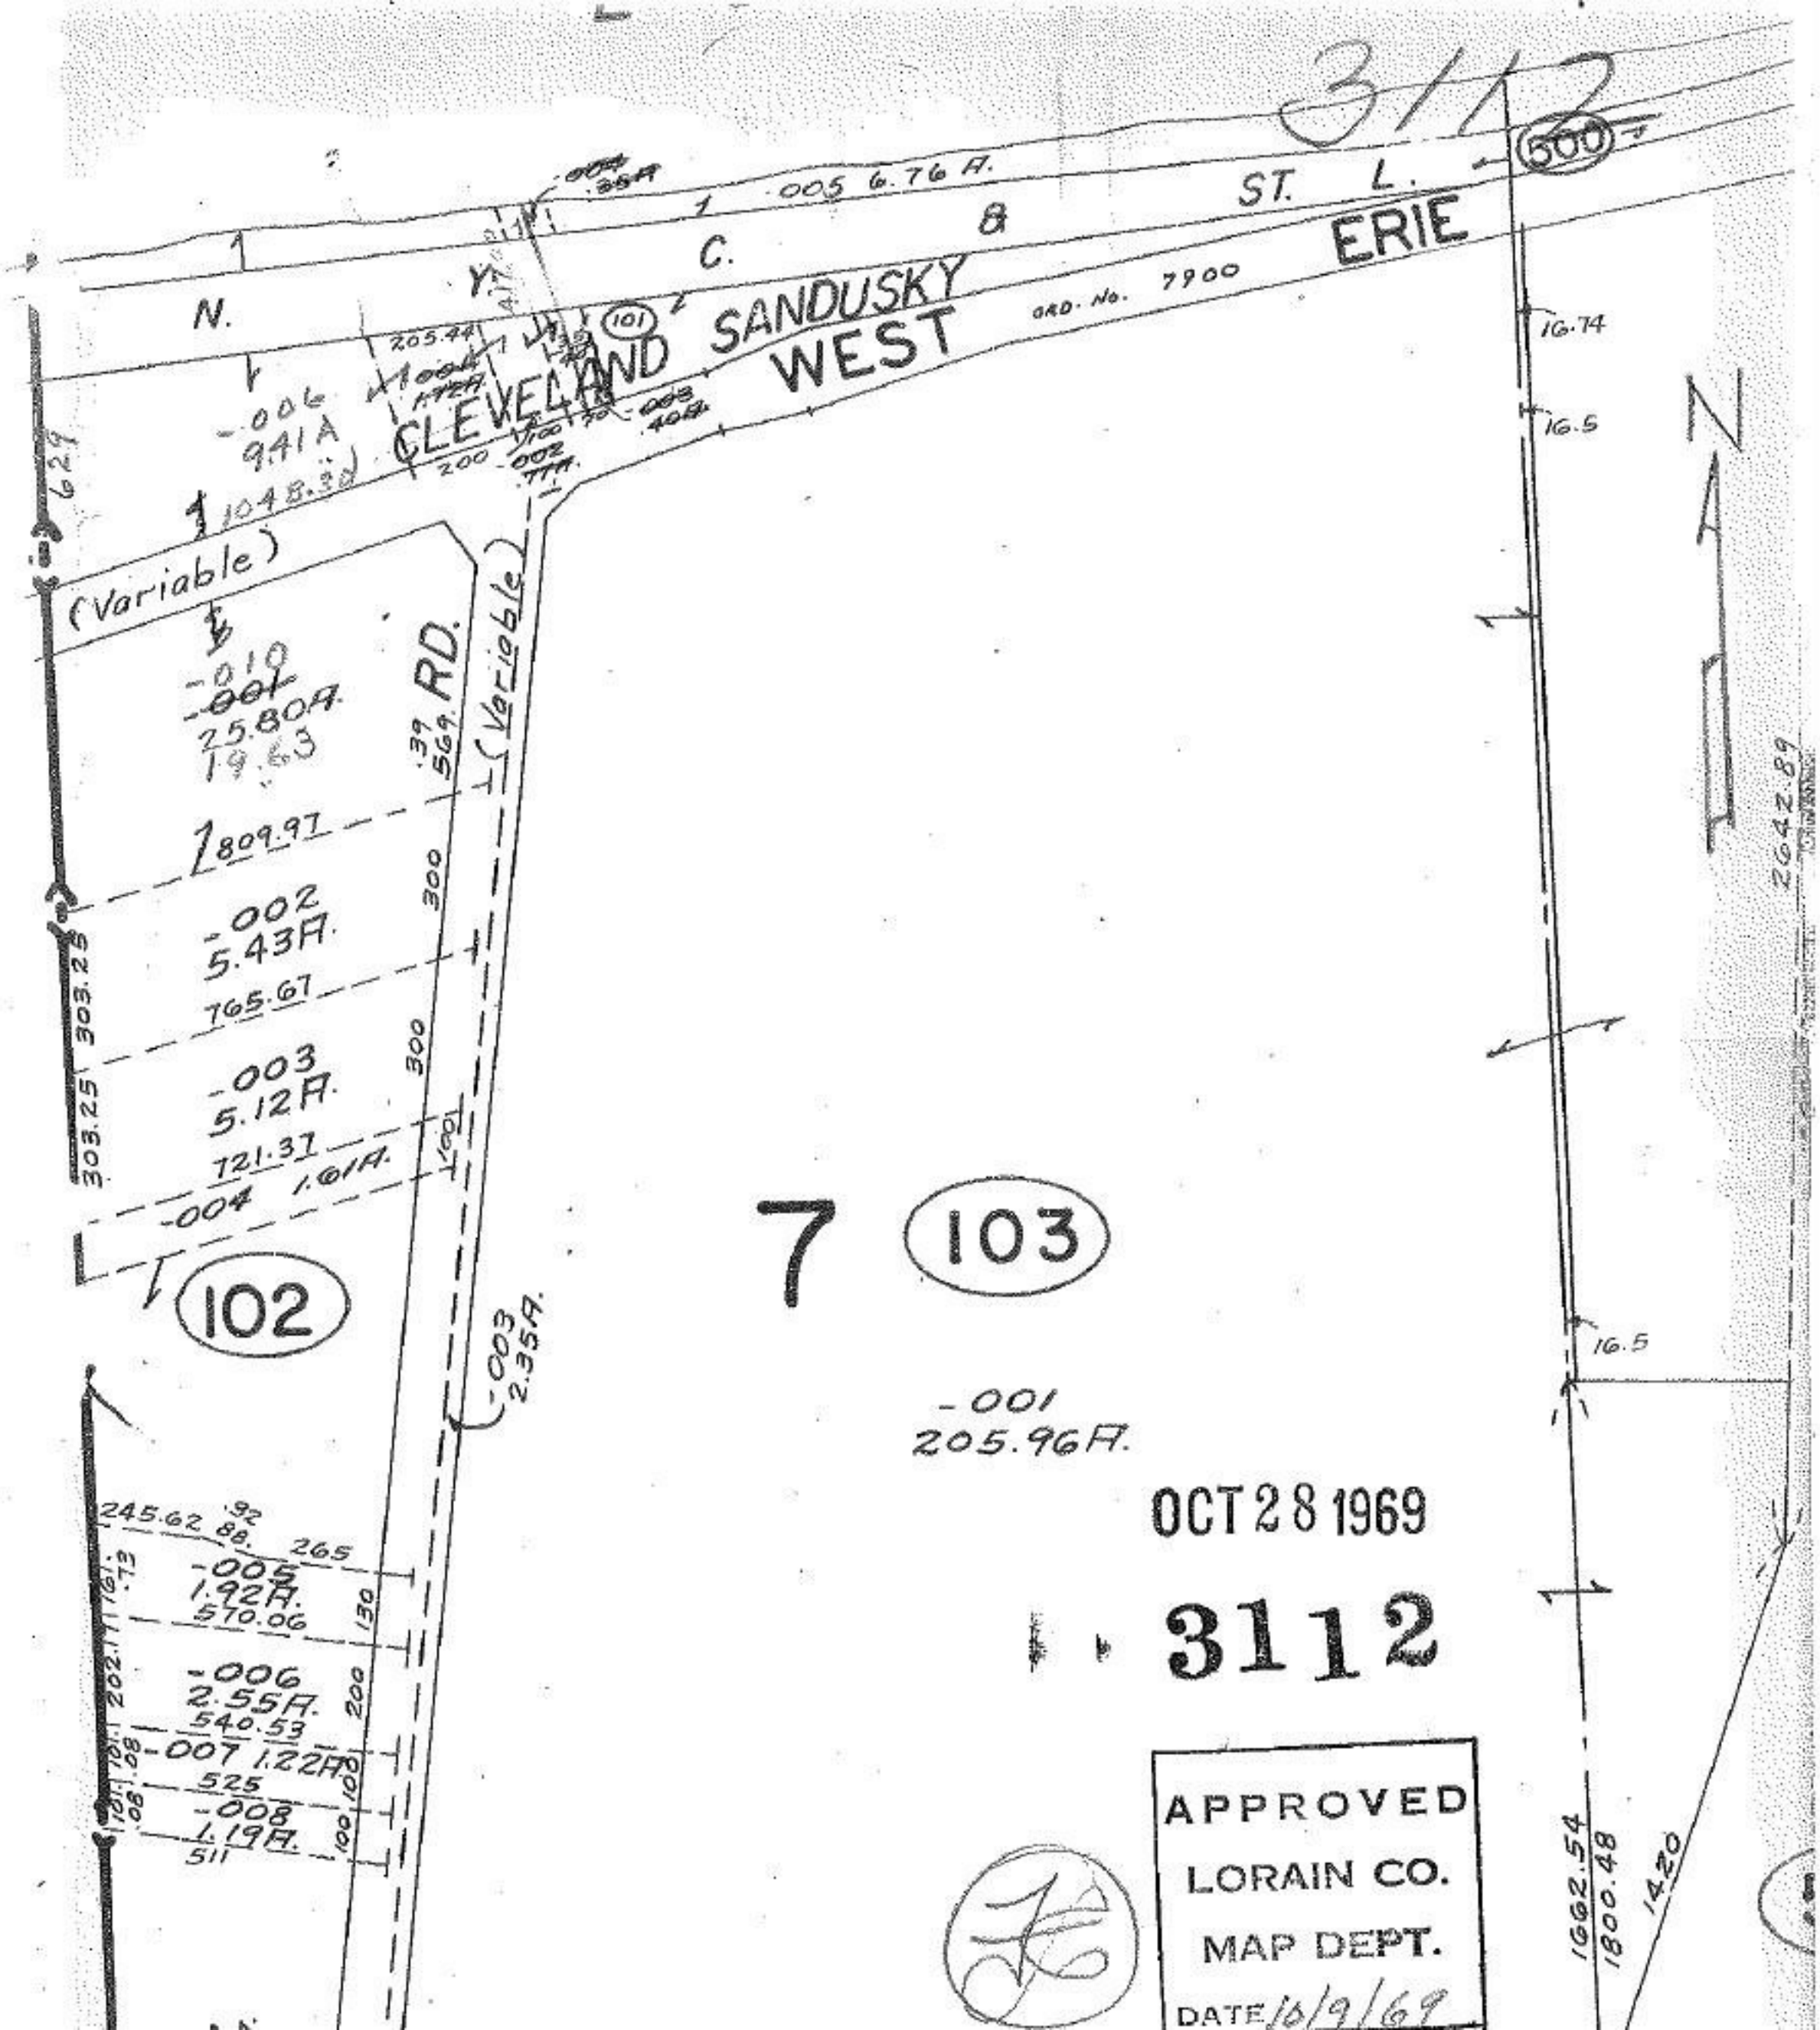
3112
N. Y. C. & ST. L.
ERIE
CLEVELAND SANDUSKY WEST
ORD. No. 7900
500
101
-006
9.41A
1048.30
(Variable)
-010
25.80A
19.63
809.97
-002
5.43A
765.67
-003
5.12A
721.37
-004 1.61A
102
-003
2.35A
RD.
(Variable)
7
103
-001
205.96A
245.62
-005
1.92A
570.06
-006
2.55A
540.53
-007 1.22A
525
-008
1.19A
511
16.74
16.5
16.5
N
2642.89
1662.54
1800.48
1420
OCT 28 1969
3112
APPROVED
LORAIN CO.
MAP DEPT.
DATE 10/9/69