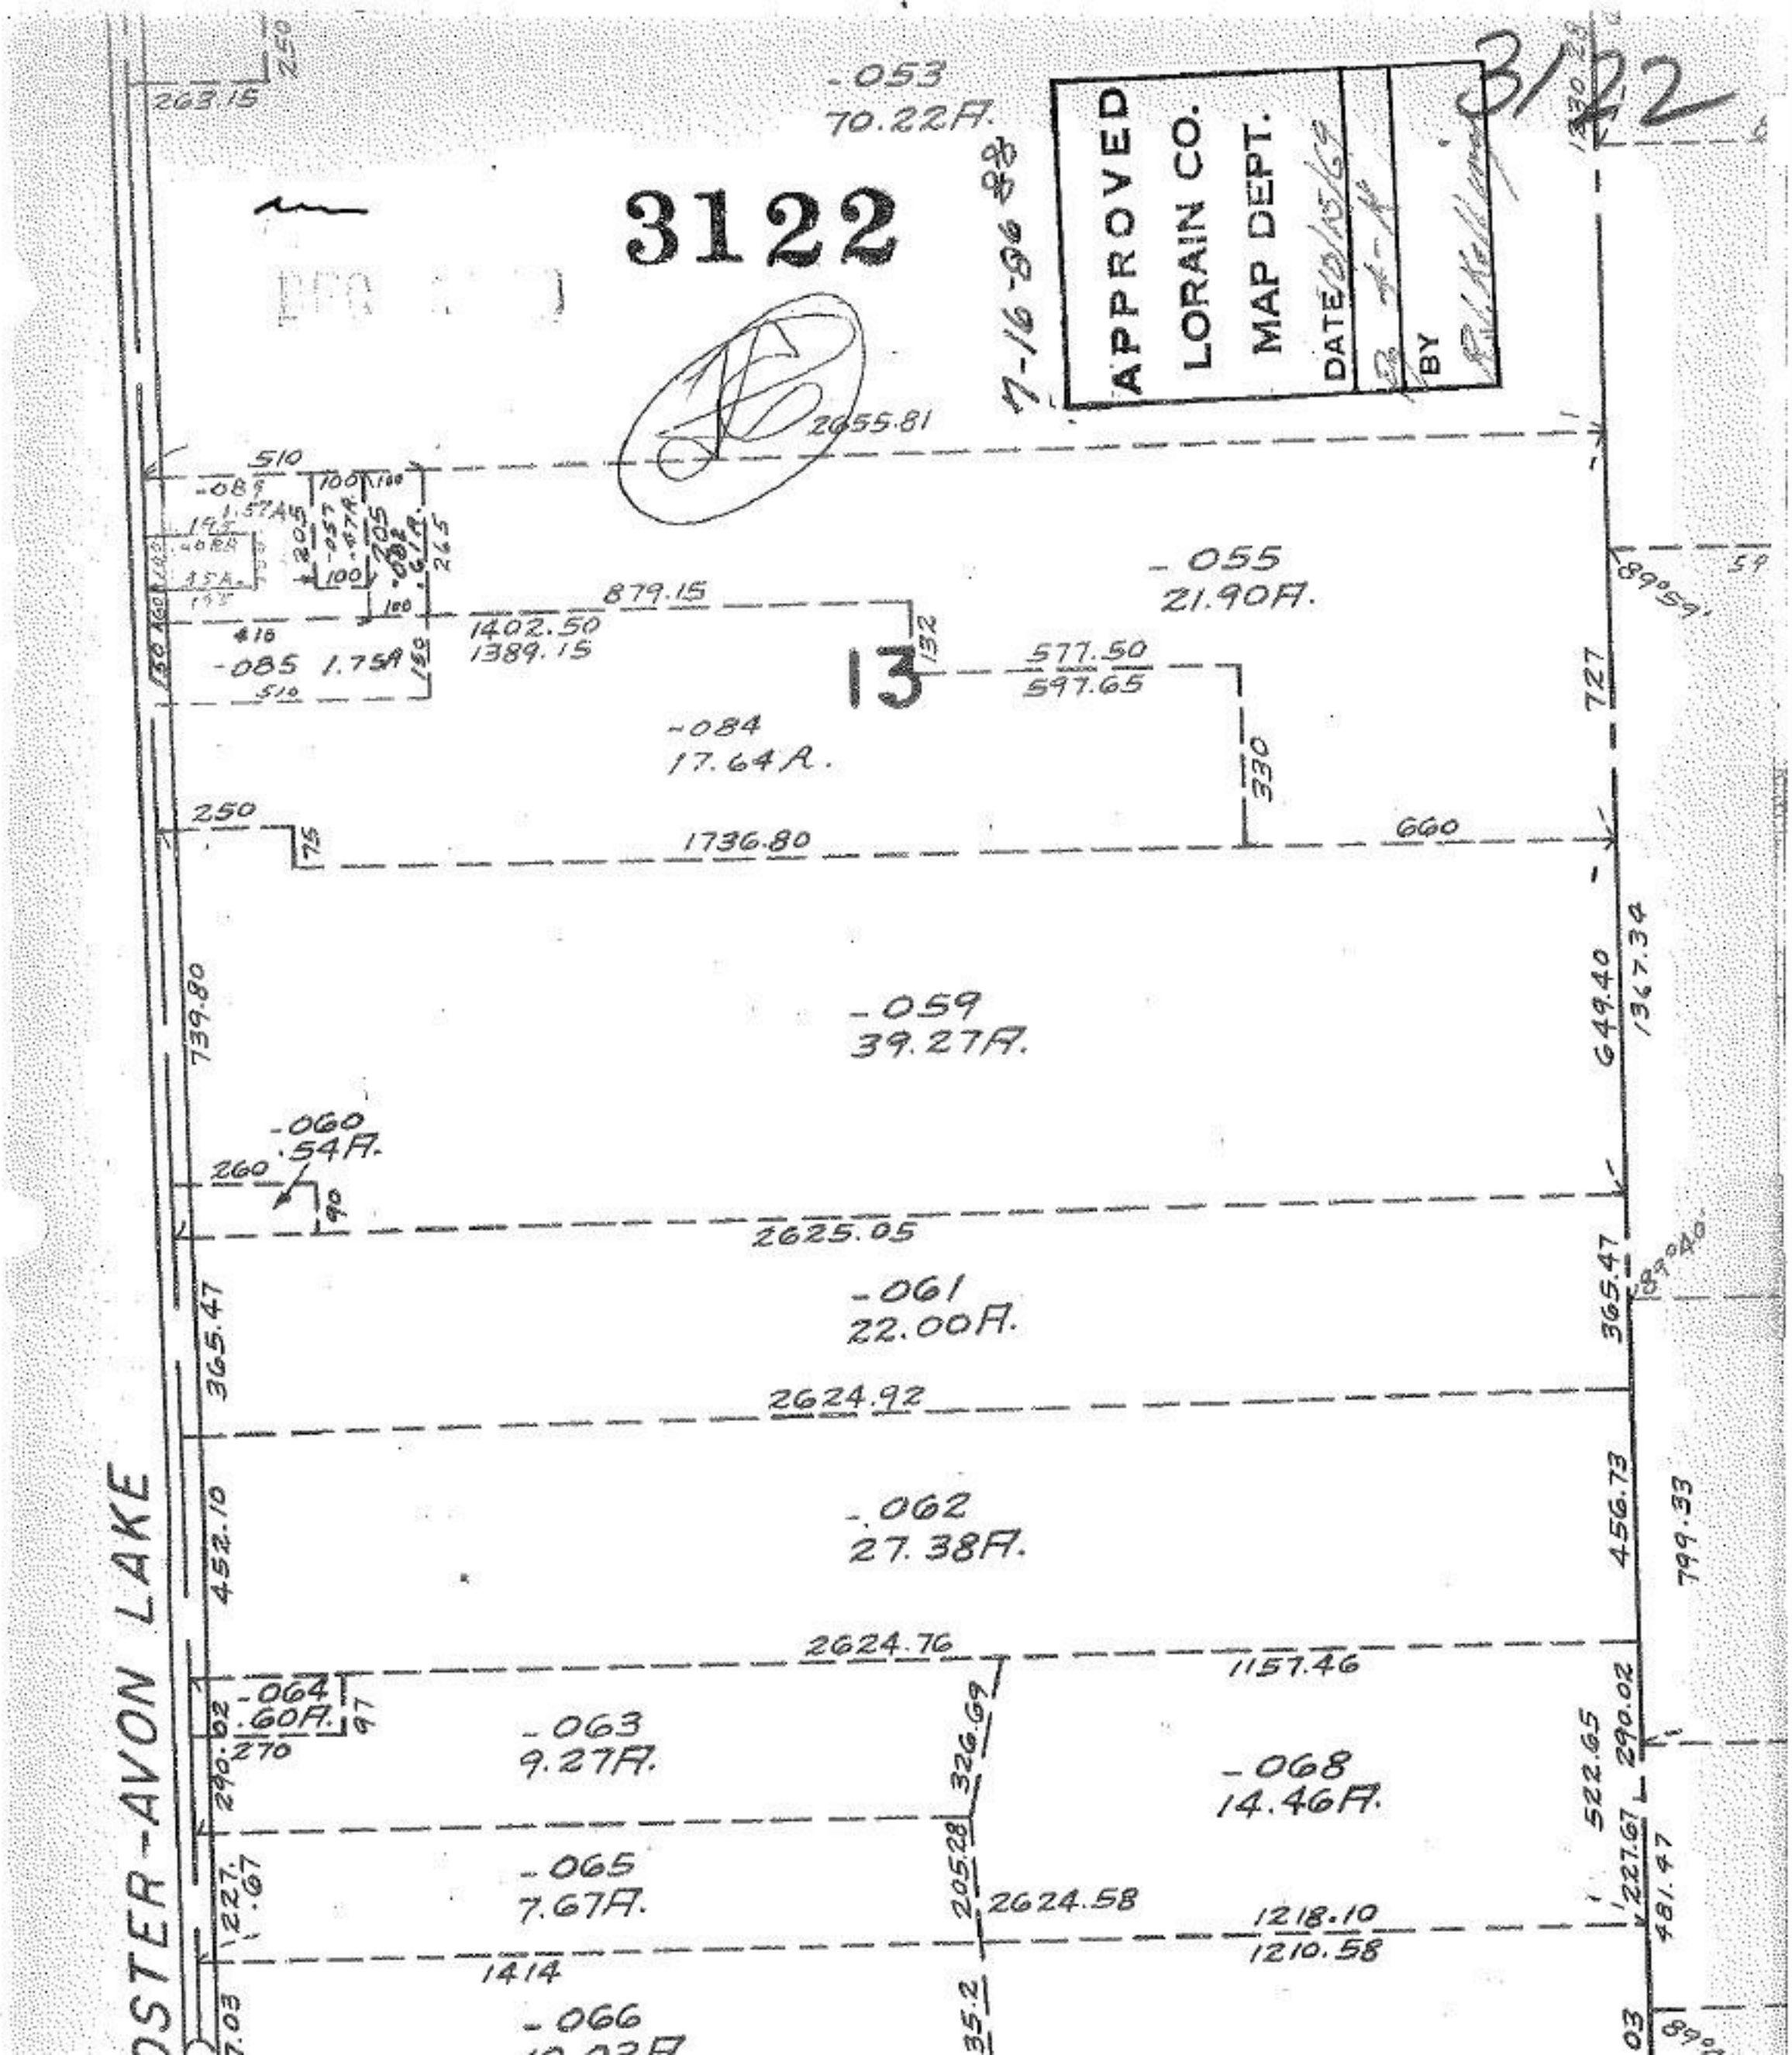
3122
APPROVED
LORAIN CO.
MAP DEPT.
DATE
BY
7-16-86
3122
-053
70.22A.
2655.81
510
-085
1.57A
879.15
1402.50
1389.15
-085 1.75A
13
-055
21.90A.
577.50
597.65
-084
17.64A.
330
727
250
1736.80
660
739.80
-059
39.27A.
649.40
1367.34
-060
.54A.
260
2625.05
-061
22.00A.
365.47
2624.92
-062
27.38A.
452.10
456.73
799.33
2624.76
1157.46
-064
.60A.
270
-063
9.27A.
326.69
-068
14.46A.
522.65
290.02
-065
7.67A.
205.28
2624.58
1218.10
1210.58
227.67
481.47
1414
-066
35.2
OSTER-AVON LAKE