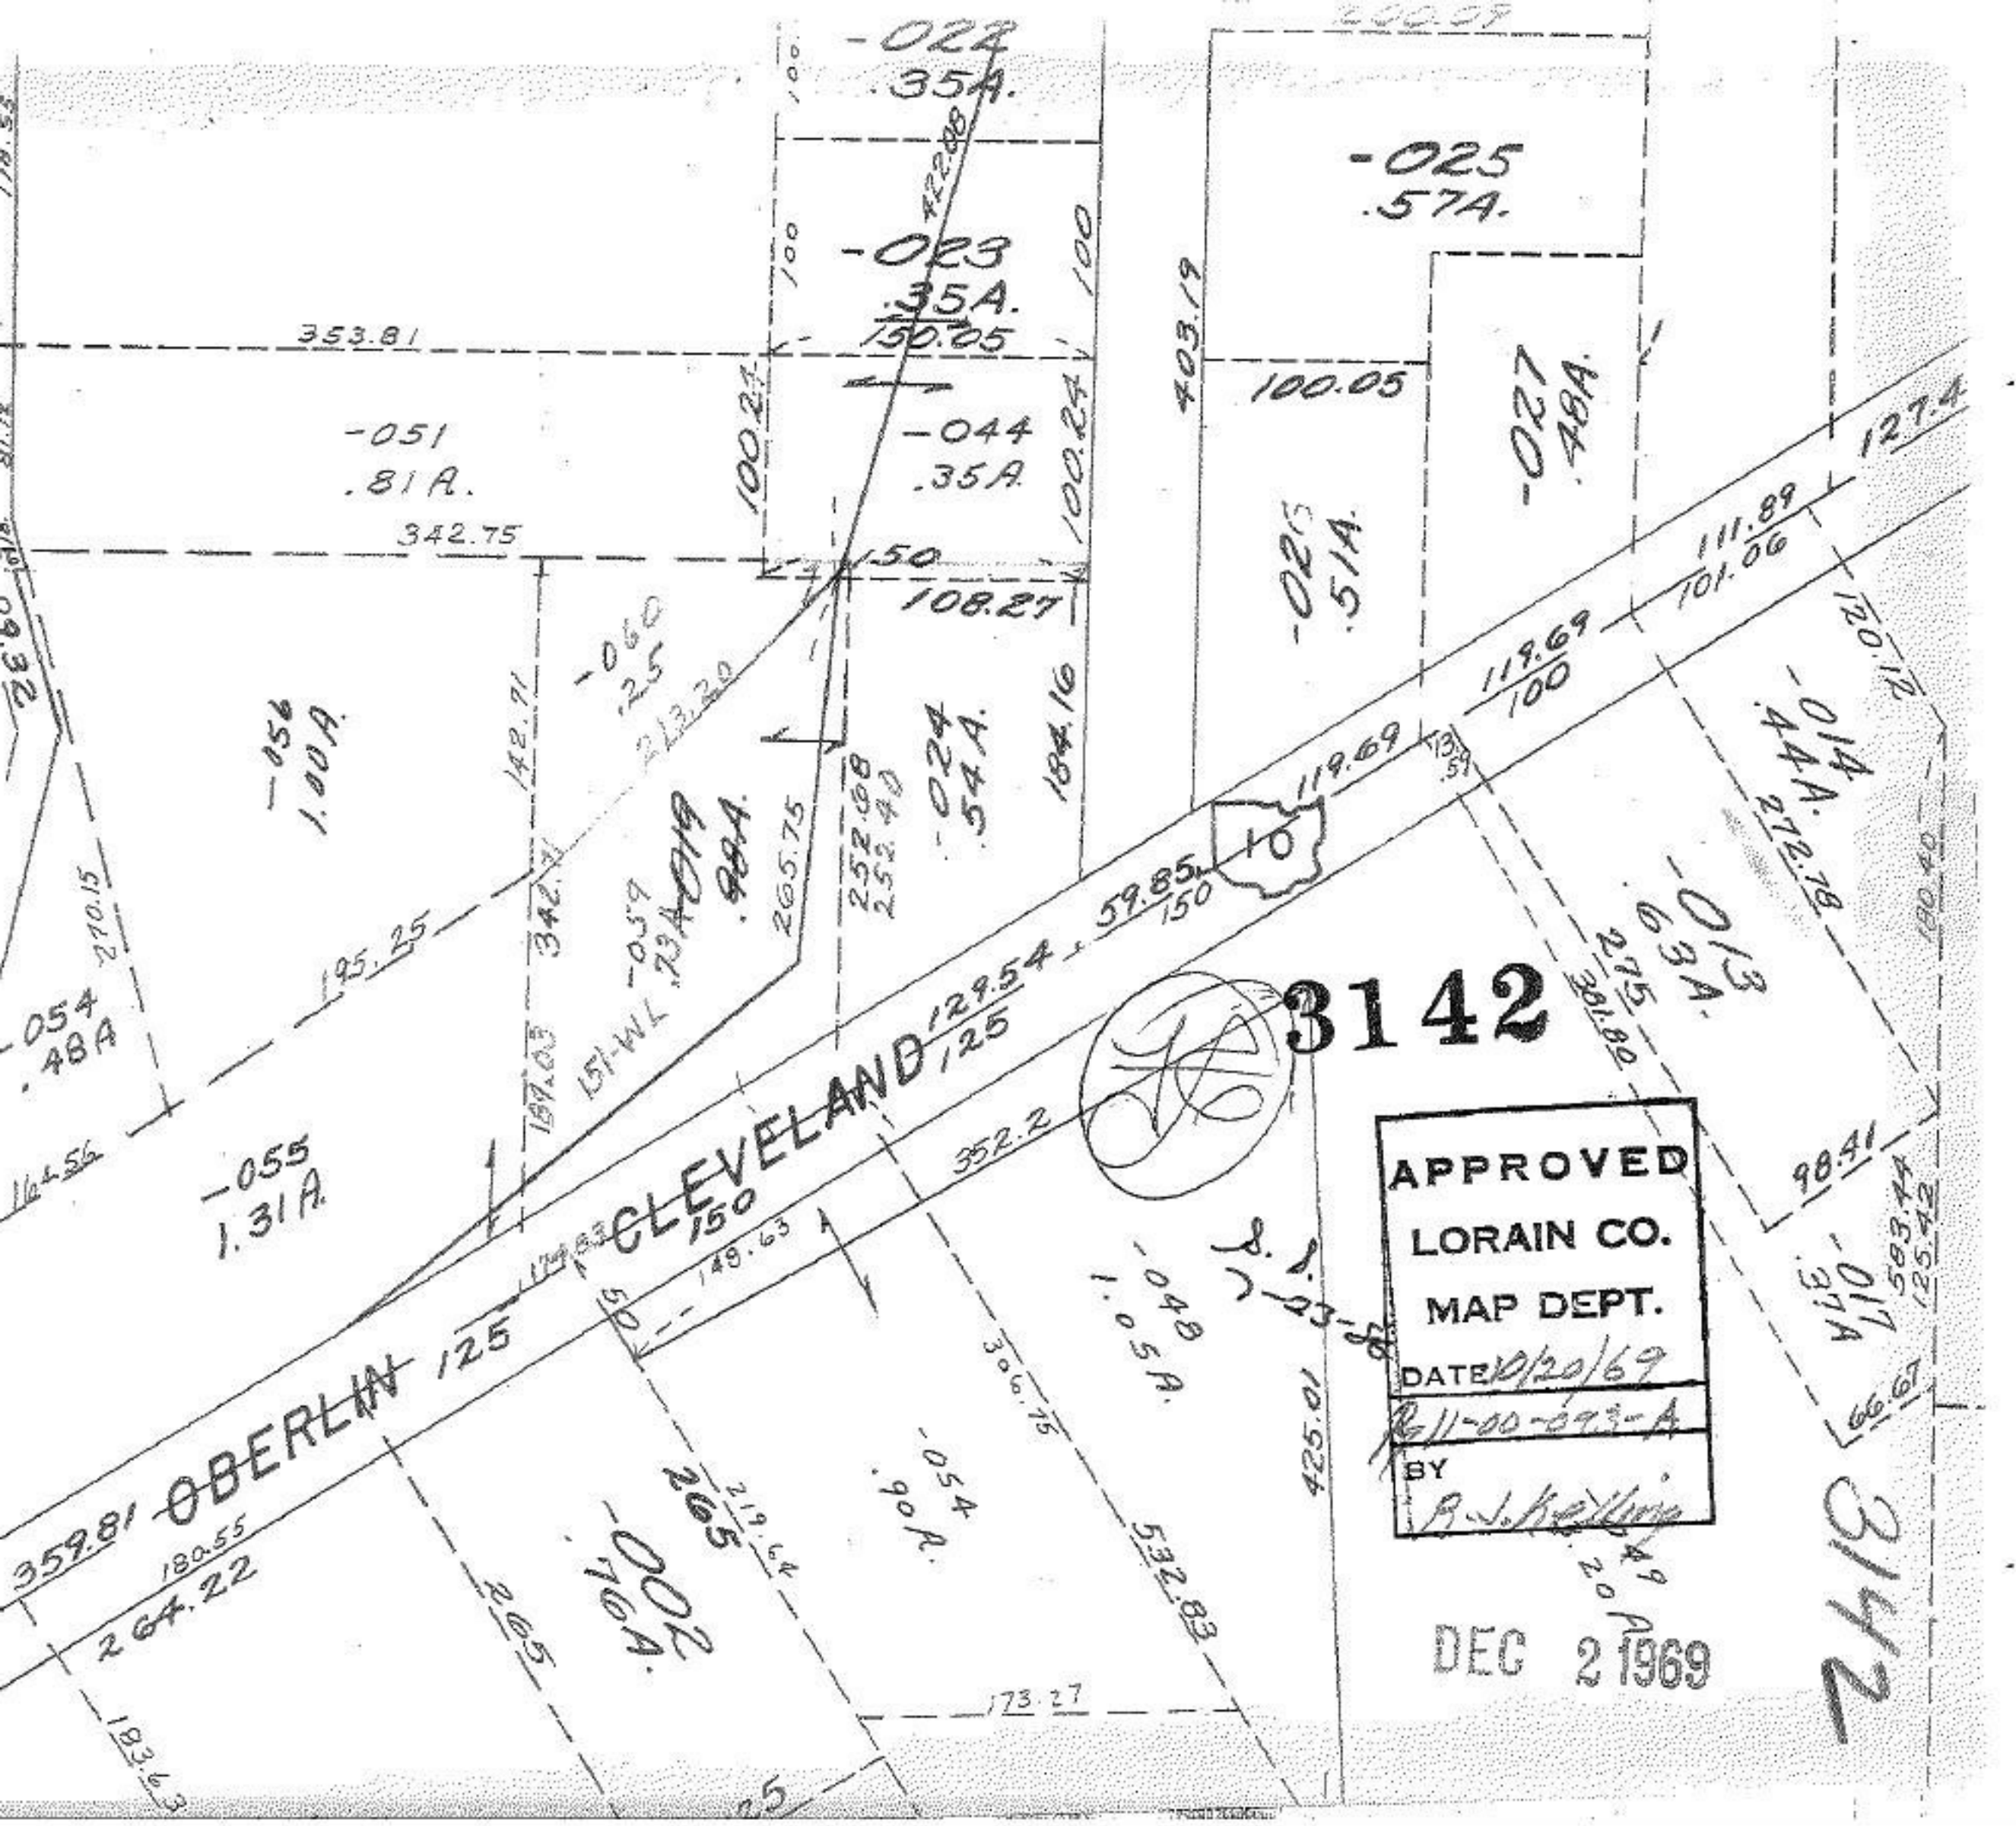

-022
.35A.
-023
.35A.
150.05
-025
.57A.
-027
.48A.
-026
.51A.
-051
.81A.
-044
.35A.
353.81
342.75
100.05
403.19
108.27
-060
.25
-056
1.00A.
-024
.54A.
184.16
119.69
100
111.89
101.06
127.4
120.12
-014
.44A.
272.78
-013
.63A.
275
381.80
98.41
-017
.37A
583.44
125.42
66.67
-054
.48A
-055
1.31A.
195.25
142.71
342.71
265.75
252.68
252.40
59.85
150
129.54
125
352.2
149.63
-048
1.05A.
306.75
425.01
-054
.90A.
532.83
-002
.76A.
265
219.64
180.55
264.22
359.81
OBERLIN 125
CLEVELAND
150
151-WL
3142
APPROVED
LORAIN CO.
MAP DEPT.
DATE 10/20/69
11-00-093-A
BY
R. J. Kelling
DEC 2 1969
3142