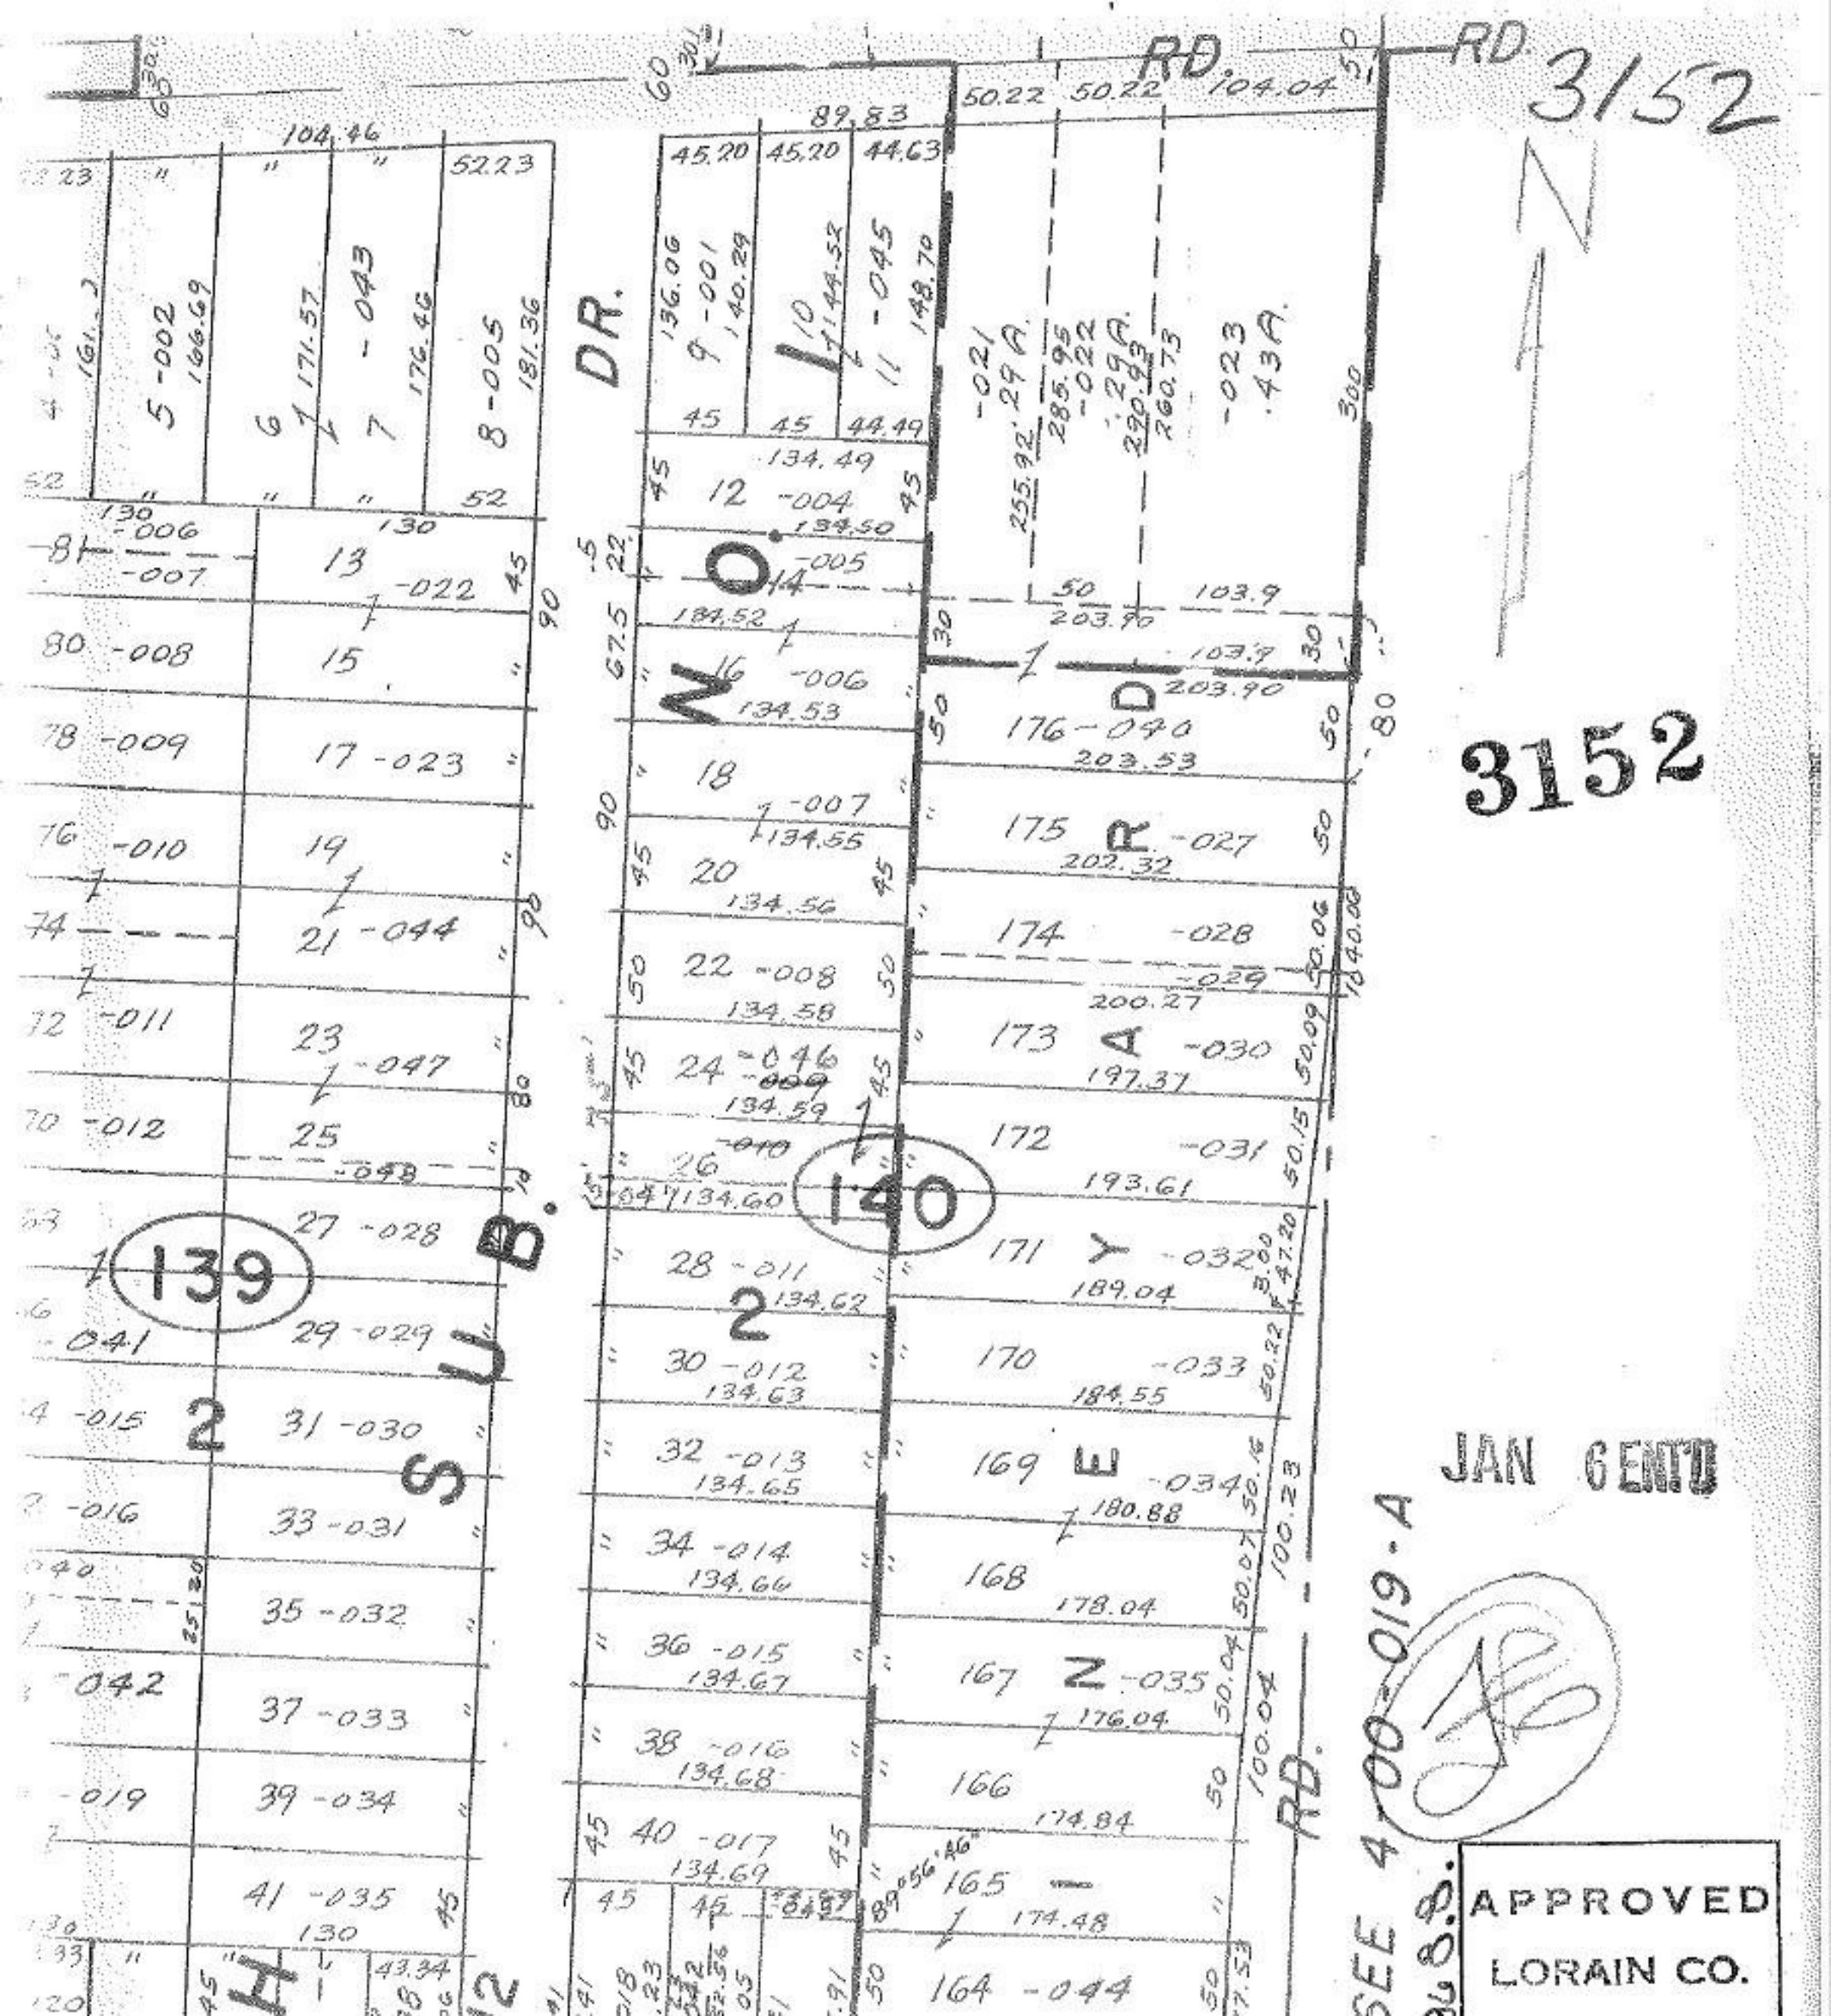
3152
RD.
RD.
DR.
N O
S U B.
2
139
140
N D R A Y E Z
RD.
3152
JAN 6 ENTD
SEE 4-00-019-A
APPROVED
LORAIN CO.