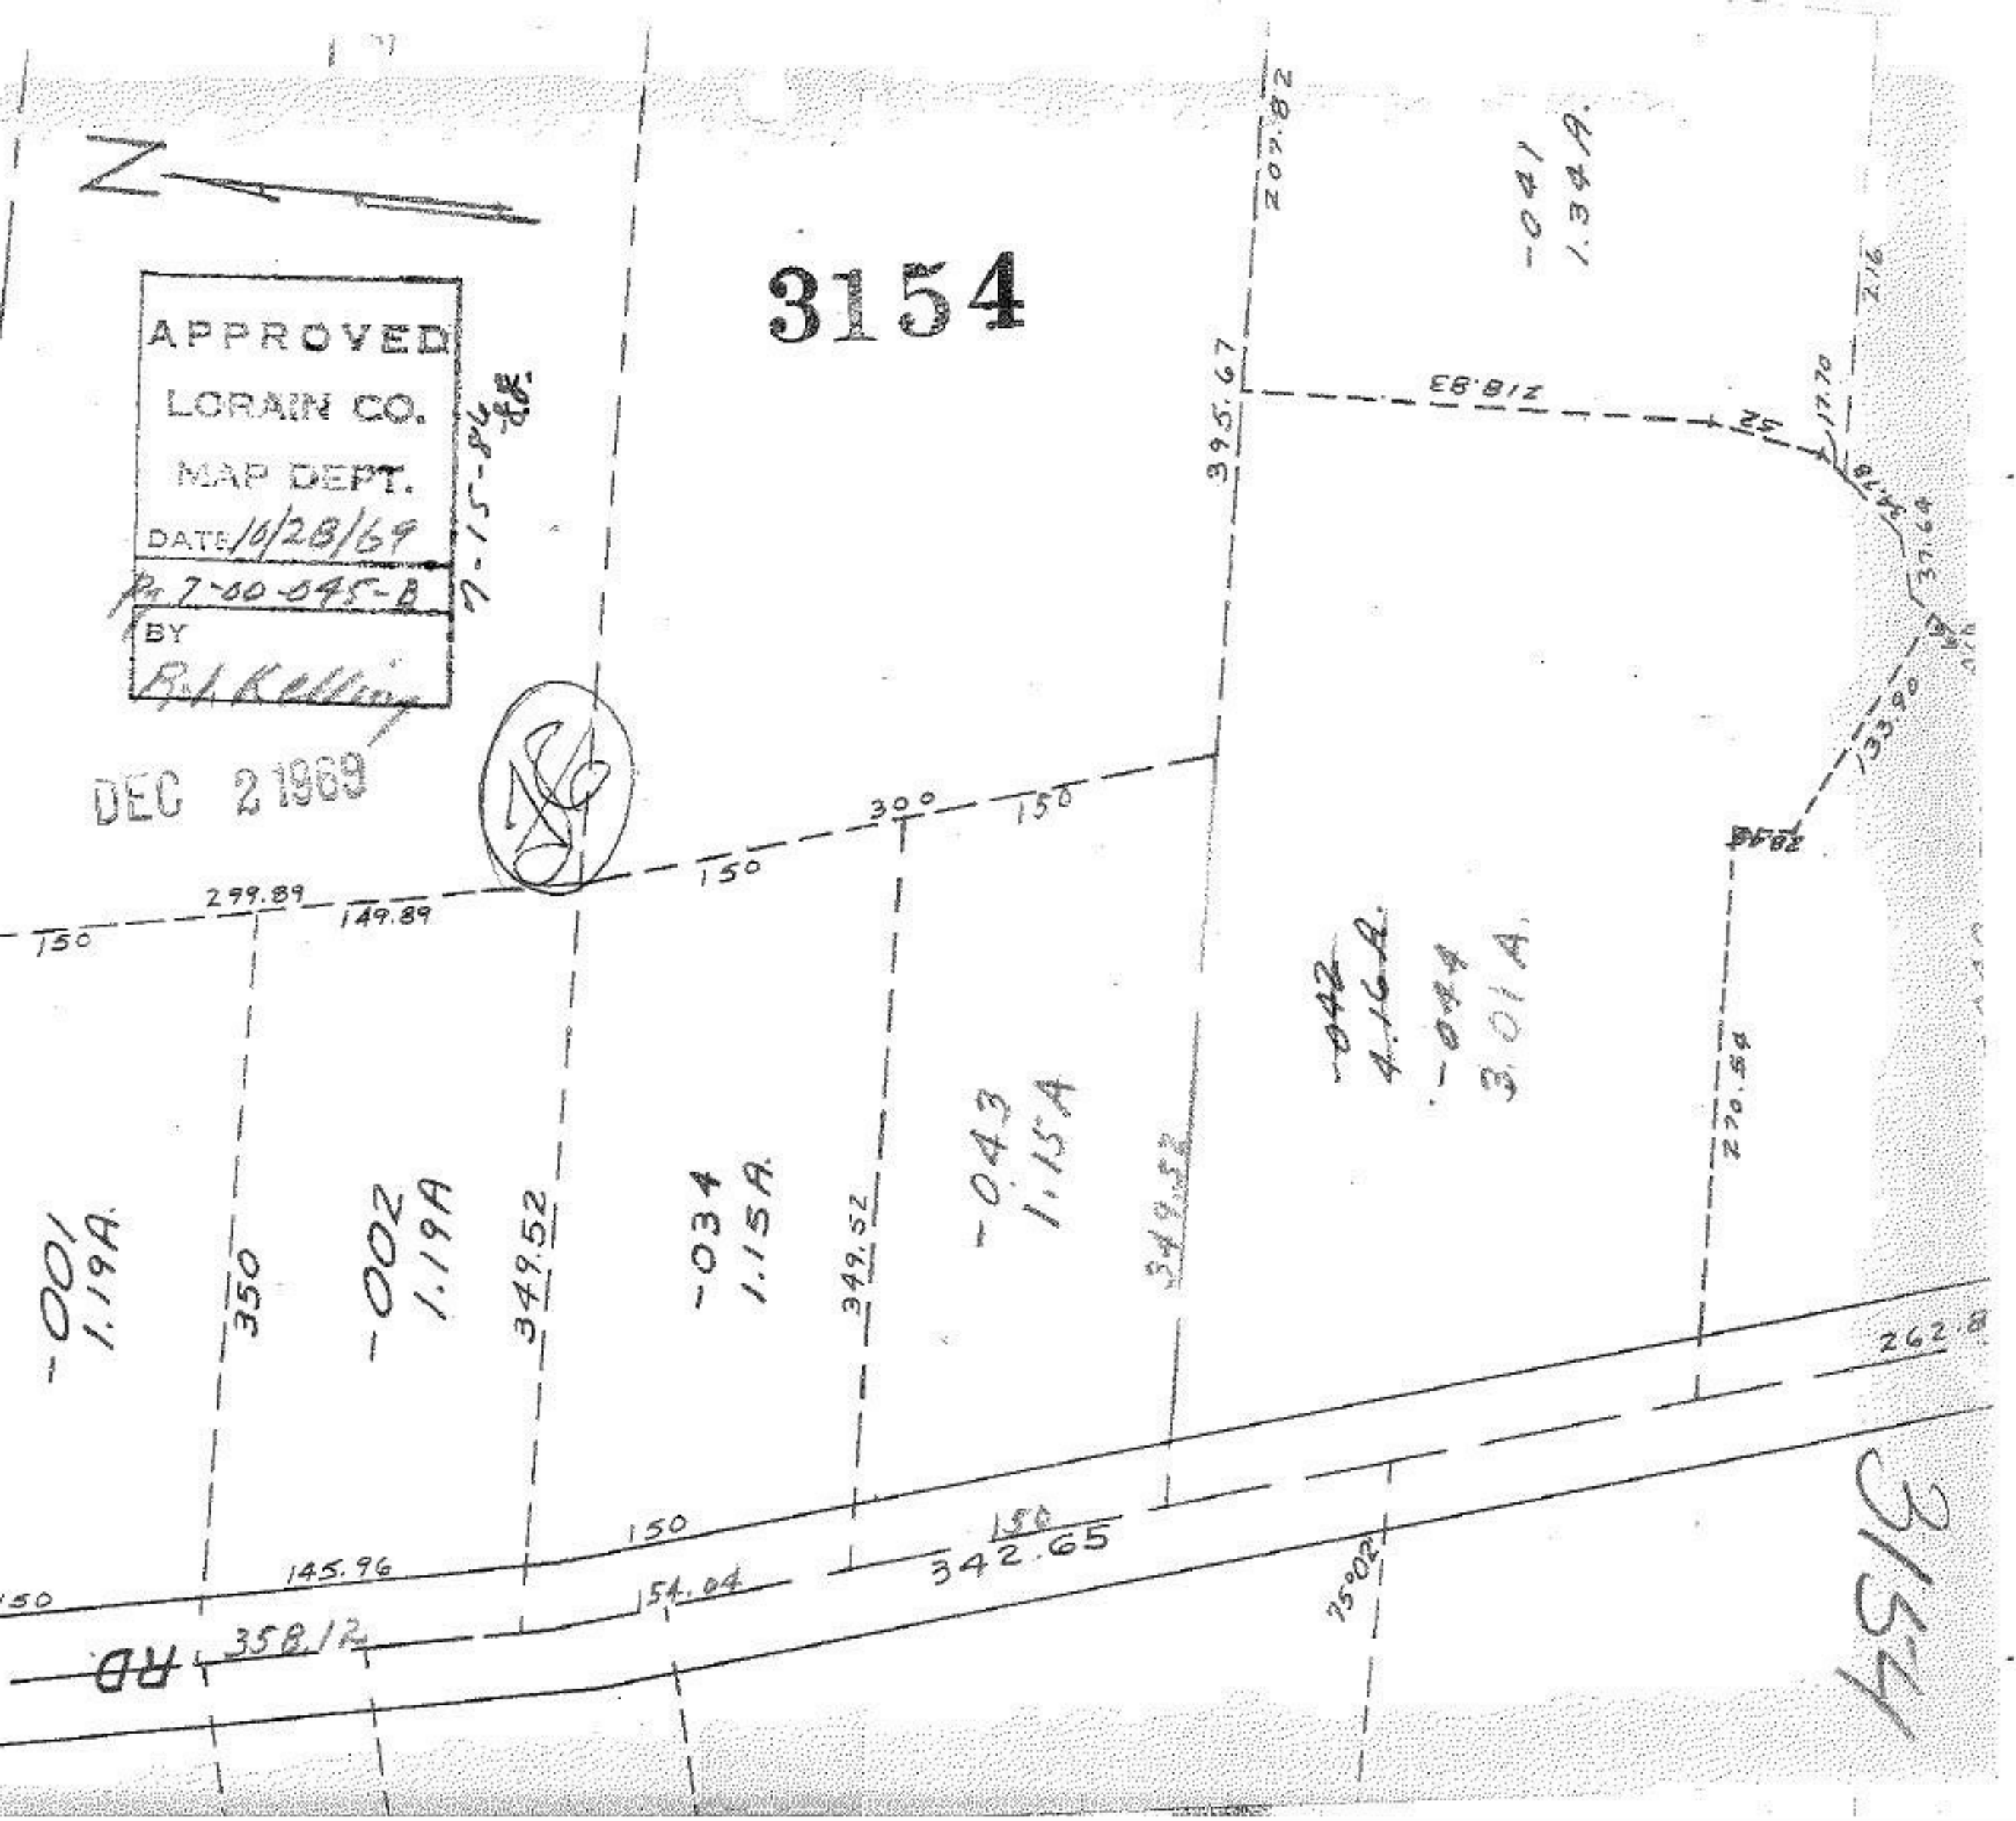

3154
APPROVED
LORAIN CO.
MAP DEPT.
DATE 10/28/69
Pg 7-00-045-B
BY
DEC 2 1969
7-15-86
207.82
-041
1.34A.
395.67
218.83
17.70
37.64
133.90
300
150
299.89
149.89
-042
4.16A.
-044
3.01A.
270.54
-001
1.19A.
350
-002
1.19A
349.52
-034
1.15A.
-043
1.15A
262.8
145.96
54.04
342.65
358.12
RD
3154