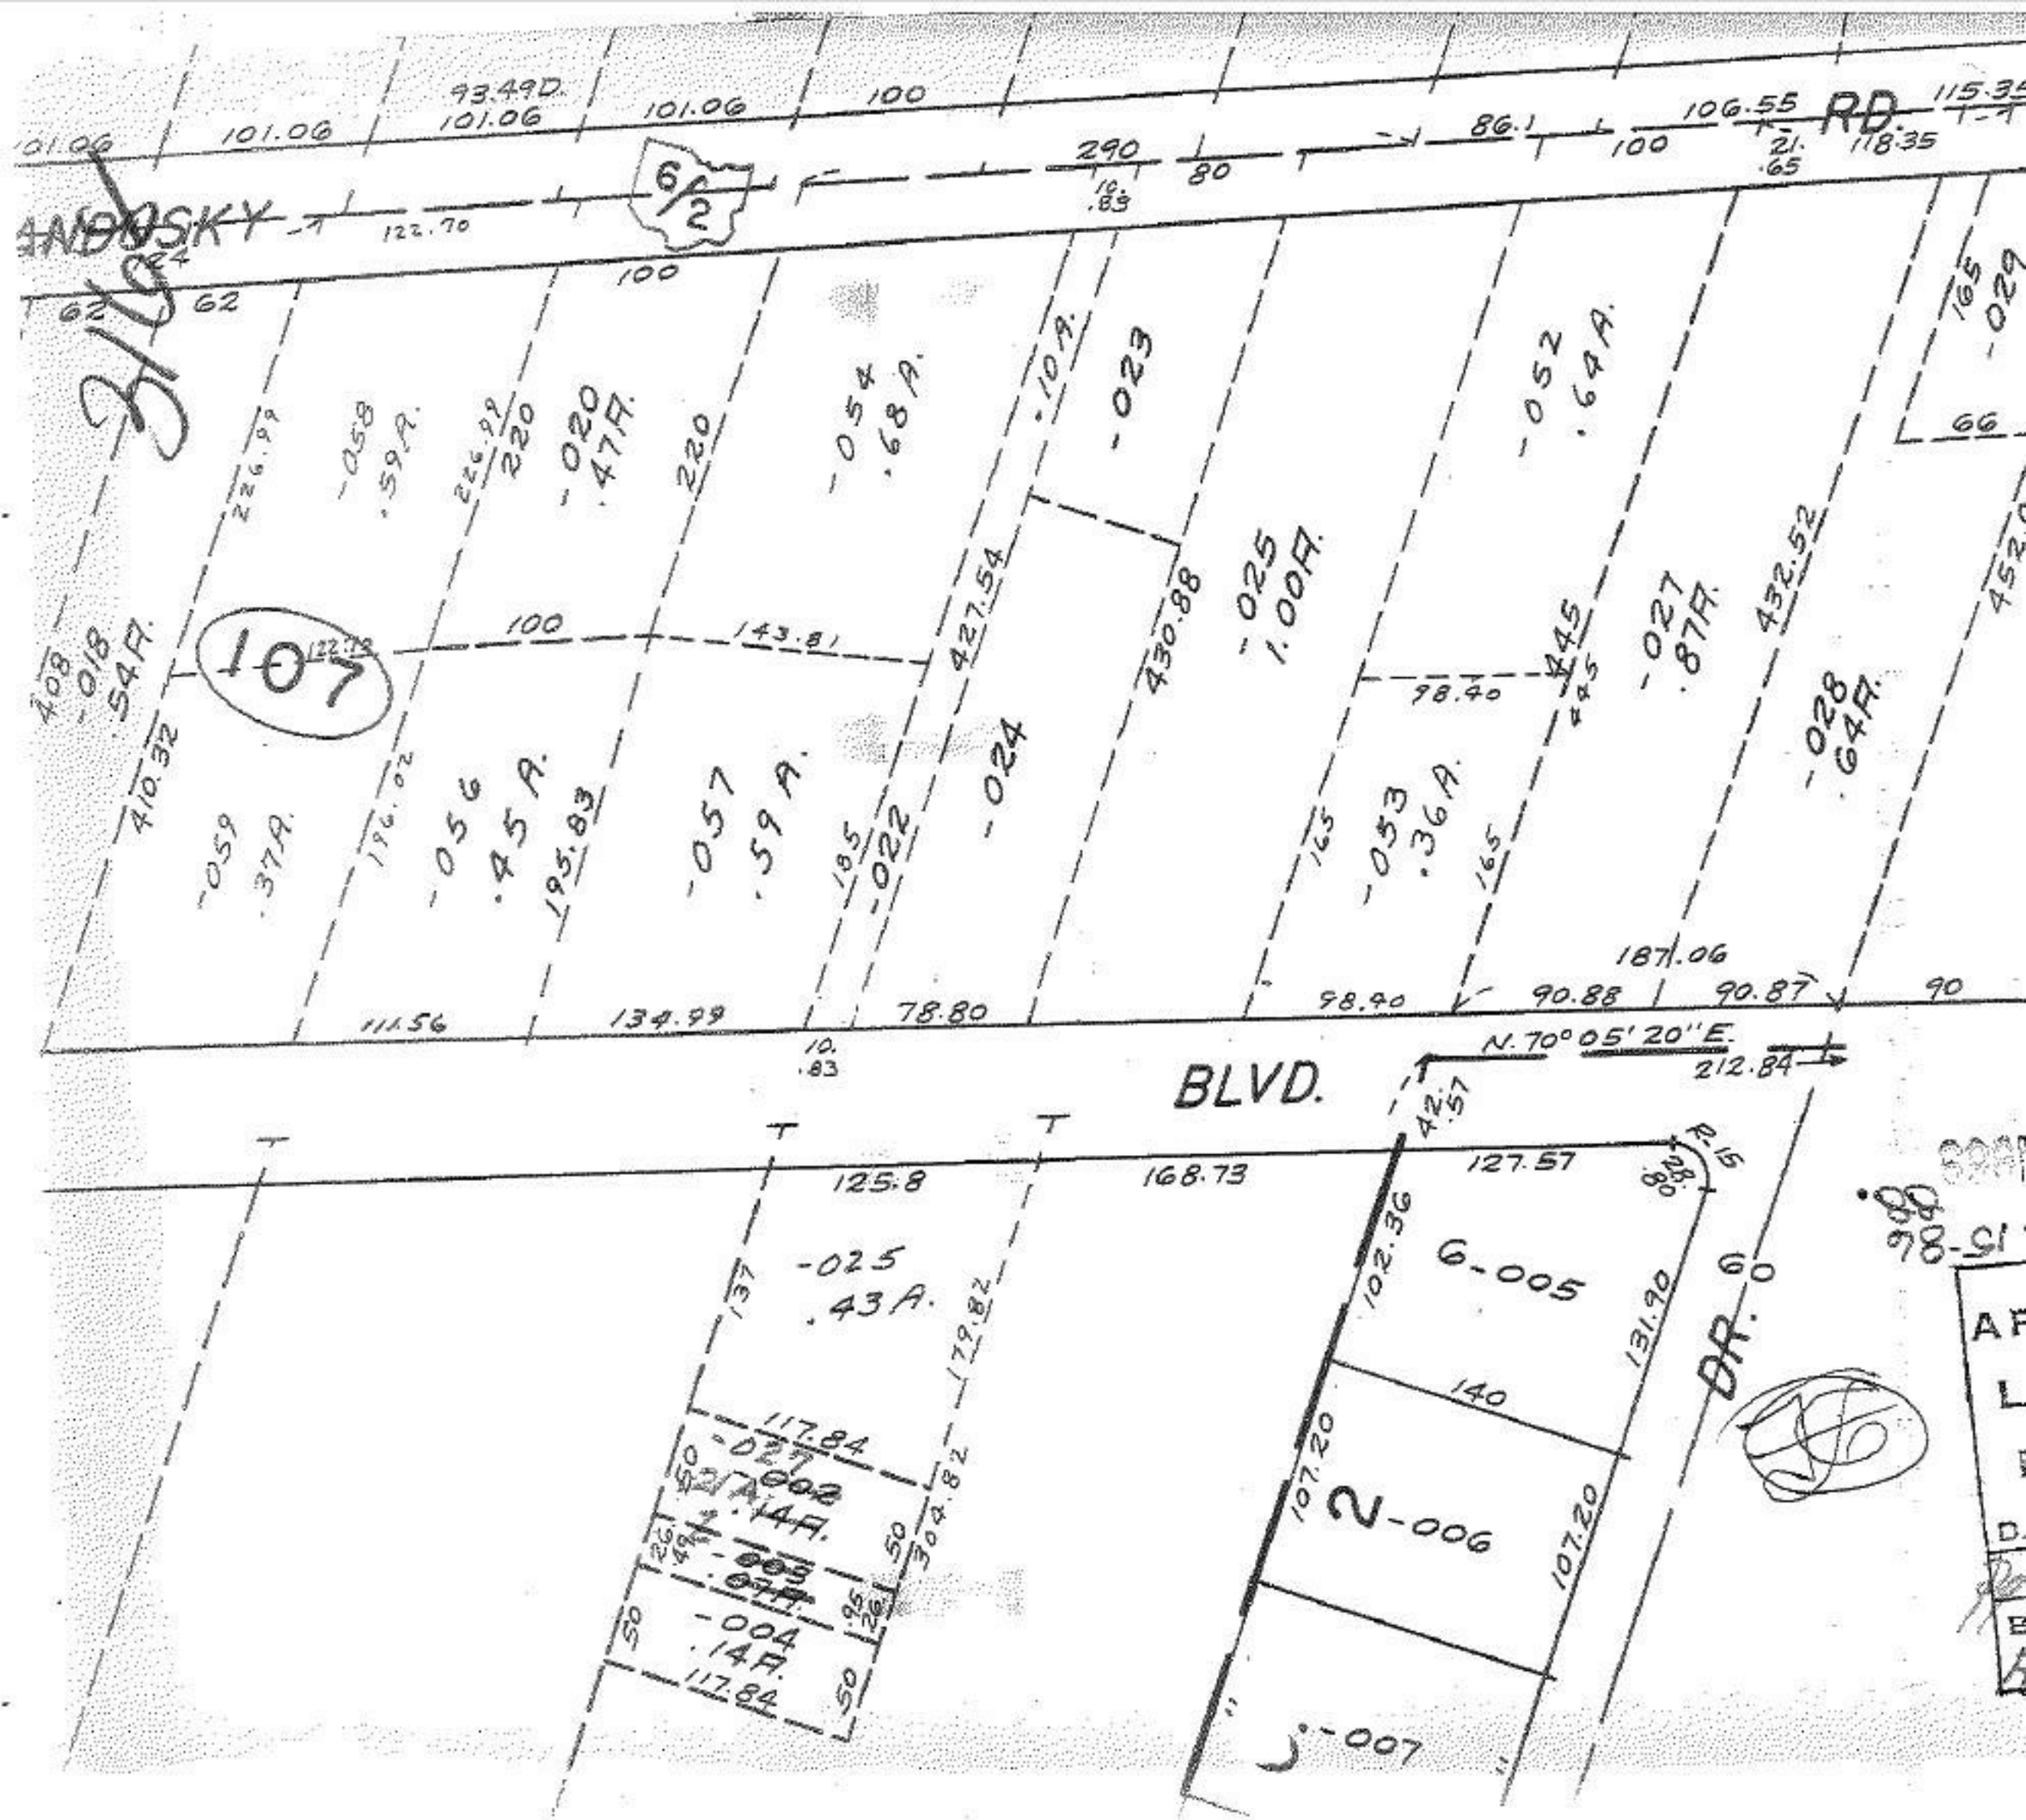

RD.
BLVD.
DR.
N. 70° 05' 20" E.
6/2
107
6-005
2-006
-007
-025
.43 A.
-004
.14 A.
-027
.14 A.
-003
.07 A.
-059
.37 A.
-056
.45 A.
-057
.59 A.
-058
.59 A.
-020
.47 A.
-054
.68 A.
-022
-024
-023
-025
1.00 A.
-053
.36 A.
-052
.64 A.
-027
.87 A.
-028
.64 A.
-029
-018
.54 A.