

3169

-025
67.92 A.

-026
8.39 A.

1218.73

1218.36

989.02
1221.56



2919.60
27.19.83

299.77

300

~~-001~~ -008
50.50 A. 81.83

-007
9.40 A

1365.40

N


~~-002~~
40.00 A.

19

24.09.38

300

-003
52.00 A.

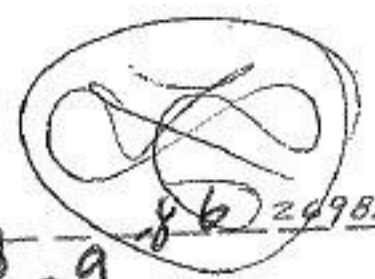

2498.24

8 a
1-2006
1-57 A

1007.10
-005
6.84 A.

283.23
-006
1.16 A.
259.23 A

200

101

1506.72

530.81