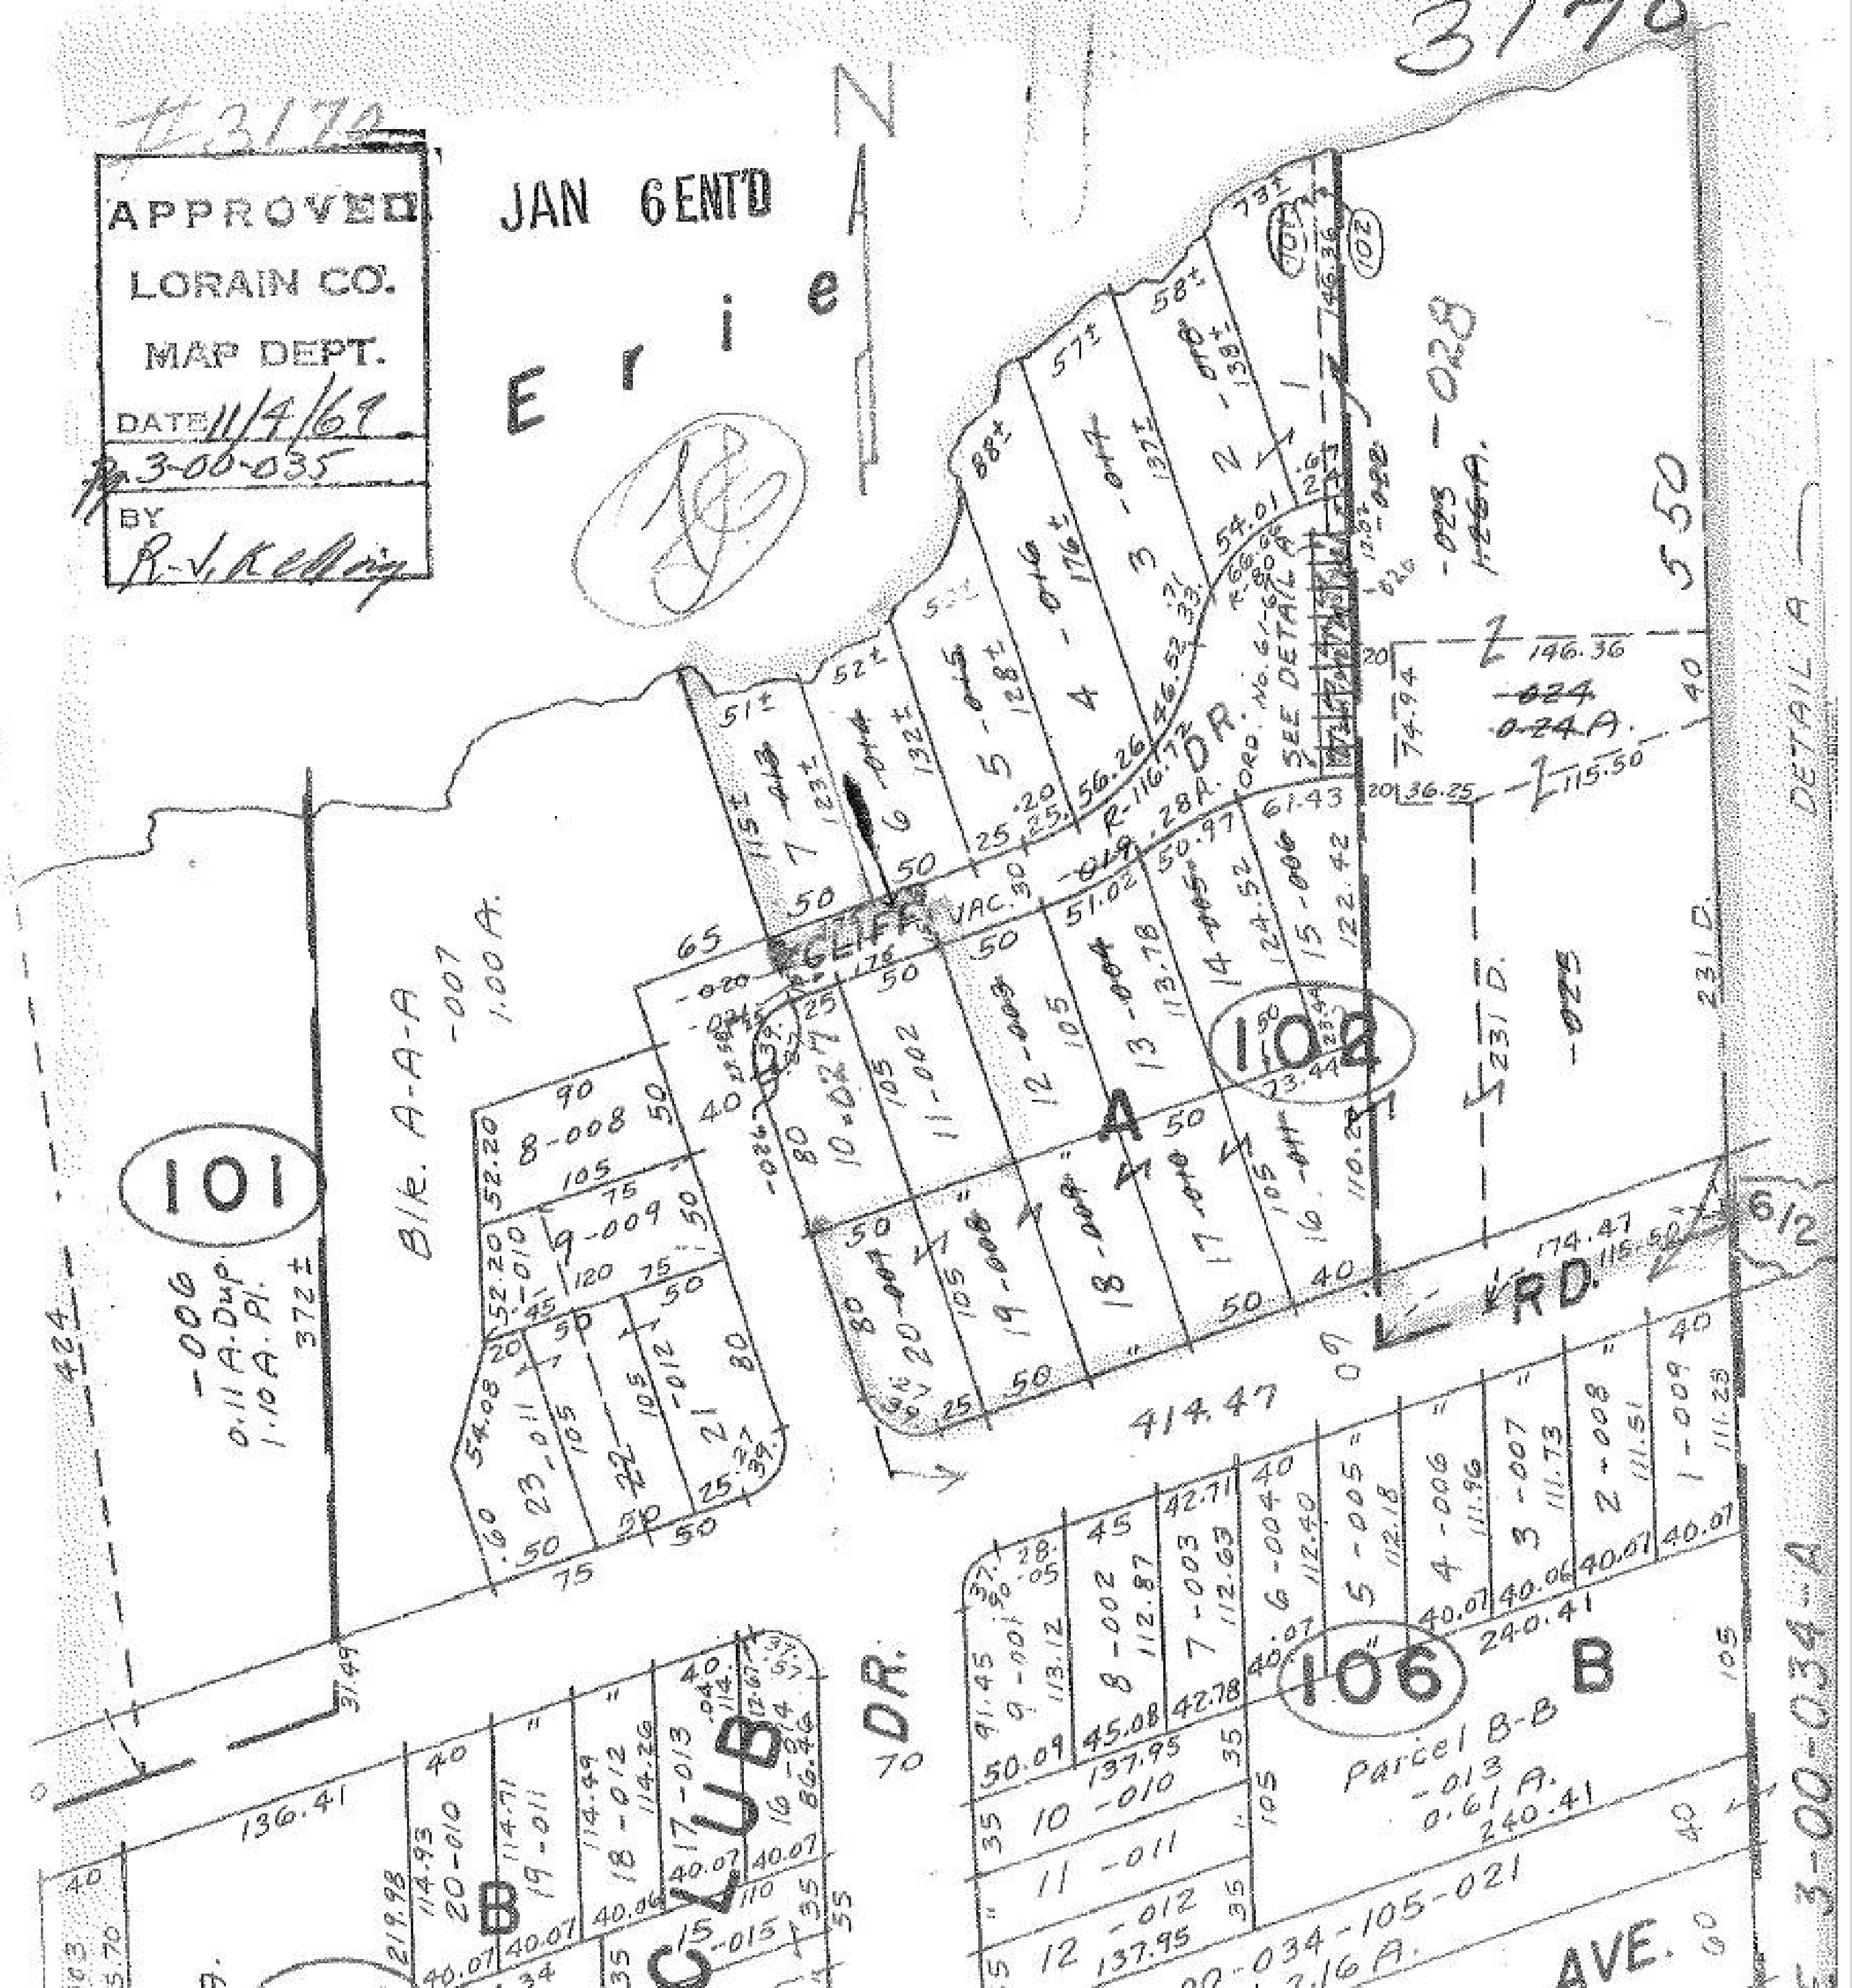

3170
#3170
APPROVED
LORAIN CO.
MAP DEPT.
DATE 11/4/69
3-00-035
BY
R. J. Kelling
JAN 6 ENT'D
N
Erie
101
-006
0.11 A. Dup.
1.10 A. Pl.
372±
424
Blk. A-A-A
-007
1.00 A.
CLIFF
VAC. 30
DR.
R-116.72
ORD. No. 61-67
SEE DETAIL A
102
A
-028
-025
146.36
0.24 A.
115.50
231 D.
550
DETAIL A
174.47
RD.
414.47
612
106
B
Parcel B-B
-013
0.61 A.
240.41
CLUB
DR.
AVE.
3-00-034-A
3-00-034-105-021
136.41