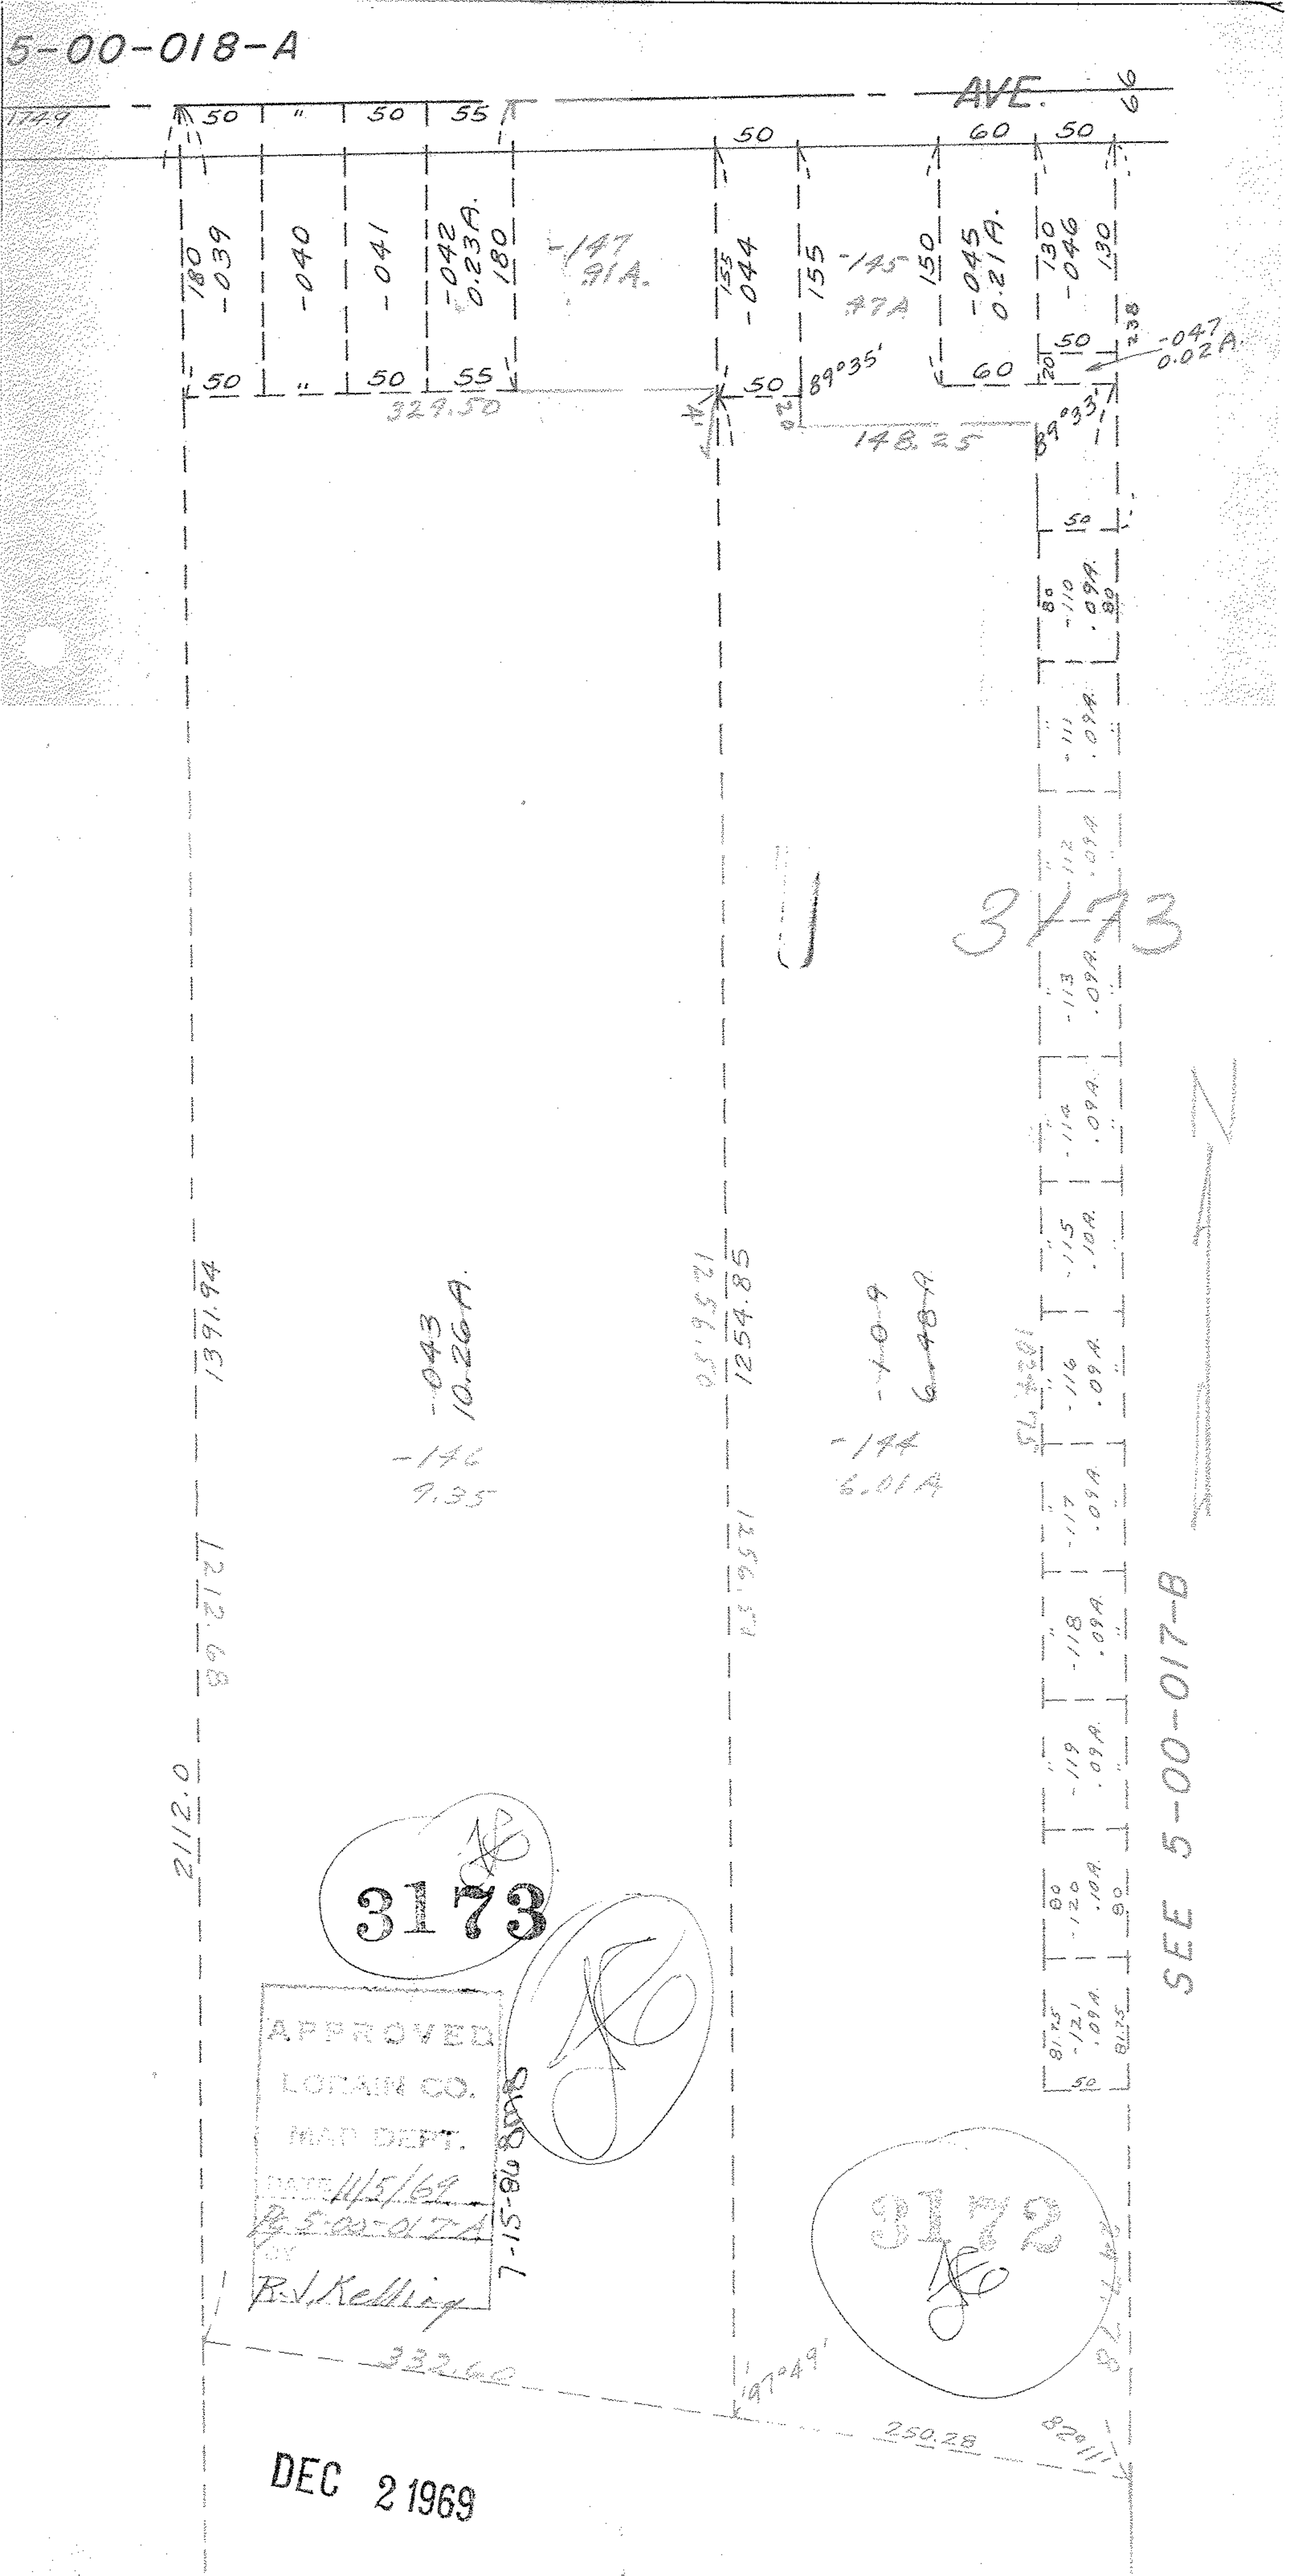
5-00-018-A
AVE.
-039
-040
-041
-042
0.23A.
-147
.91A.
-044
-145
.47A
-045
0.21A.
-046
-047
0.02A.
329.50
148.25
89°35'
89°33'
-110
.09A.
-111
.09A.
-112
.09A.
-113
.09A.
-114
.09A.
-115
.10A.
-116
.09A.
-117
.09A.
-118
.09A.
-119
.09A.
-120
.10A.
-121
.09A.
3173
1391.94
-043
10.26A.
-146
9.35
1254.85
-144
6.01A
2112.0
SEE 5-00-017-B
3173
APPROVED
LORAIN CO.
MAP DEPT.
DATE 11/5/69
BY
R.J. Kelling
7-15-86
3172
332.60
97°49'
250.28
82°11'
DEC 2 1969