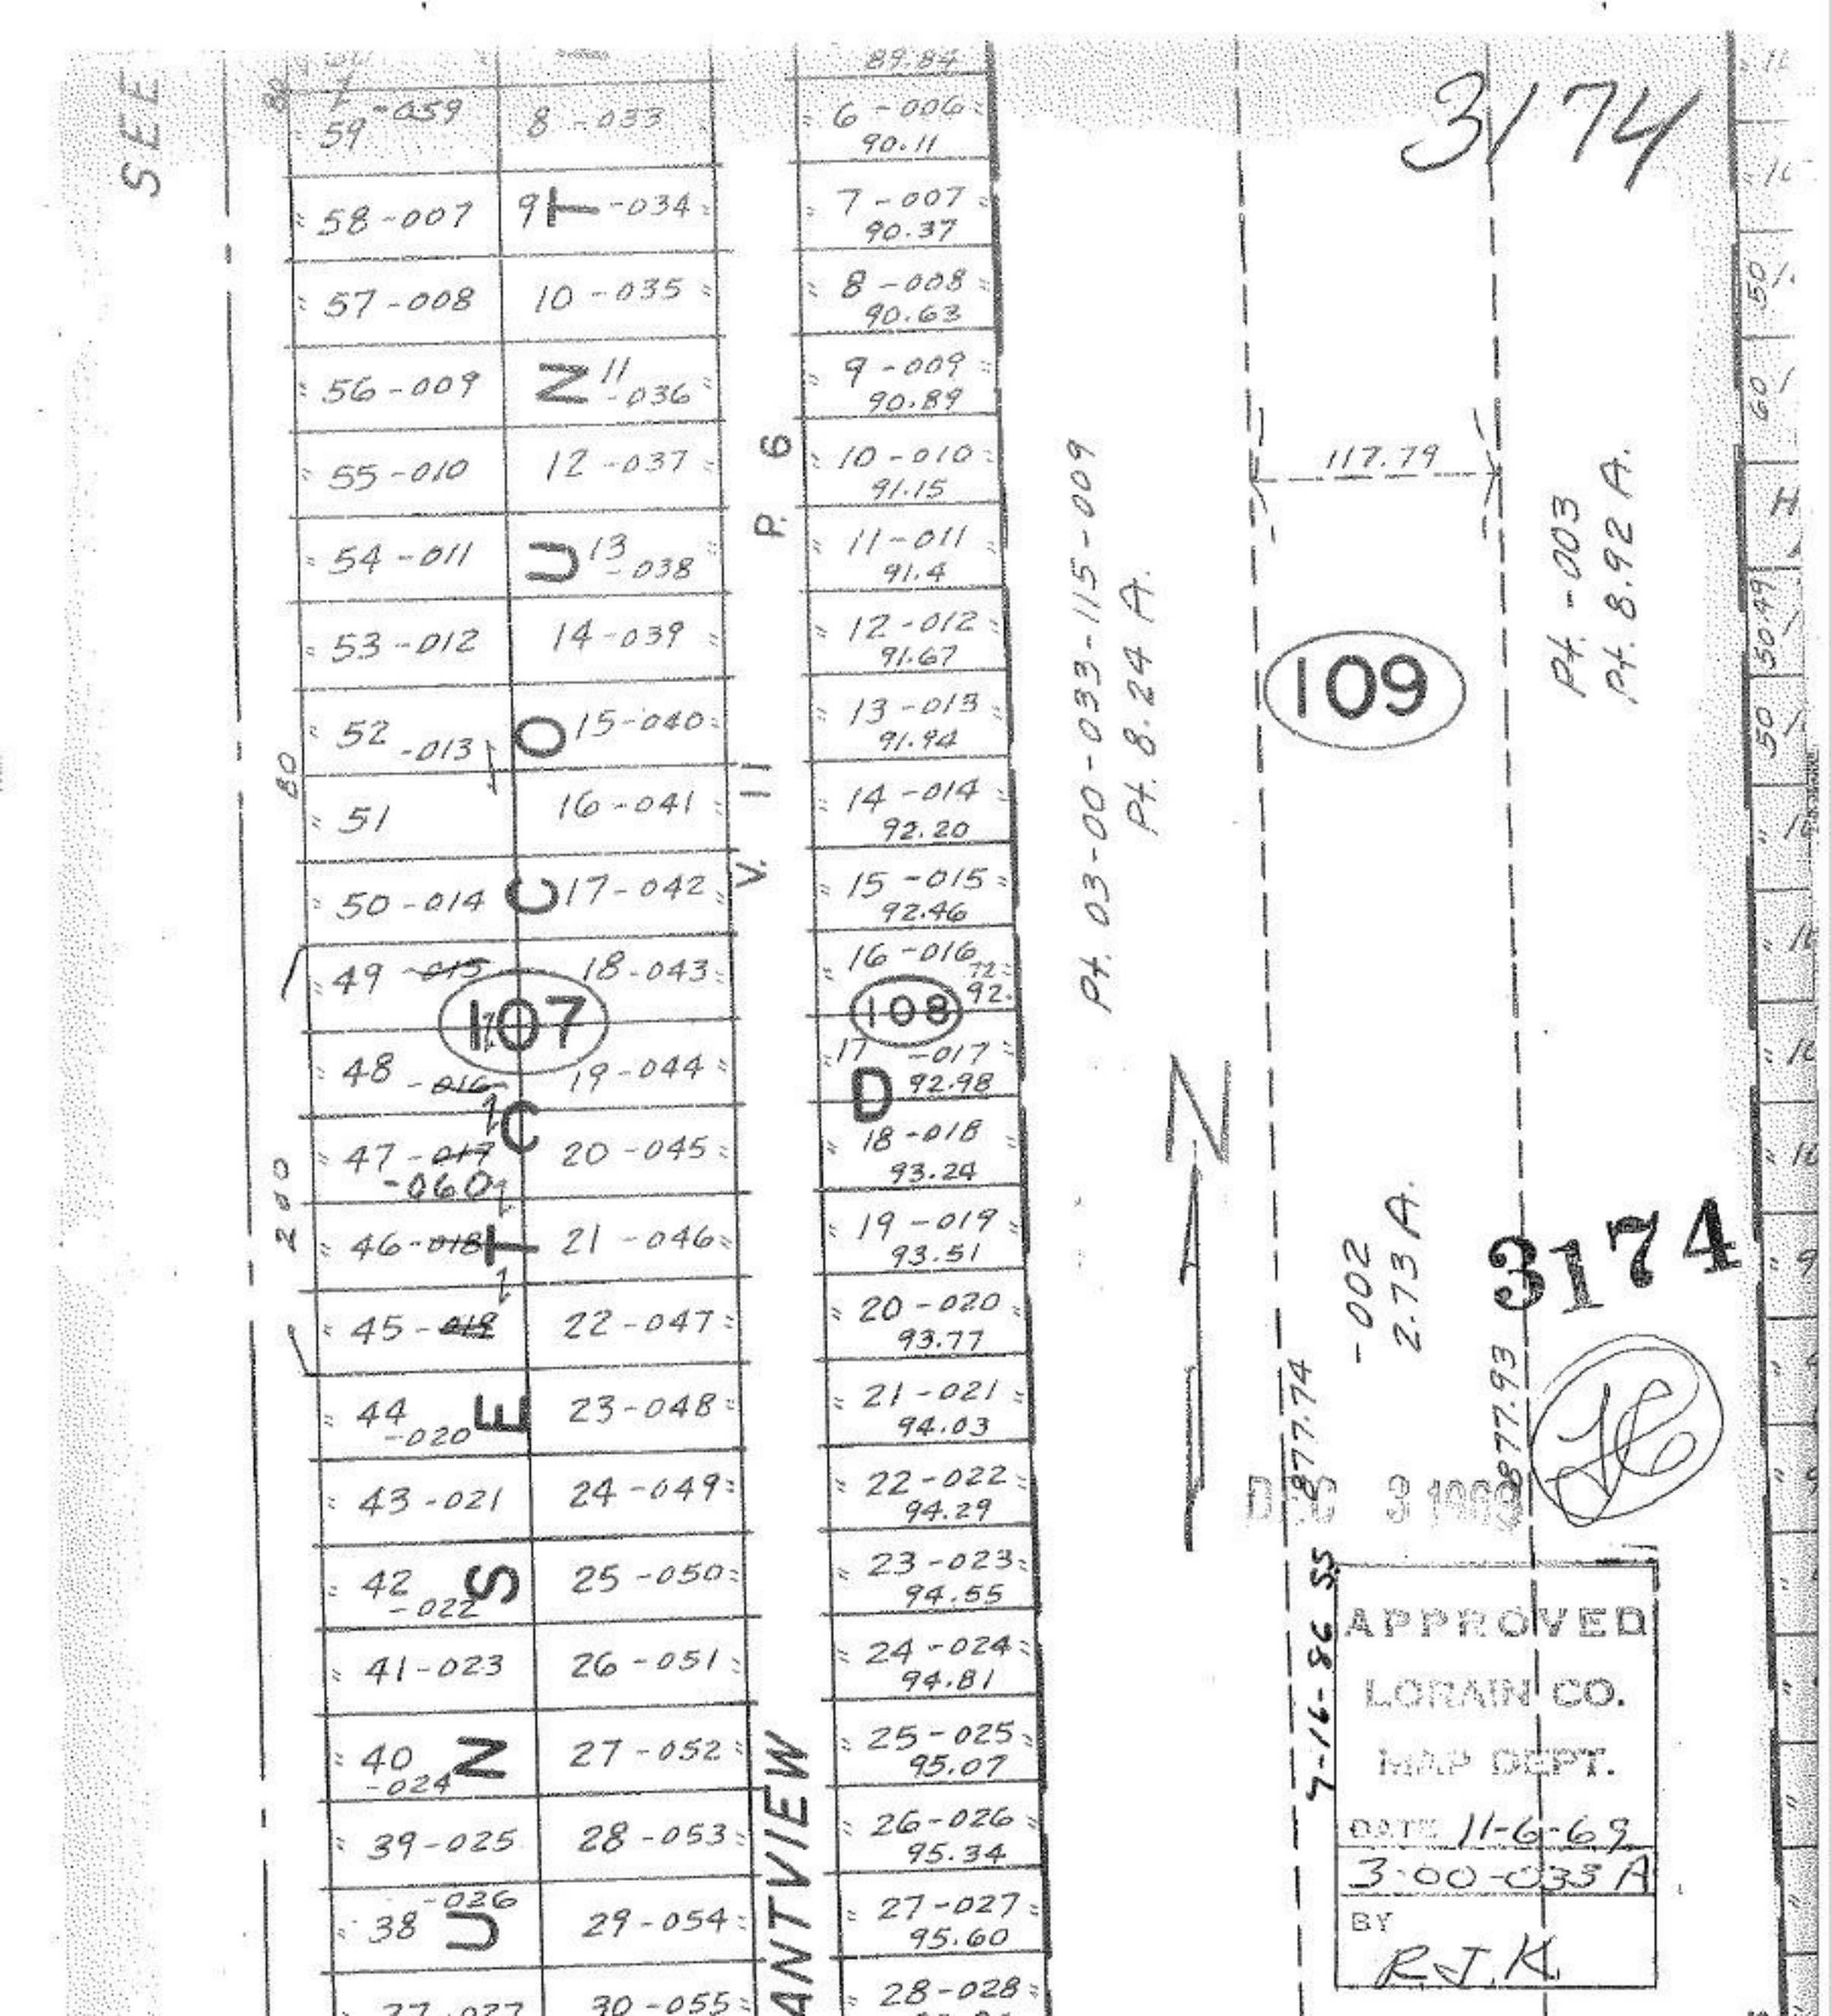

SEE
3174
89.84
59-059
8-033
6-006
90.11
58-007
9-034
7-007
90.37
57-008
10-035
8-008
90.63
56-009
11-036
9-009
90.89
55-010
12-037
10-010
91.15
54-011
13-038
11-011
91.4
53-012
14-039
12-012
91.67
52-013
15-040
13-013
91.94
51
16-041
14-014
92.20
50-014
17-042
15-015
92.46
49-015
18-043
16-016
92.72
107
108
48-016
19-044
17-017
92.98
47-017
-060
20-045
18-018
93.24
46-018
21-046
19-019
93.51
45-018
22-047
20-020
93.77
44-020
23-048
21-021
94.03
43-021
24-049
22-022
94.29
42-022
25-050
23-023
94.55
41-023
26-051
24-024
94.81
40-024
27-052
25-025
95.07
39-025
28-053
26-026
95.34
38-026
29-054
27-027
95.60
37-027
30-055
28-028
80
200
P. 6
V. 11
ANTVIEW
Pt. 03-00-033-115-009
Pt. 8.24 A.
117.79
109
Pt. -003
Pt. 8.92 A.
N
-002
2.73 A.
877.74
877.93
3174
DEC 3 1969
7-16-86 SS
APPROVED
LORAIN CO.
MAP DEPT.
DATE 11-6-69
3-00-033 A
BY
R.J.K.