


SEE 4 20-007

Z

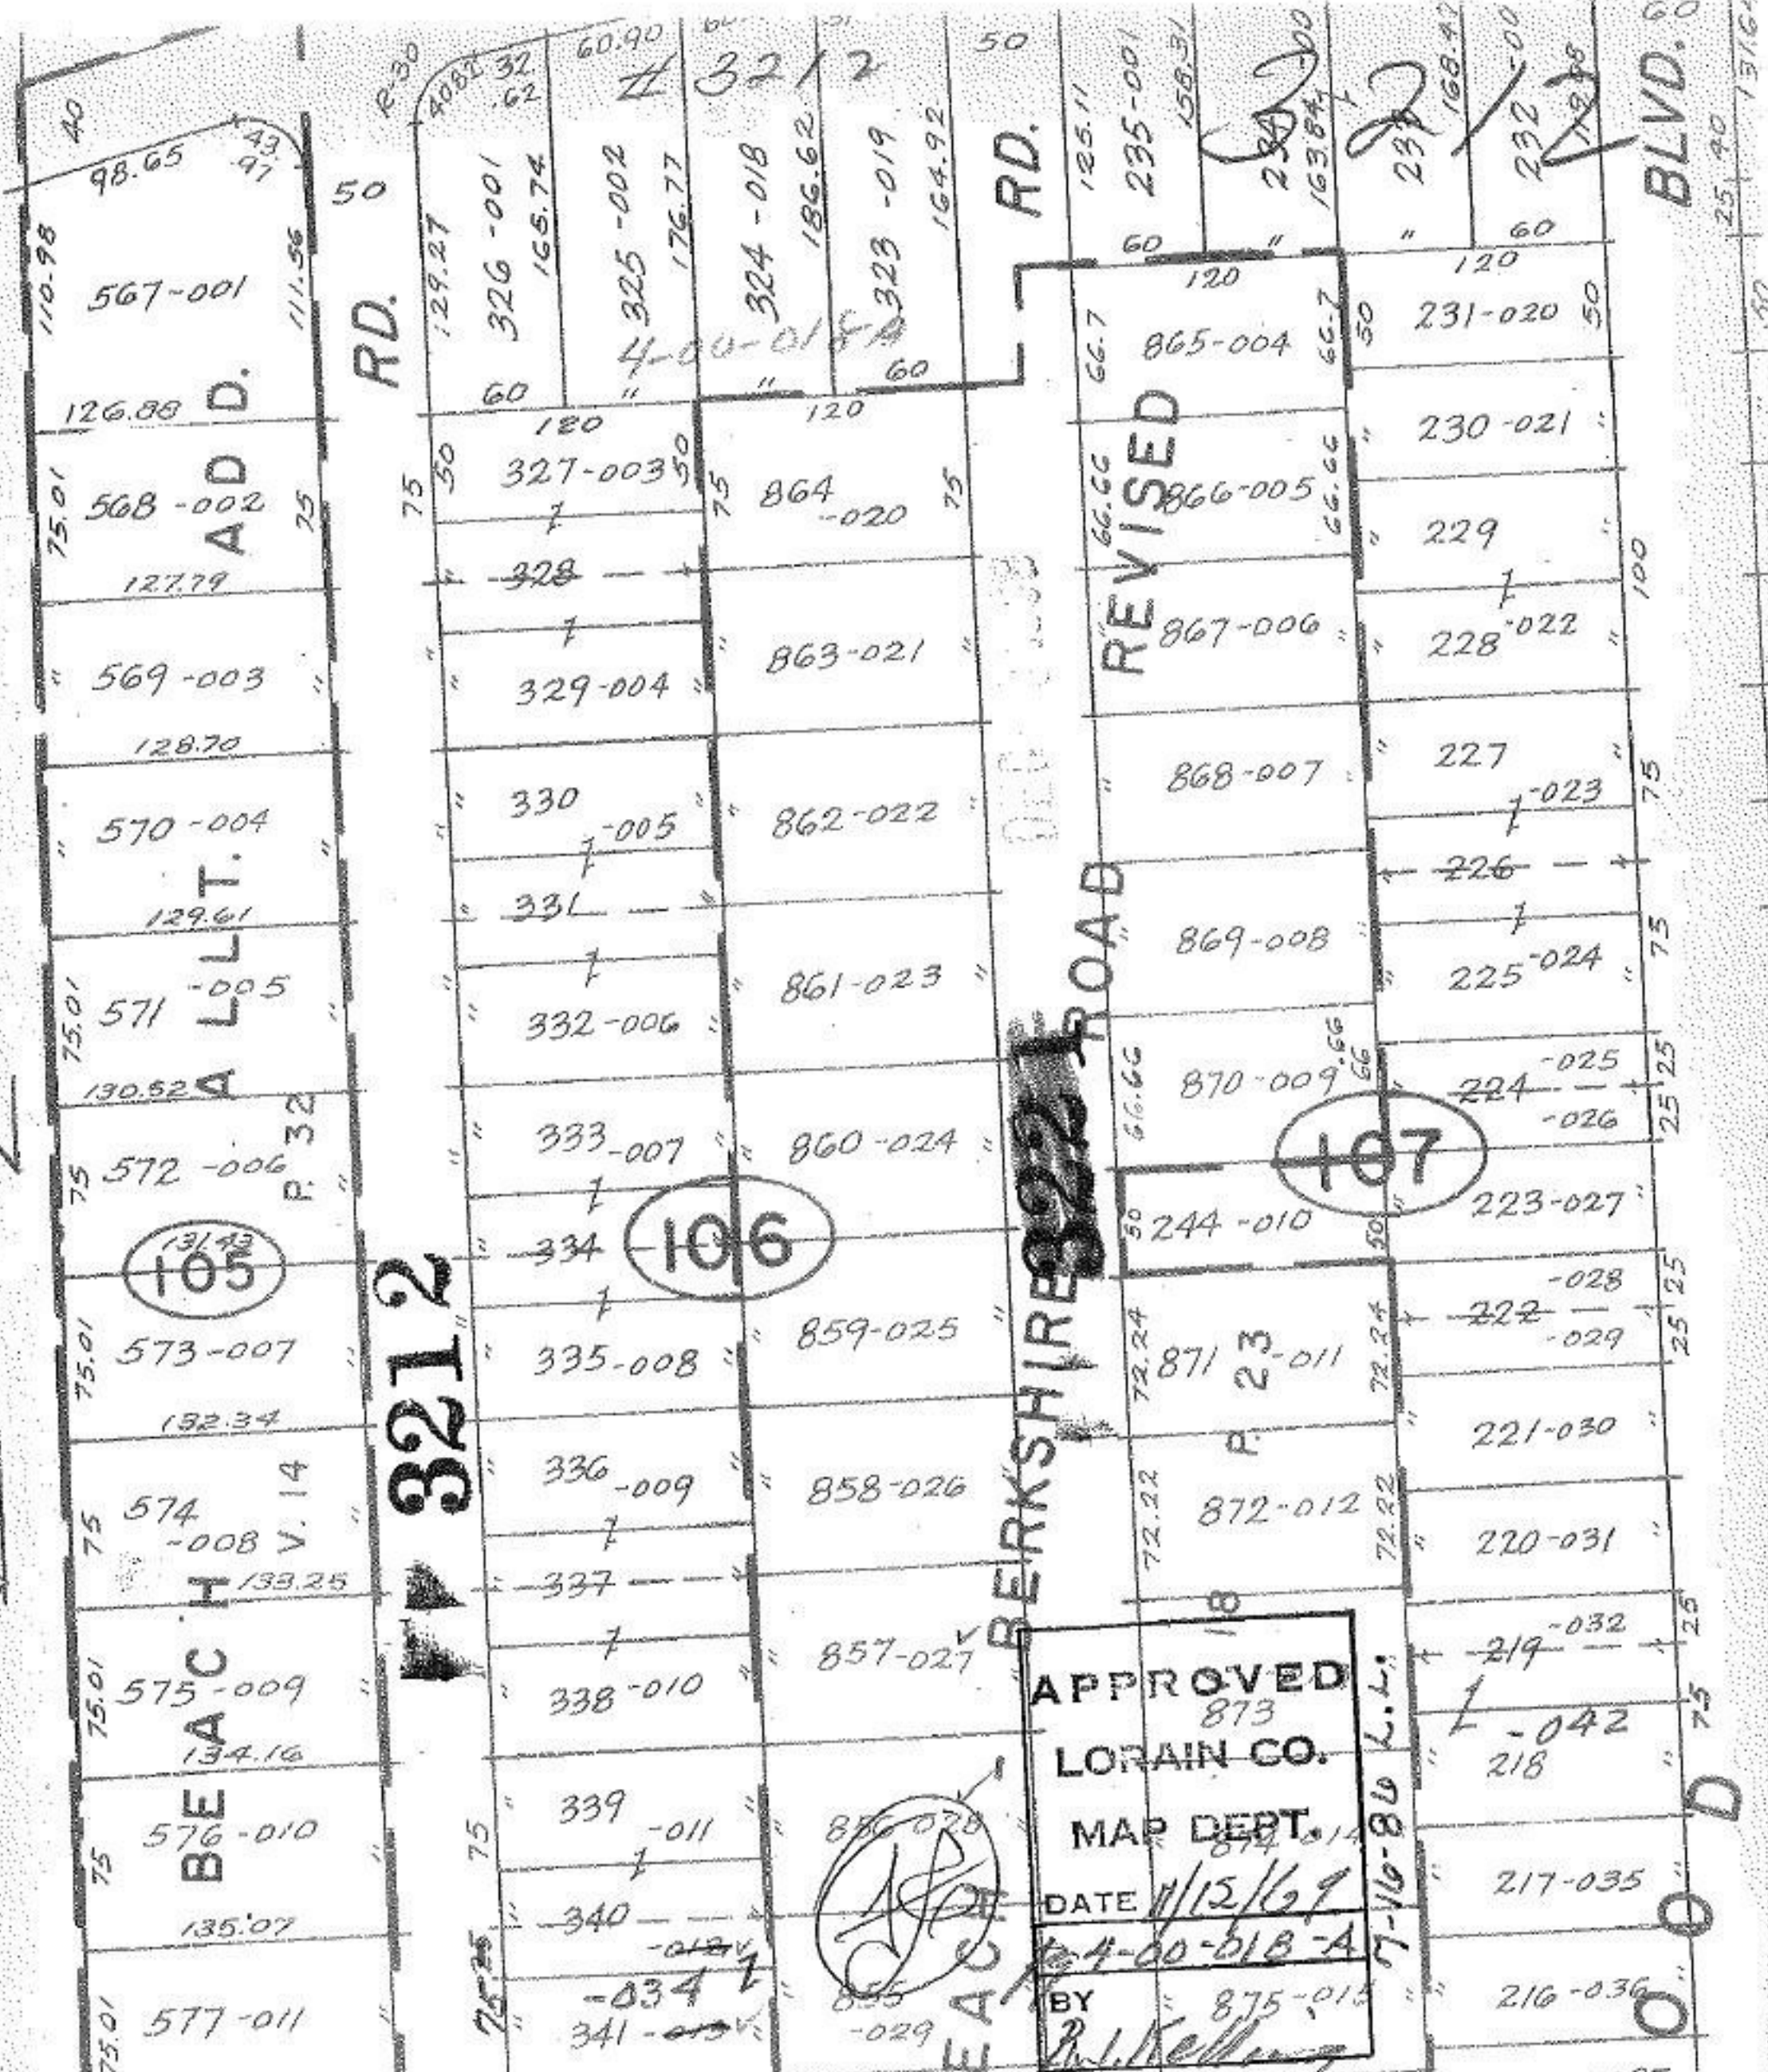

567-001

568-002

569-003

570-004

571-005

572-006

573-007

574-008

575-009

576-010

577-011

326-001

327-003








339-011

340-012

325-002

324-018

863-021

862-022

861-023

860-024

859-025

858-026

857-027

856-028

855-029

865-004

866-005

867-006

868-007

869-008

870-009






231-020

230-021





















105

106

107

APPROVED

LORAIN CO.

MAP DEPT.

DATE 1/15/69

BY P. J. Kellum

3212

BERKSHIRE ROAD

BLVD.

ROAD

REVISED

4-00-018-A

A.D.D.

L.T.

B.E.A.C.H.

B.E.A.C.H.

RD.

RD.

RD.

RD.

ROAD

ROAD

