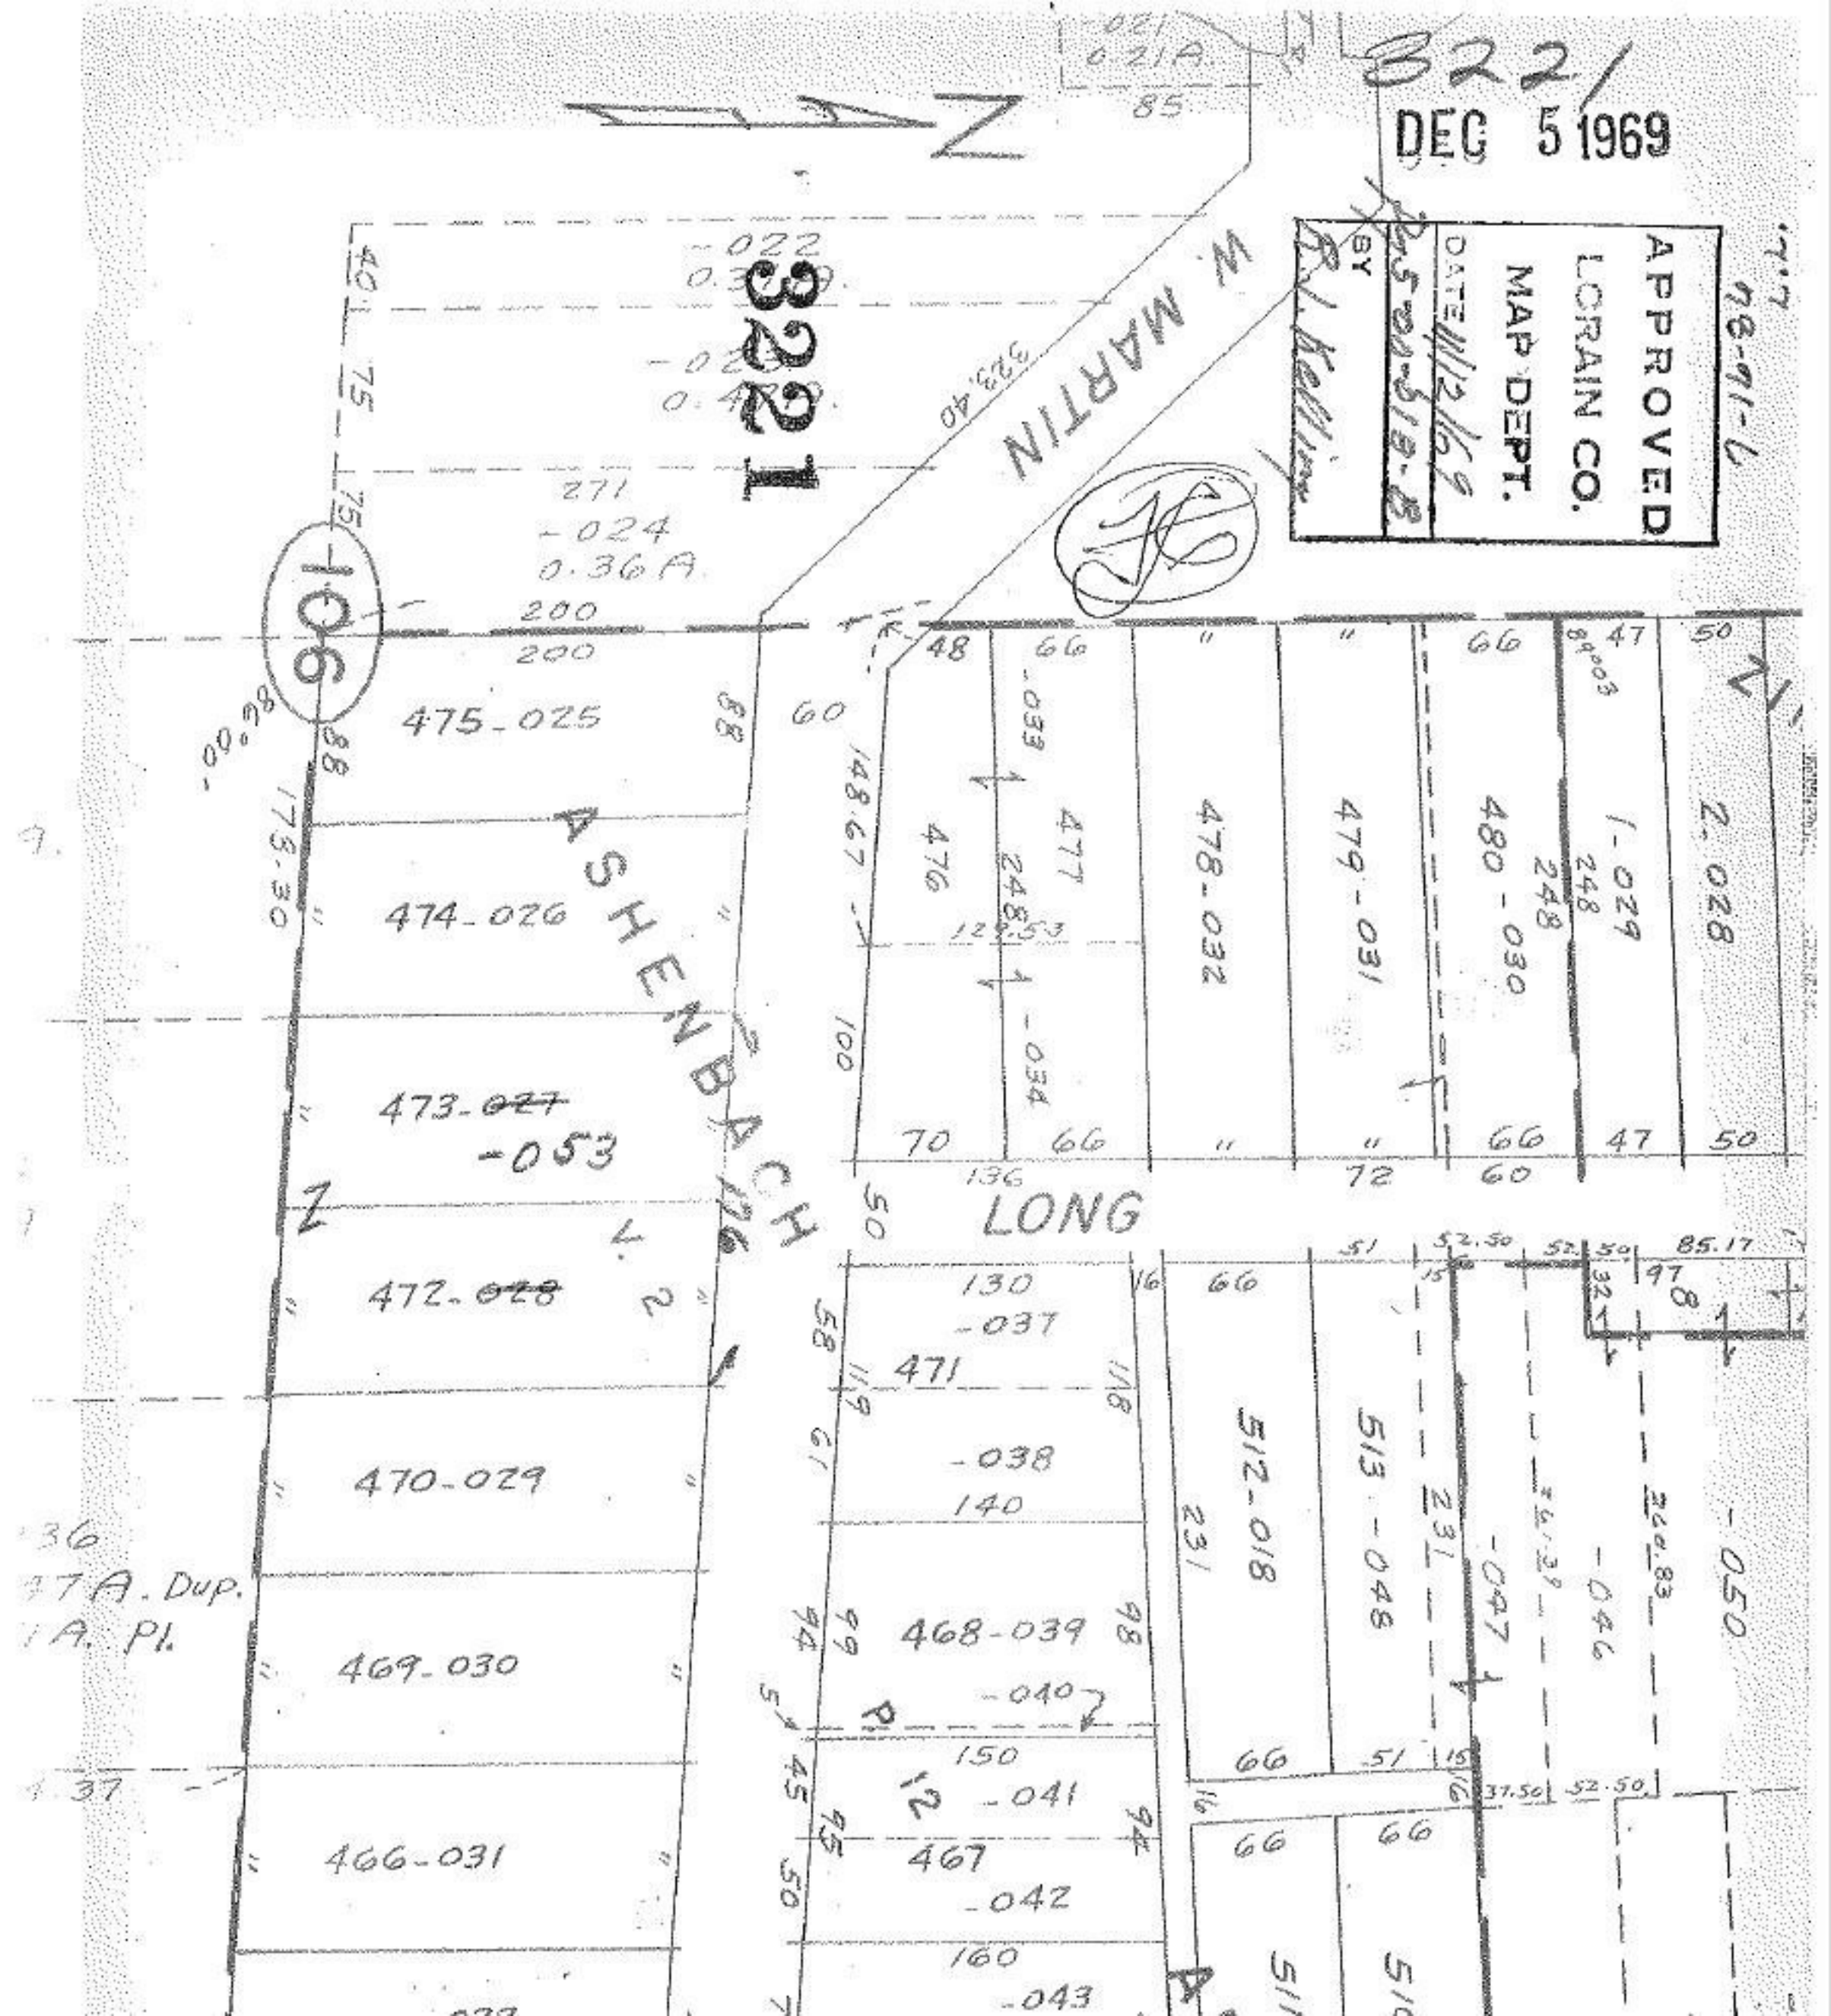

3221
DEC 5 1969
APPROVED
LORAIN CO.
MAP DEPT.
DATE 11/12/69
BY
W. MARTIN
ASHENBACH
LONG
106
3221
475-025
474-026
473-027
-053
472-028
470-029
469-030
466-031
471
468-039
467
-037
-038
-040
-041
-042
-043
512-018
513-048
-047
-046
-050
476
477
478-032
479-031
480-030
1-029
2-028