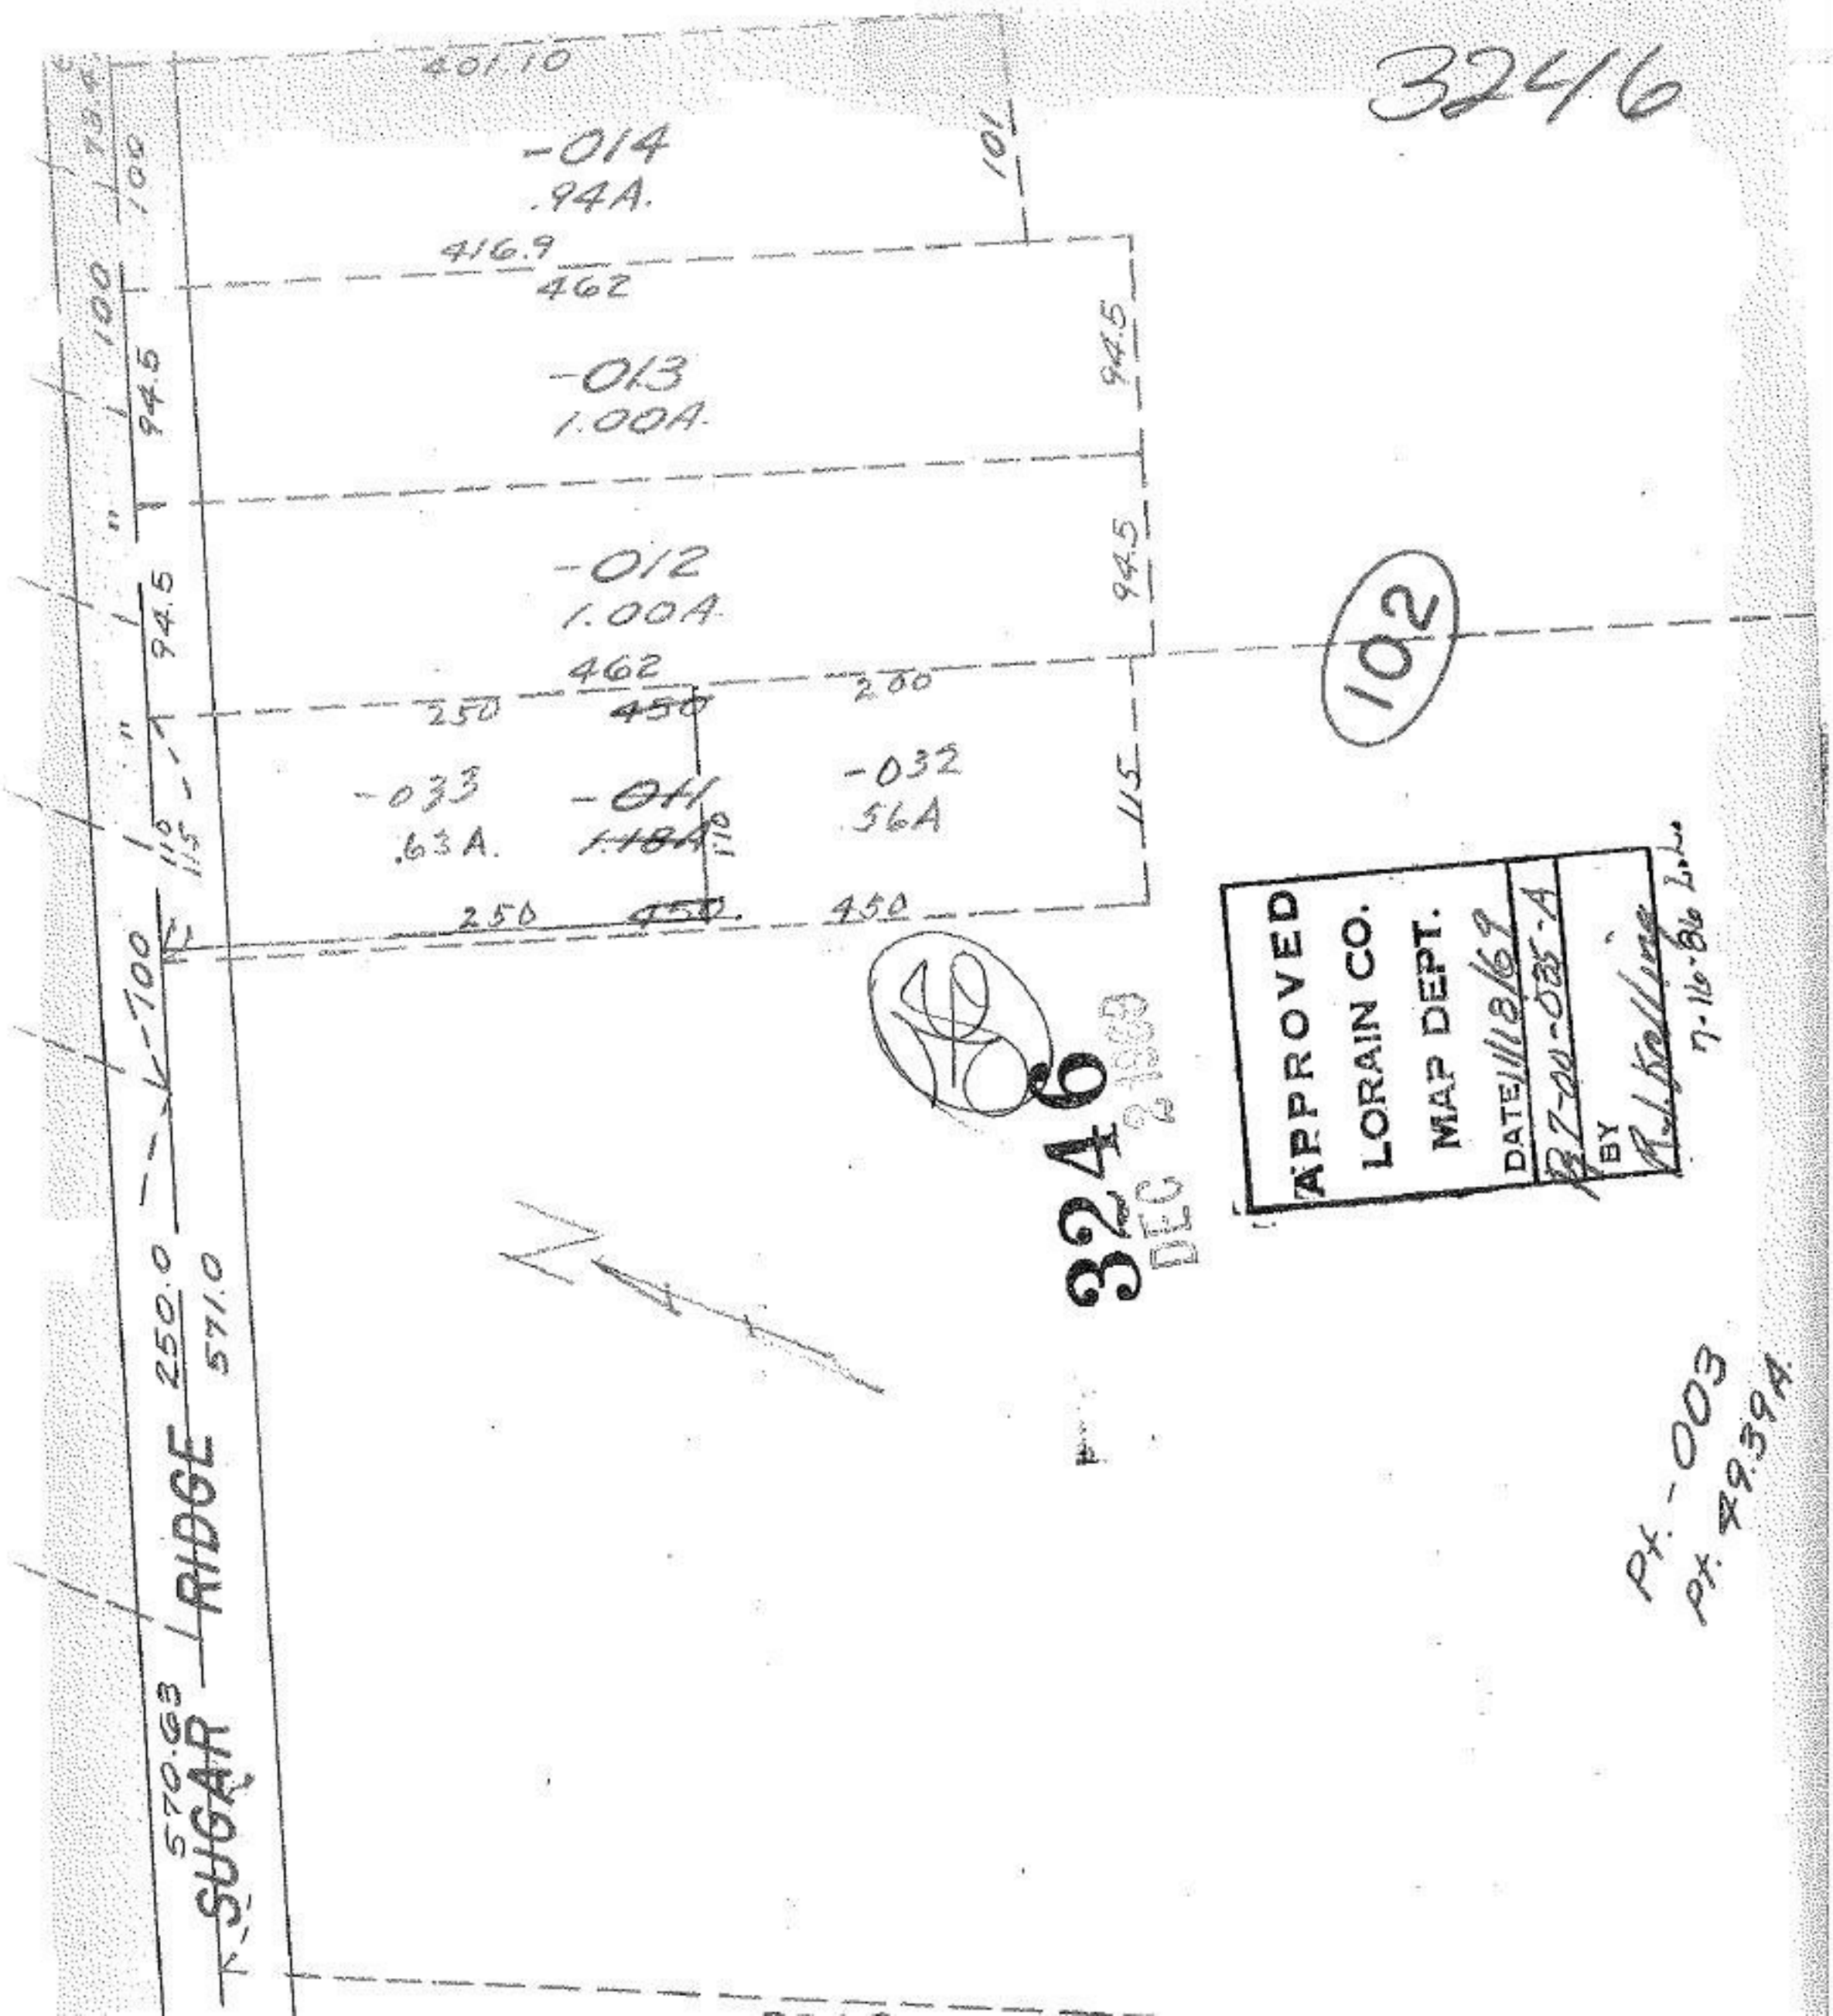
3246
401.10
-014
.94A.
101
416.9
462
-013
1.00A.
94.5
-012
1.00A.
462
250
450
200
-033
.63A.
-011
1.18A
-032
.56A
115
110
250
450
450
102
SUGAR RIDGE
570.63
250.0
571.0
APPROVED
LORAIN CO.
MAP DEPT.
DATE 11/18/69
BY
7-16-86
Pt. -003
Pt. 49.39A.
3246
DEC 2 1986