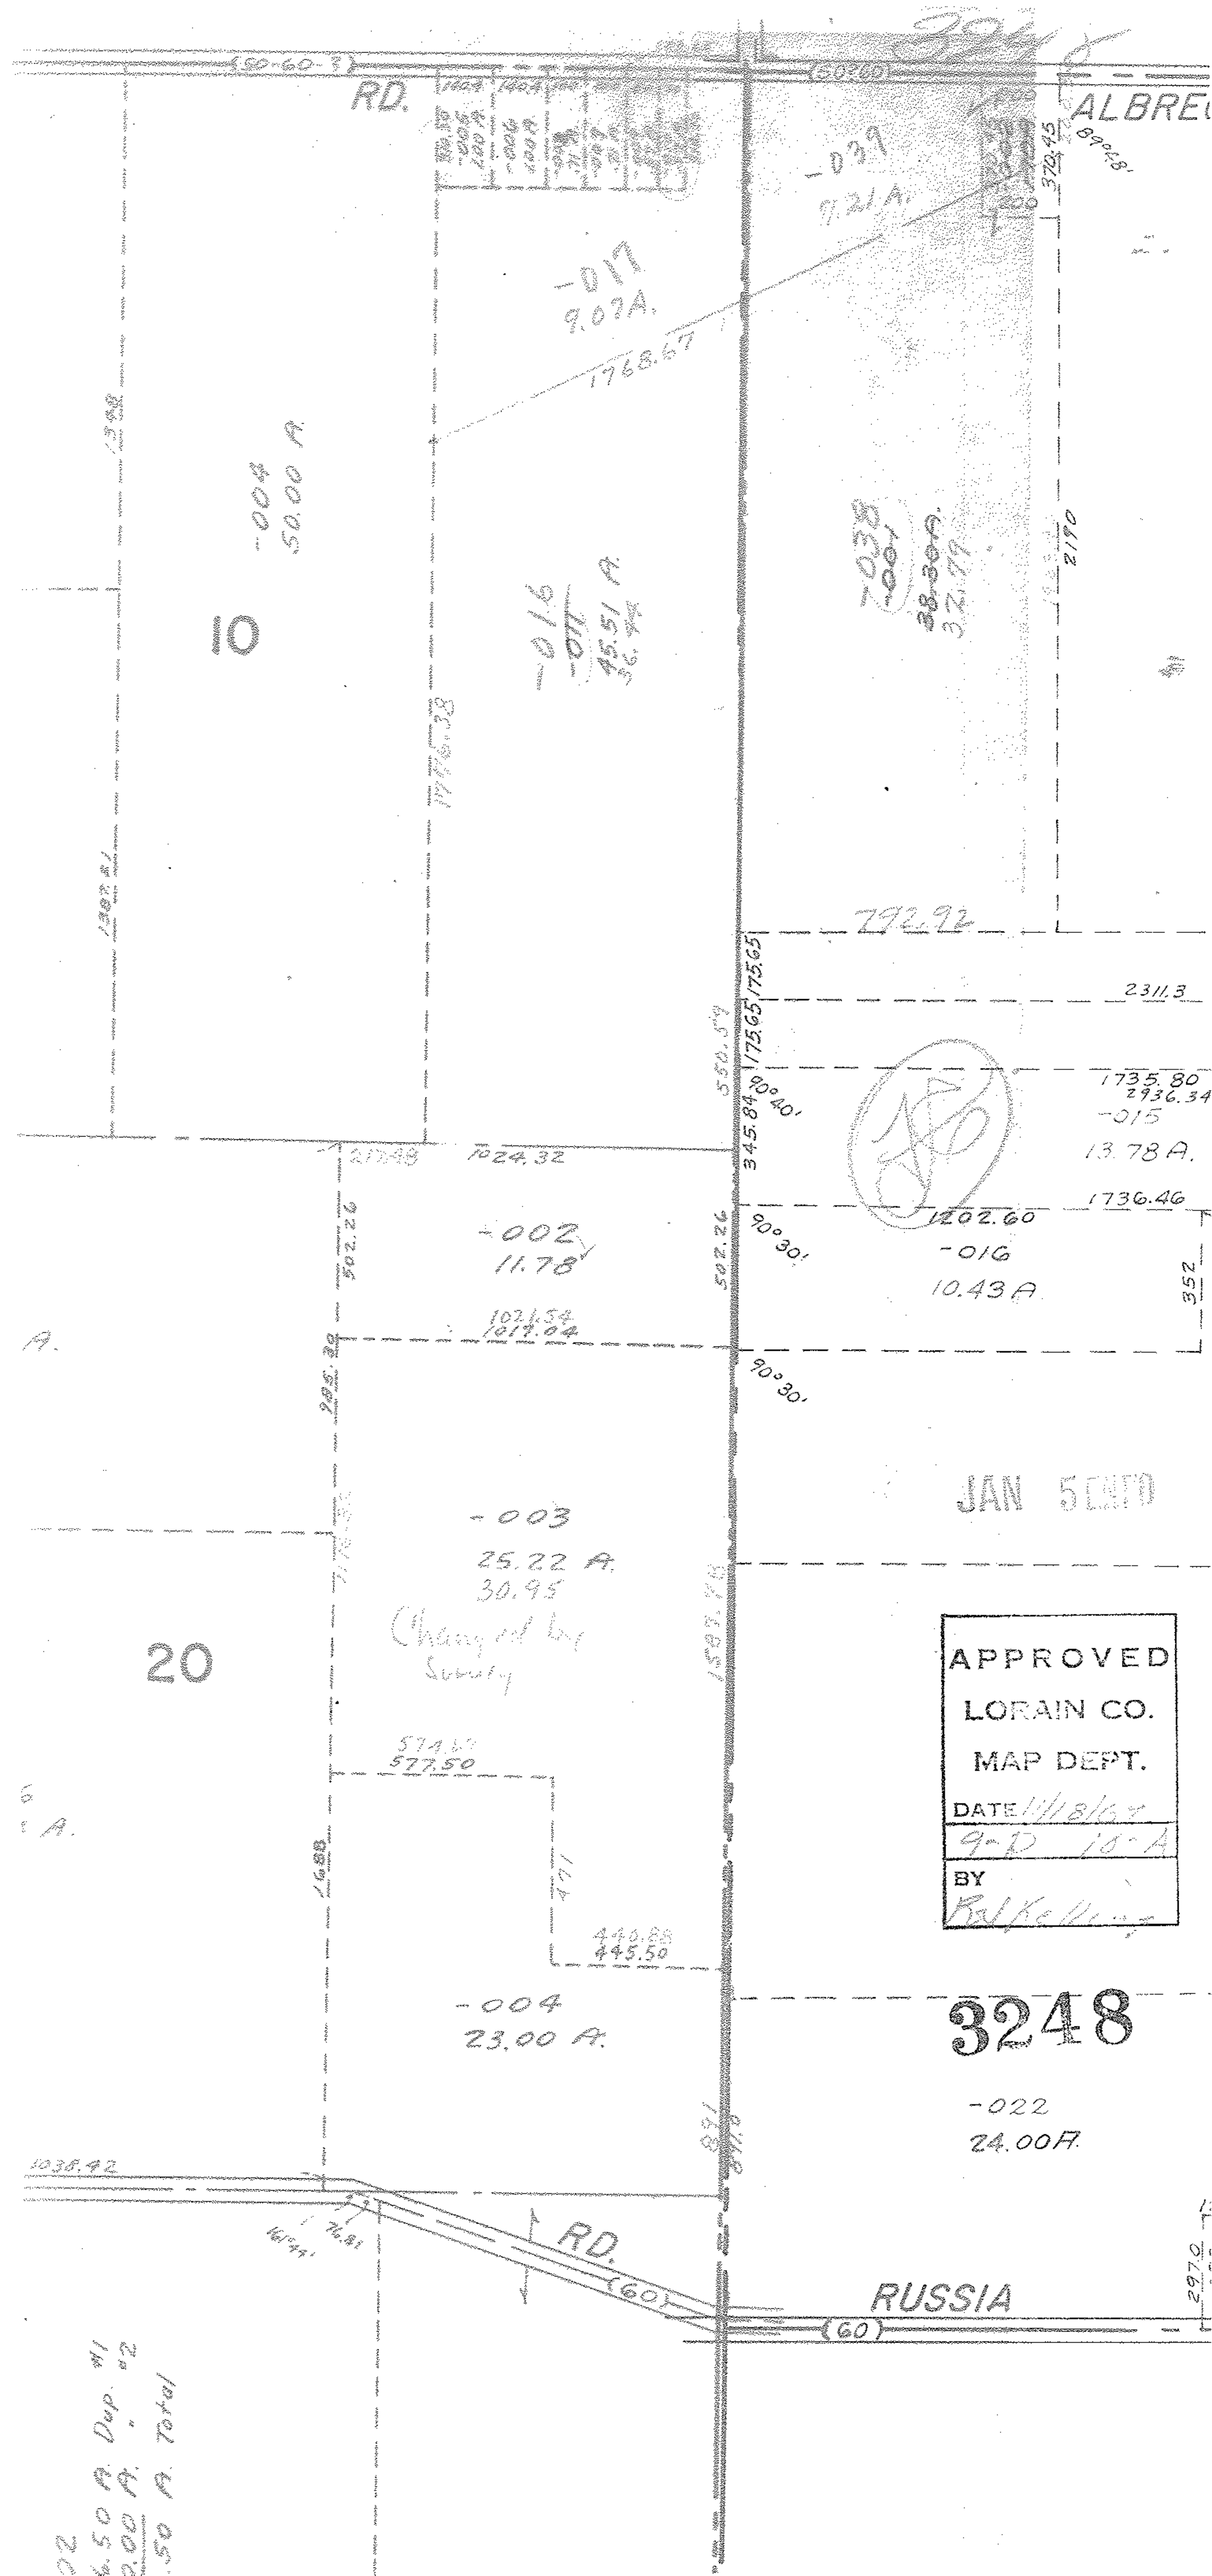
RD.
ALBRE
-039
9.21 A.
-017
9.07 A.
1768.67
-004
50.00 A.
10
-016
-011
45.51 A.
-038
-001
38.30 A.
32.77
2180
1398.81
1398.81
1776.38
792.92
2311.3
1735.80
2936.34
-015
13.78 A.
1736.46
1202.60
345.84
90°40'
550.59
175.65
175.65
1024.32
502.26
-002
11.78
1021.54
1019.04
502.26
90°30'
-016
10.43 A
352
90°30'
JAN 5 CNTD
-003
25.22 A.
30.95
Change of by Survey
20
574.50
577.50
1488
471
440.88
445.50
-004
23.00 A.
3248
-022
24.00 A.
1038.42
76.81
146°44'
RD.
(60)
RUSSIA
(60)
APPROVED
LORAIN CO.
MAP DEPT.
DATE 11/18/02
9-D 10-A
BY