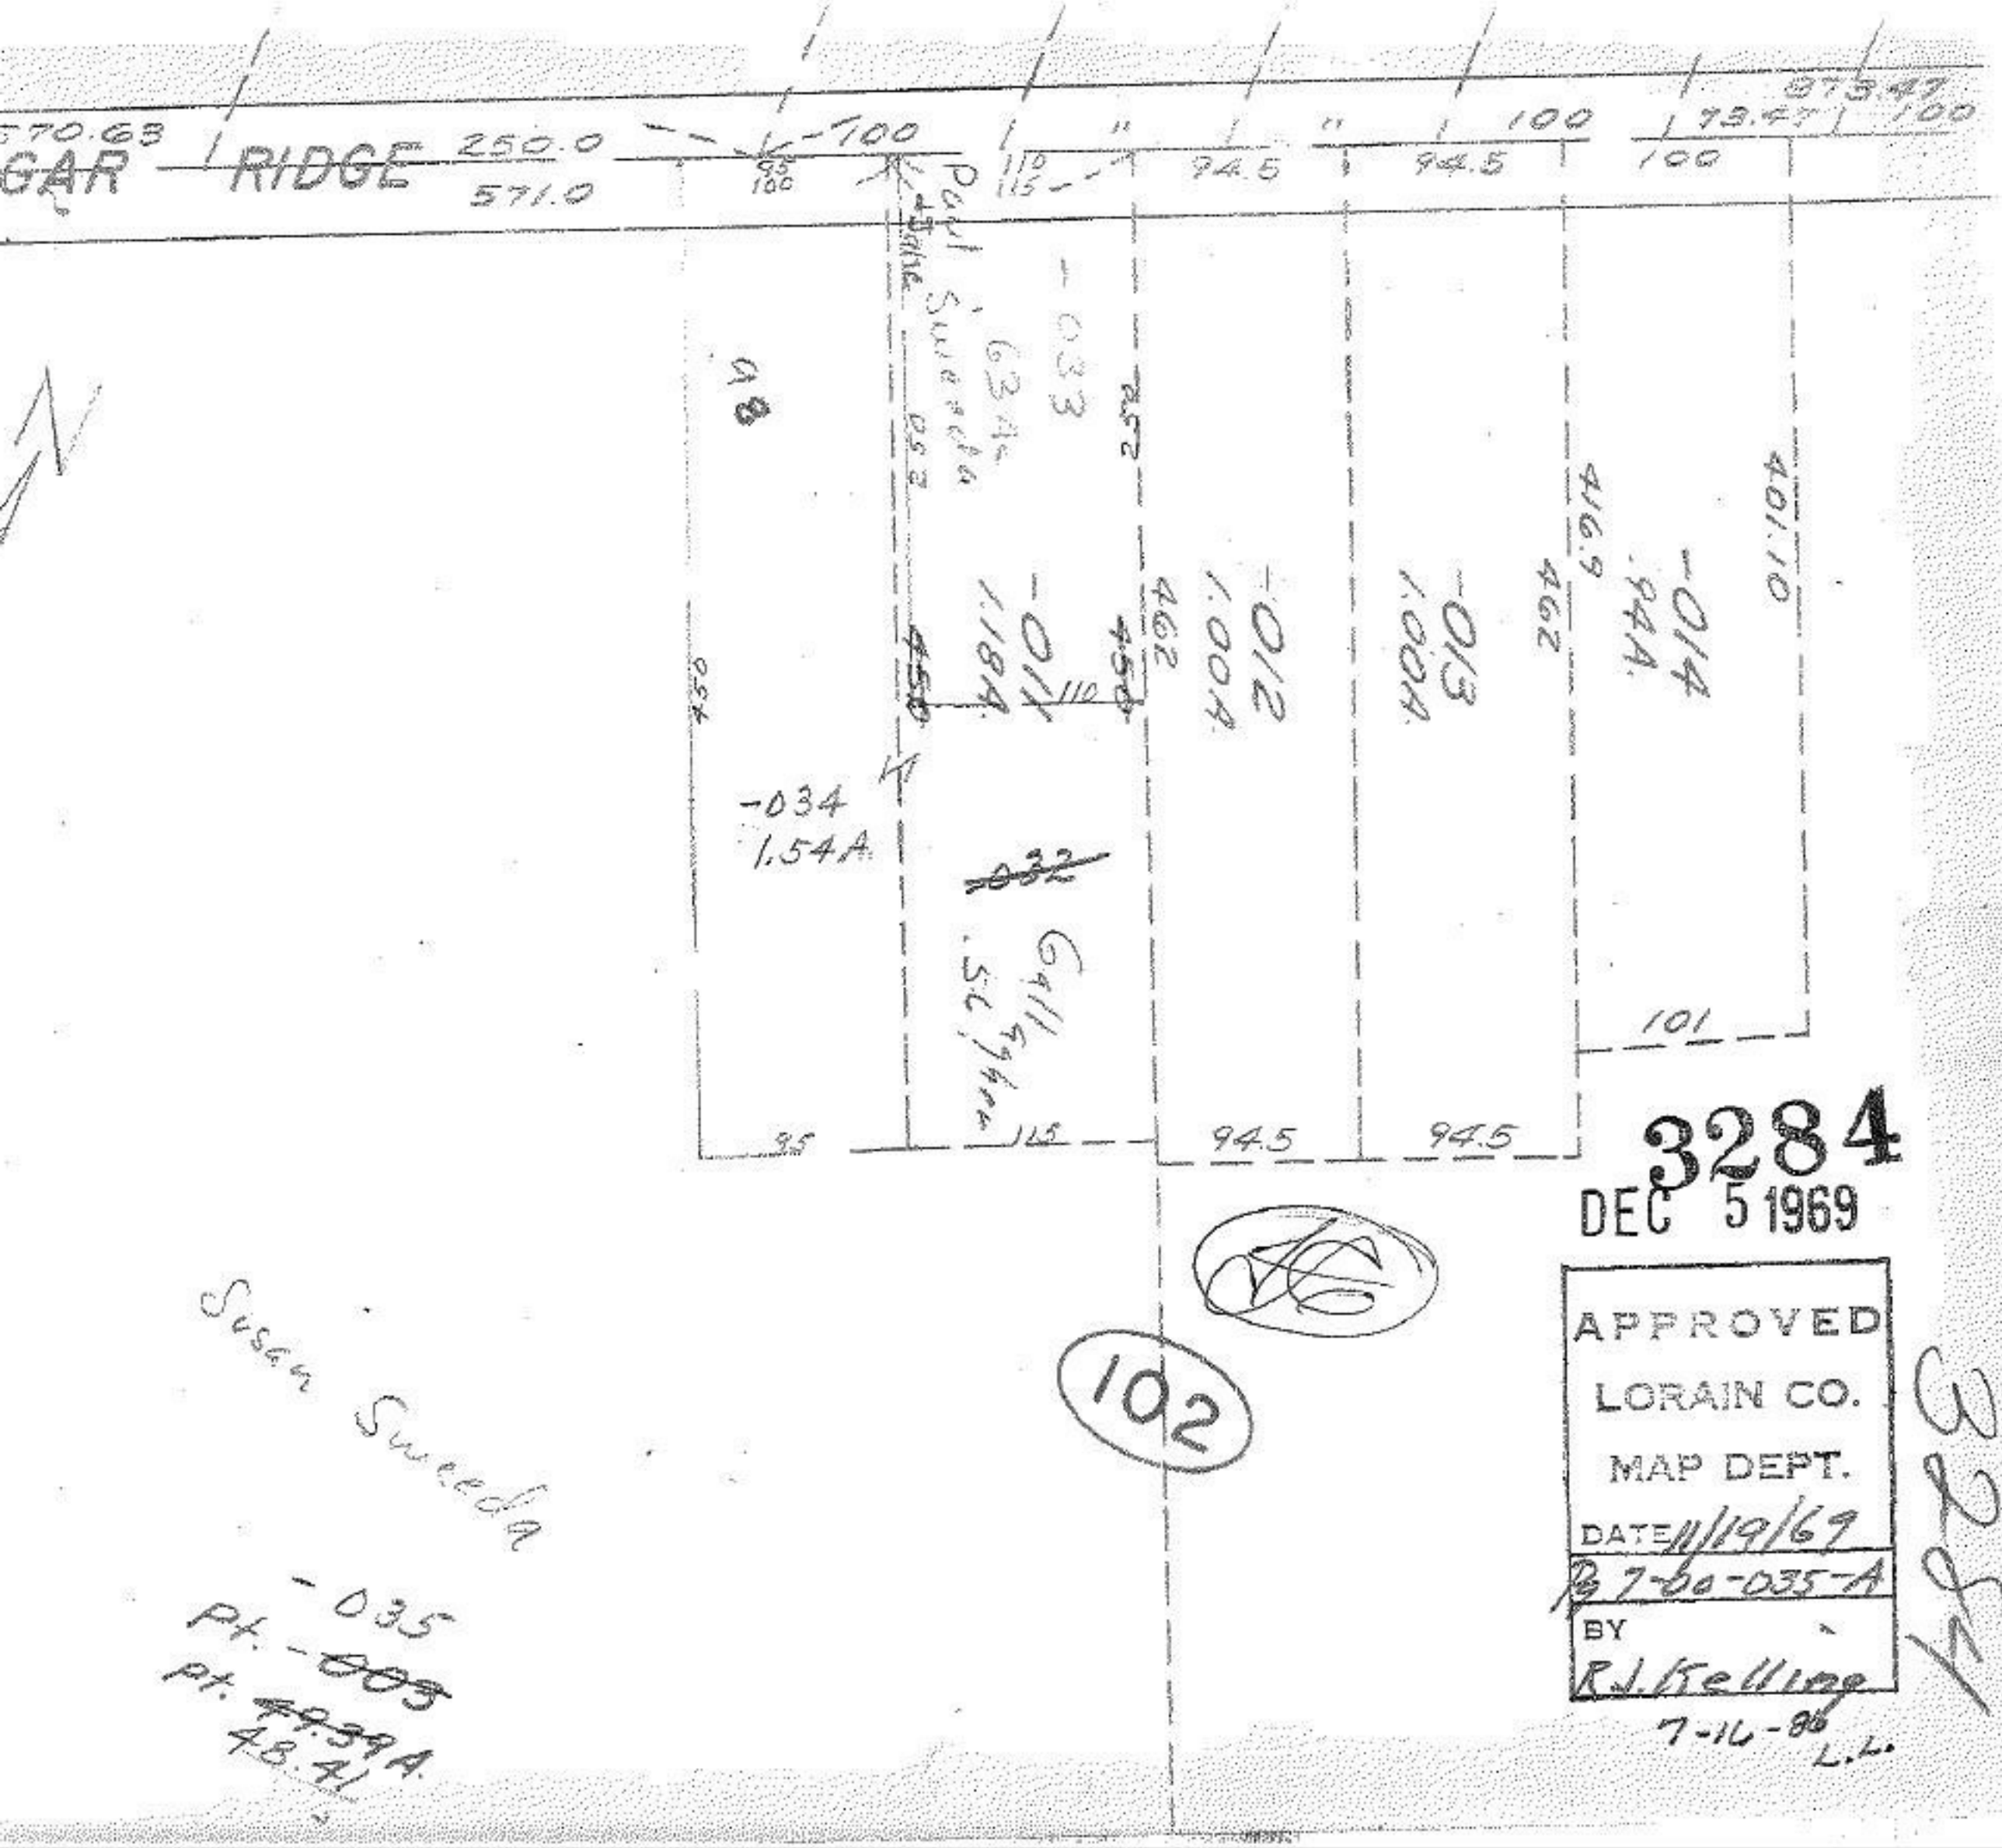

570.63
GAR RIDGE
250.0
571.0
100
94.5
94.5
100
73.47
100
873.47
Paul Sweeda
63A
-033
252
98
-011
1.18A
450
462
-012
1.00A
-013
1.00A
416.9
462
-014
.94A
401.10
-034
1.54A
~~-032~~
101
95
115
94.5
94.5
3284
DEC 5 1969
APPROVED
LORAIN CO.
MAP DEPT.
DATE 11/19/69
Pg 7-00-035-A
BY
R.J. Kelling
7-16-86
L.L.
102
Susan Sweeda
-035
Pt. ~~-003~~
Pt. ~~49.39~~ A.
48.41