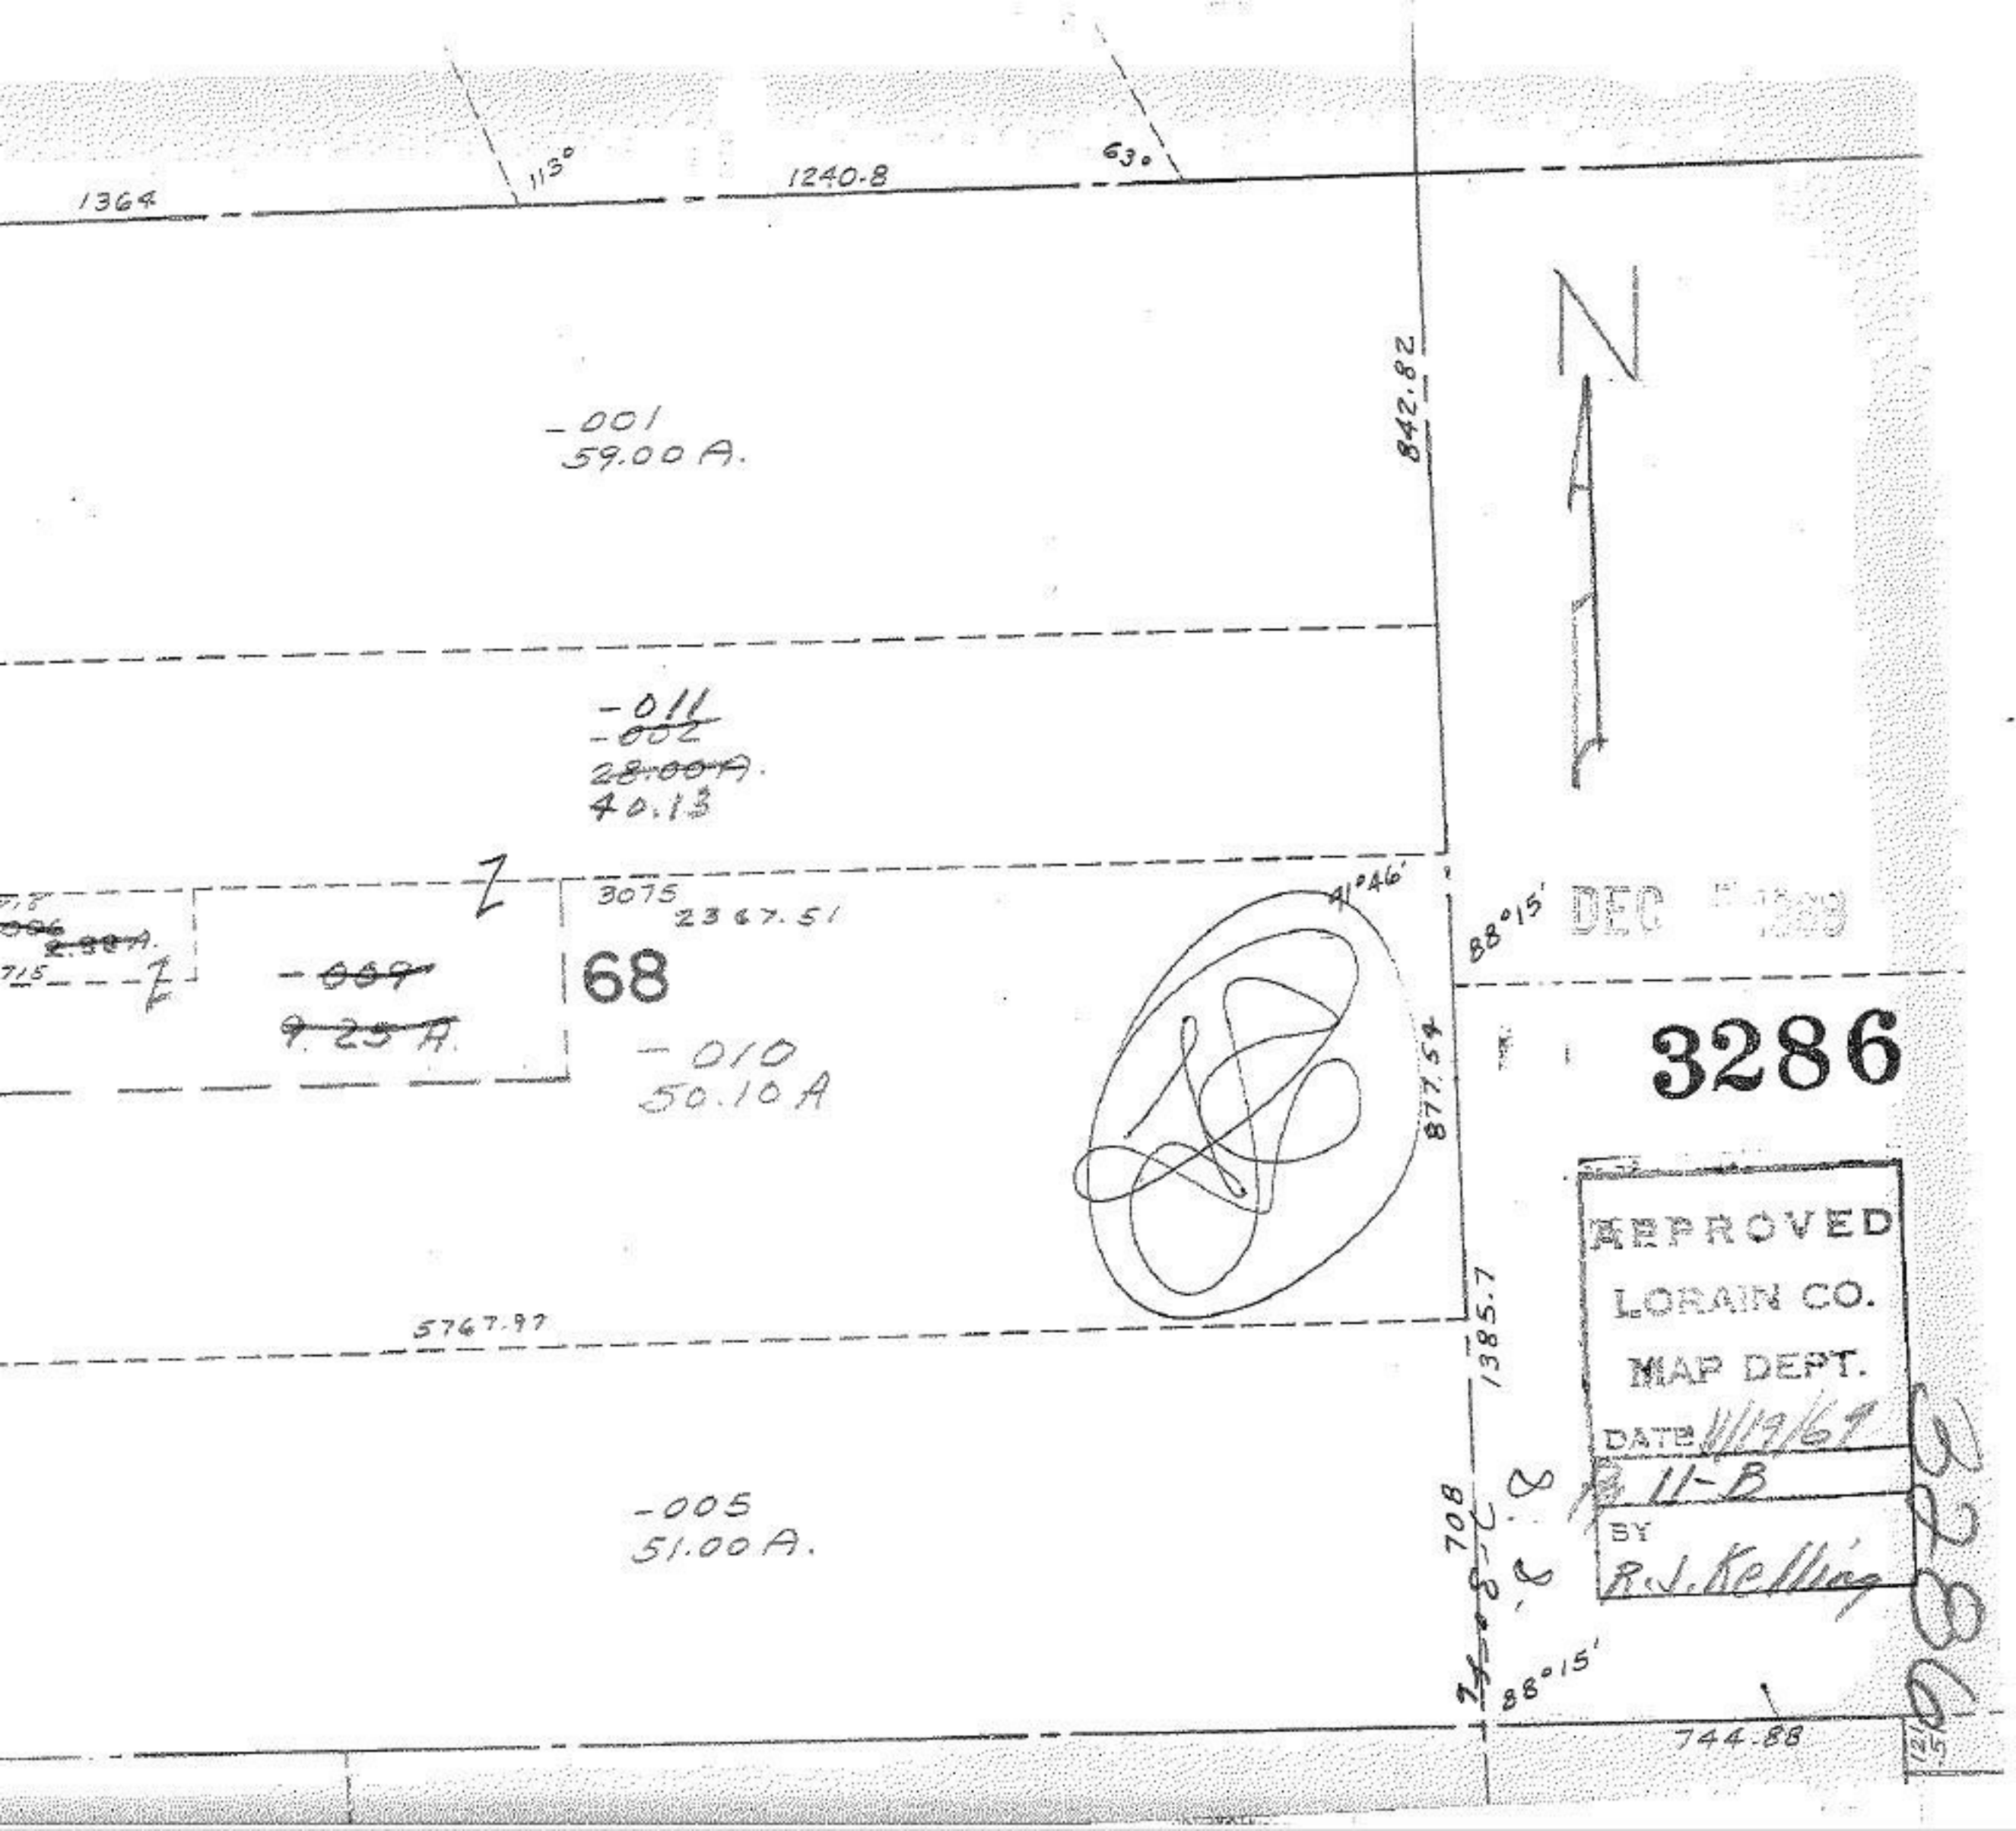
1364
113°
1240.8
63°
842.82
N
-001
59.00 A.
-011
-002
28.00 A.
40.13
Z
3075
2367.51
68
-009
9.25 A.
-010
50.10 A
41°46'
88°15'
DEC
3286
877.54
5767.97
1385.7
-005
51.00 A.
708
88°15'
744.88
APPROVED
LORAIN CO.
MAP DEPT.
DATE 11/19/69
11-B
BY
R.J. Kelling
3286