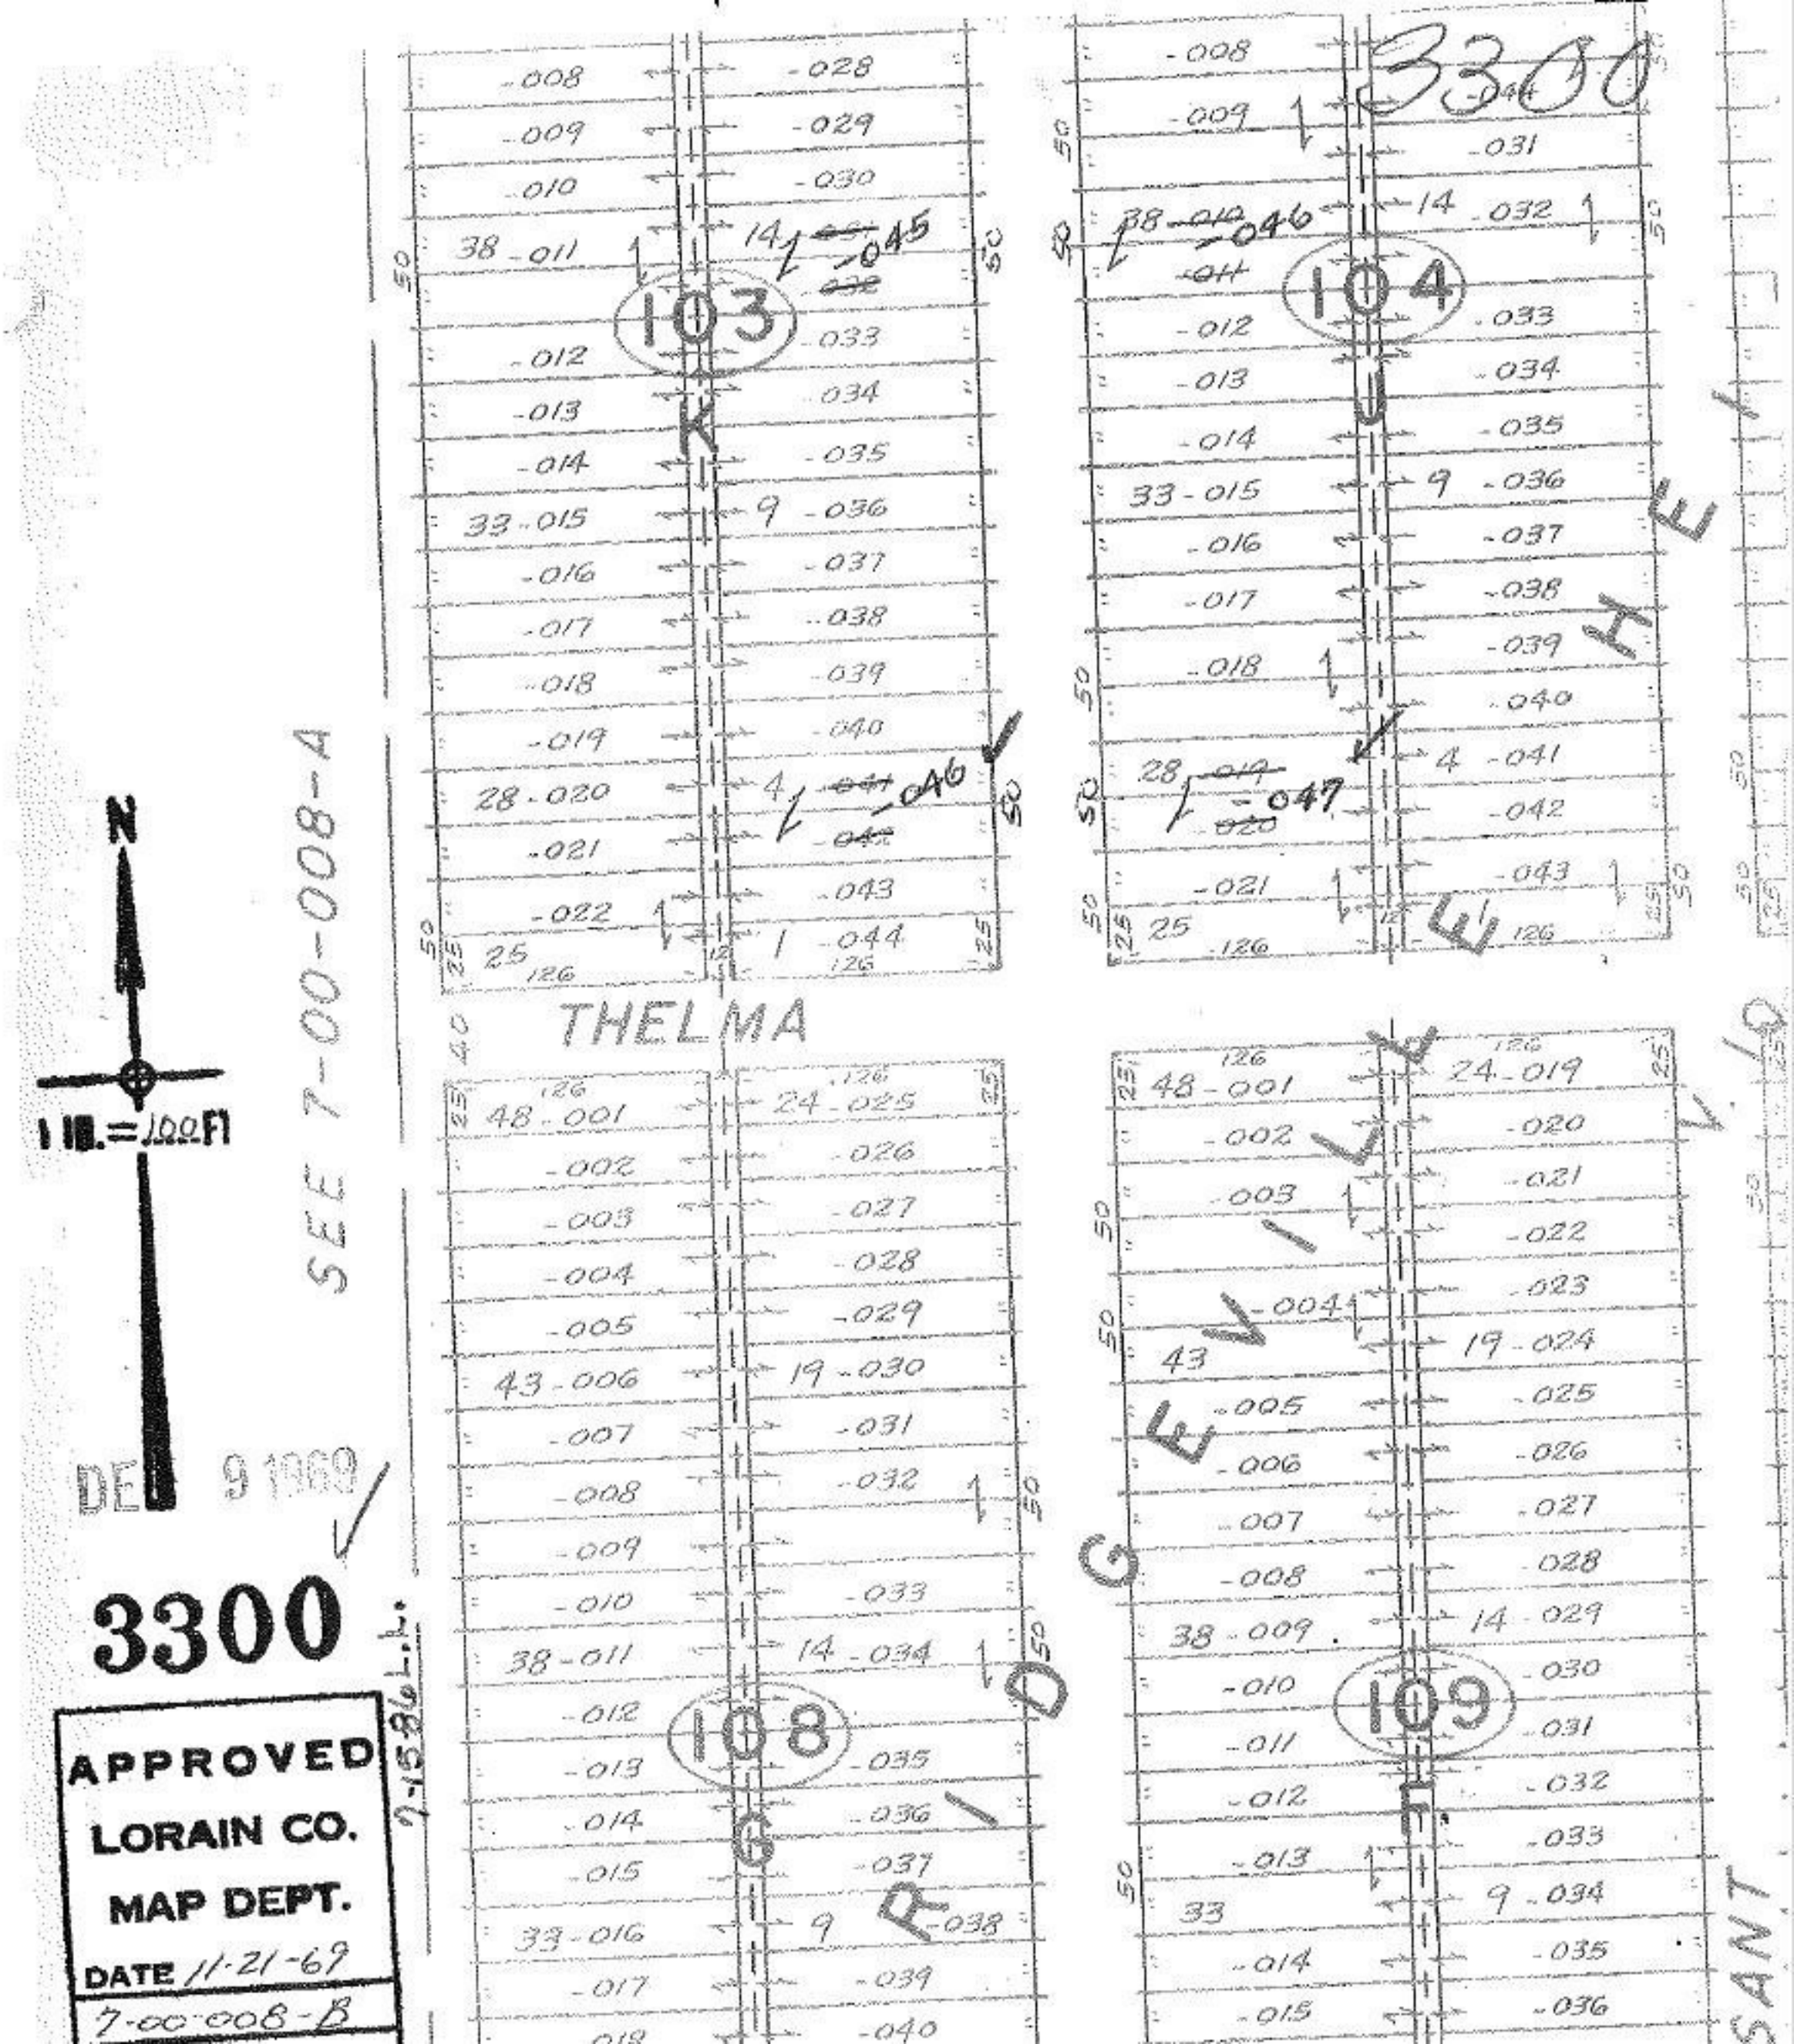
3300
103
104
108
109
K
J
H
E
G
R
D
F
E
THELMA
SEE 7-00-008-A
1 IN.=100 FT
N
DEC 9 1969
3300
APPROVED
LORAIN CO.
MAP DEPT.
DATE 11-21-69
7-00-008-B
7-15-86 L.L.