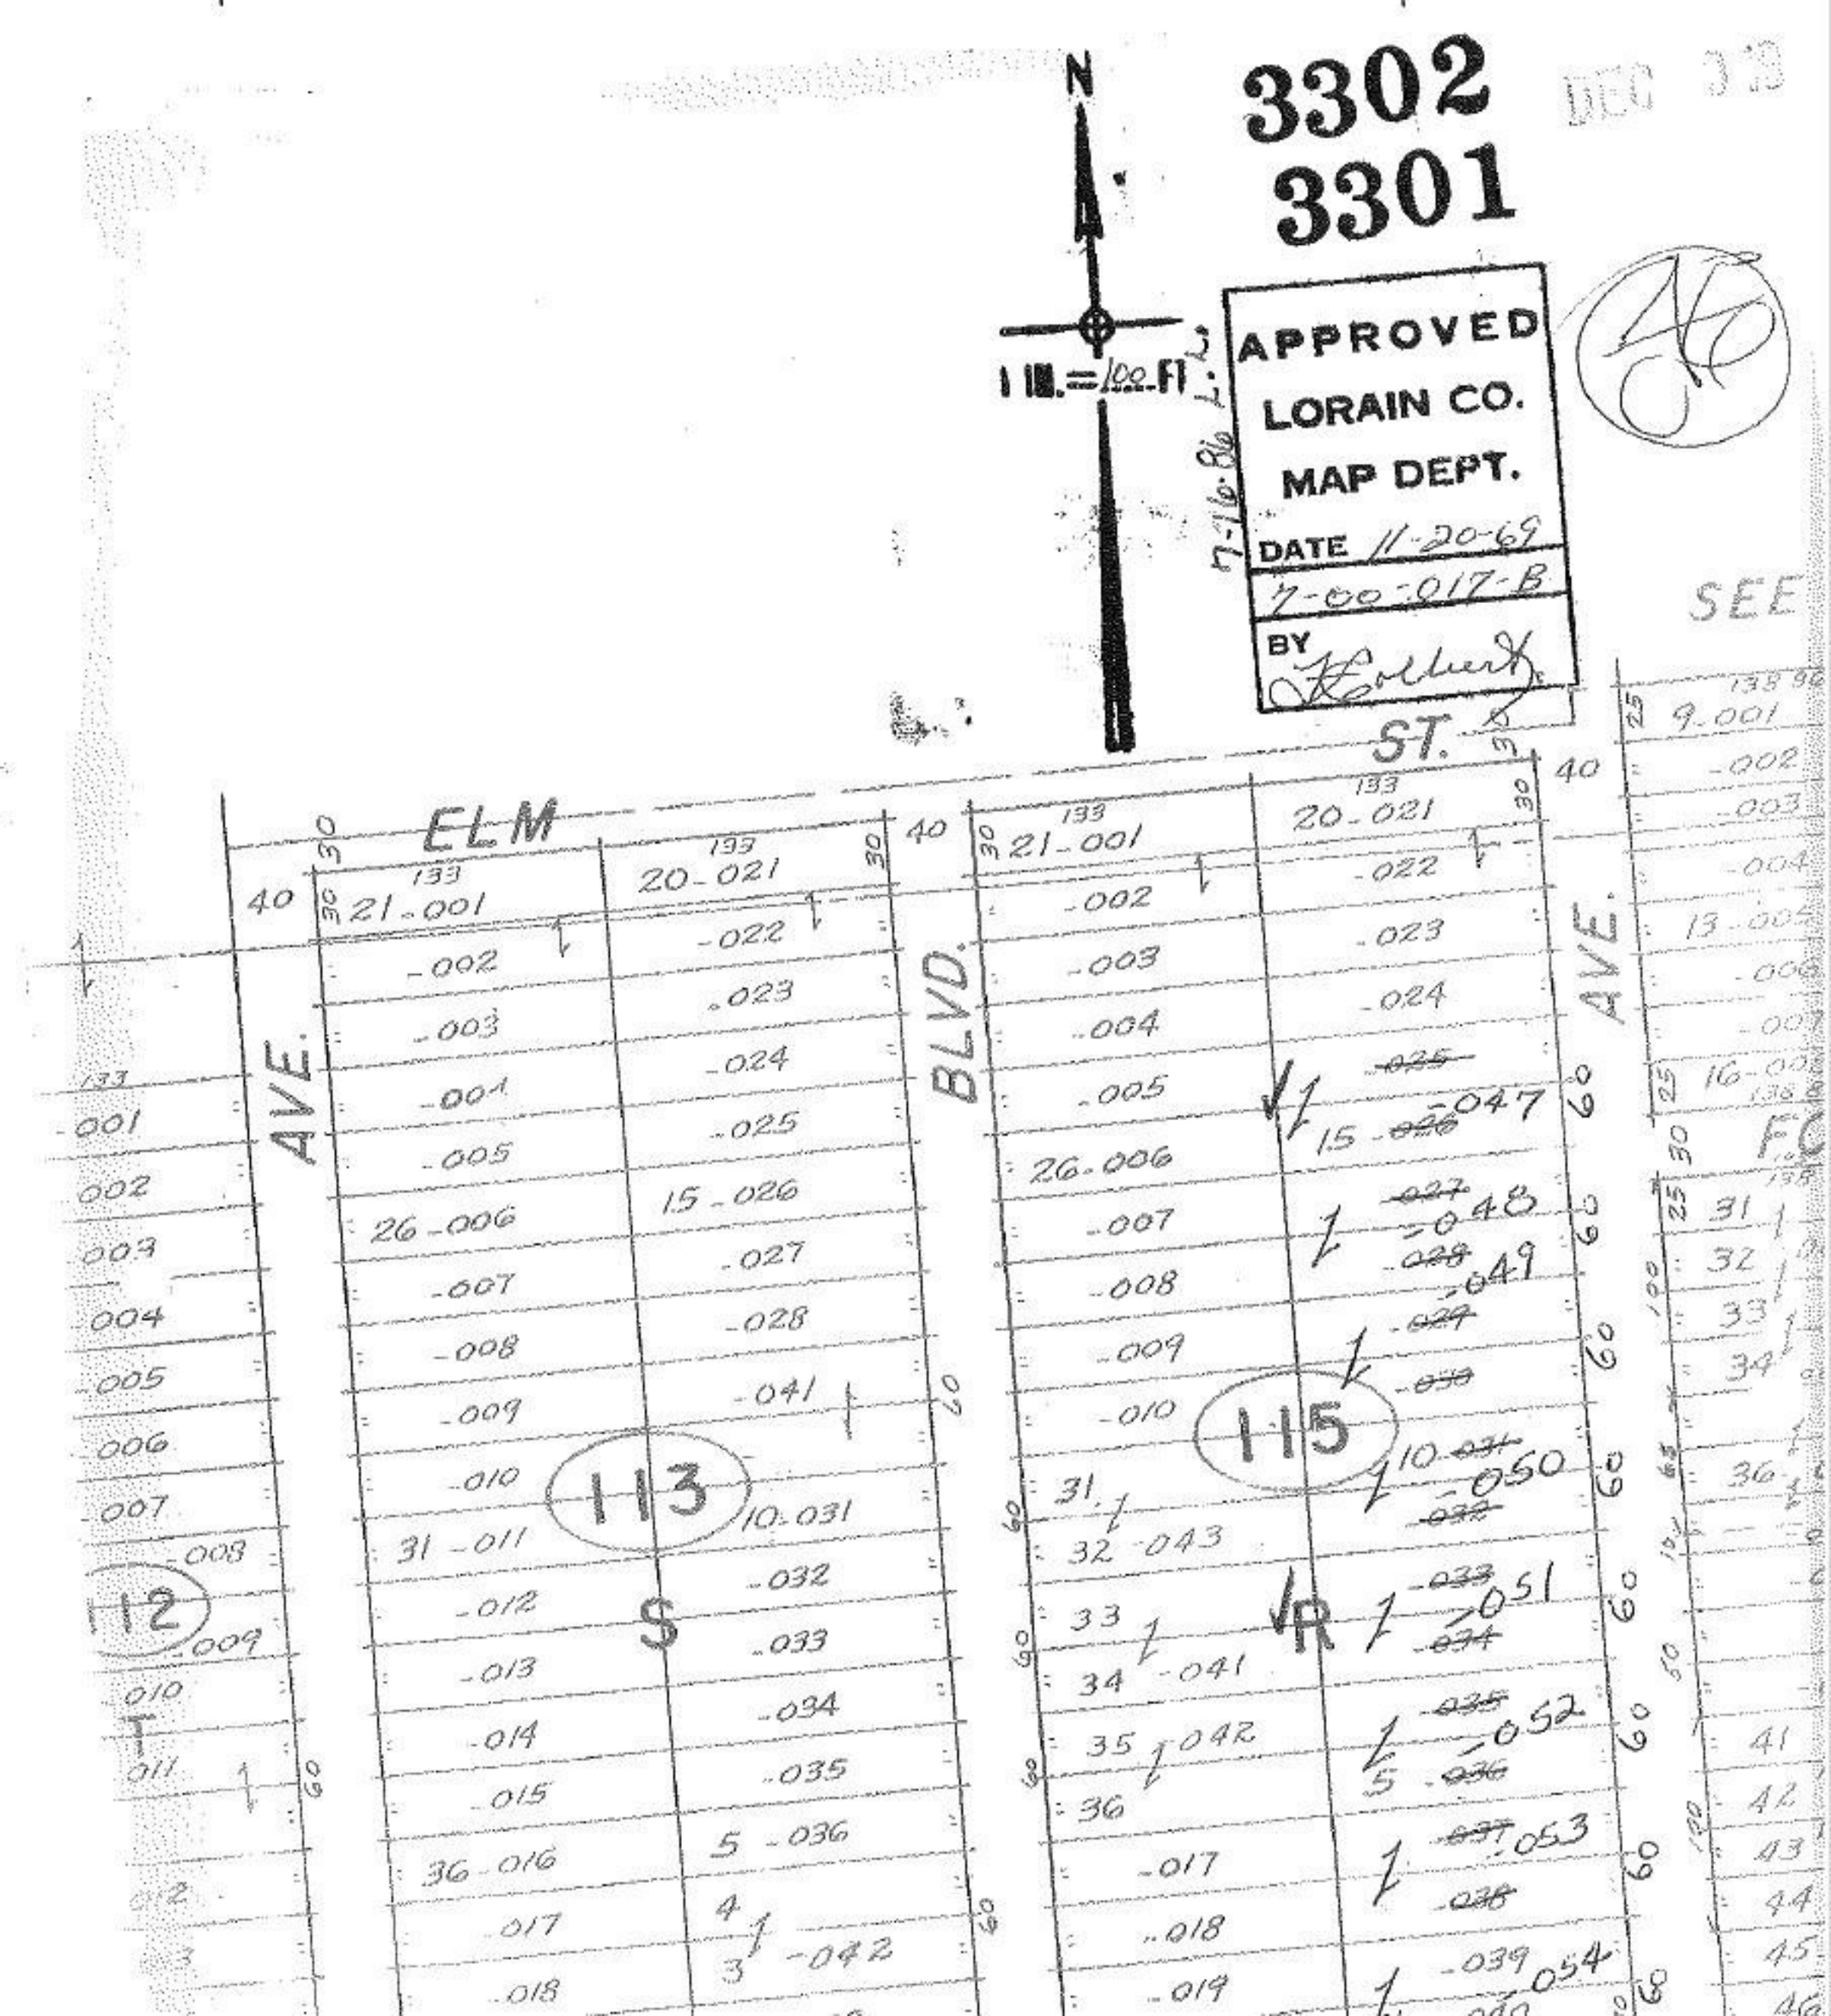

3302
3301
N
1 IN. = 100 FT
APPROVED
LORAIN CO.
MAP DEPT.
DATE 11-20-69
7-00-017-B
BY
7-16-86 L.L.
ELM
AVE.
BLVD.
ST.
AVE.
SEE
113
115
112
S
R