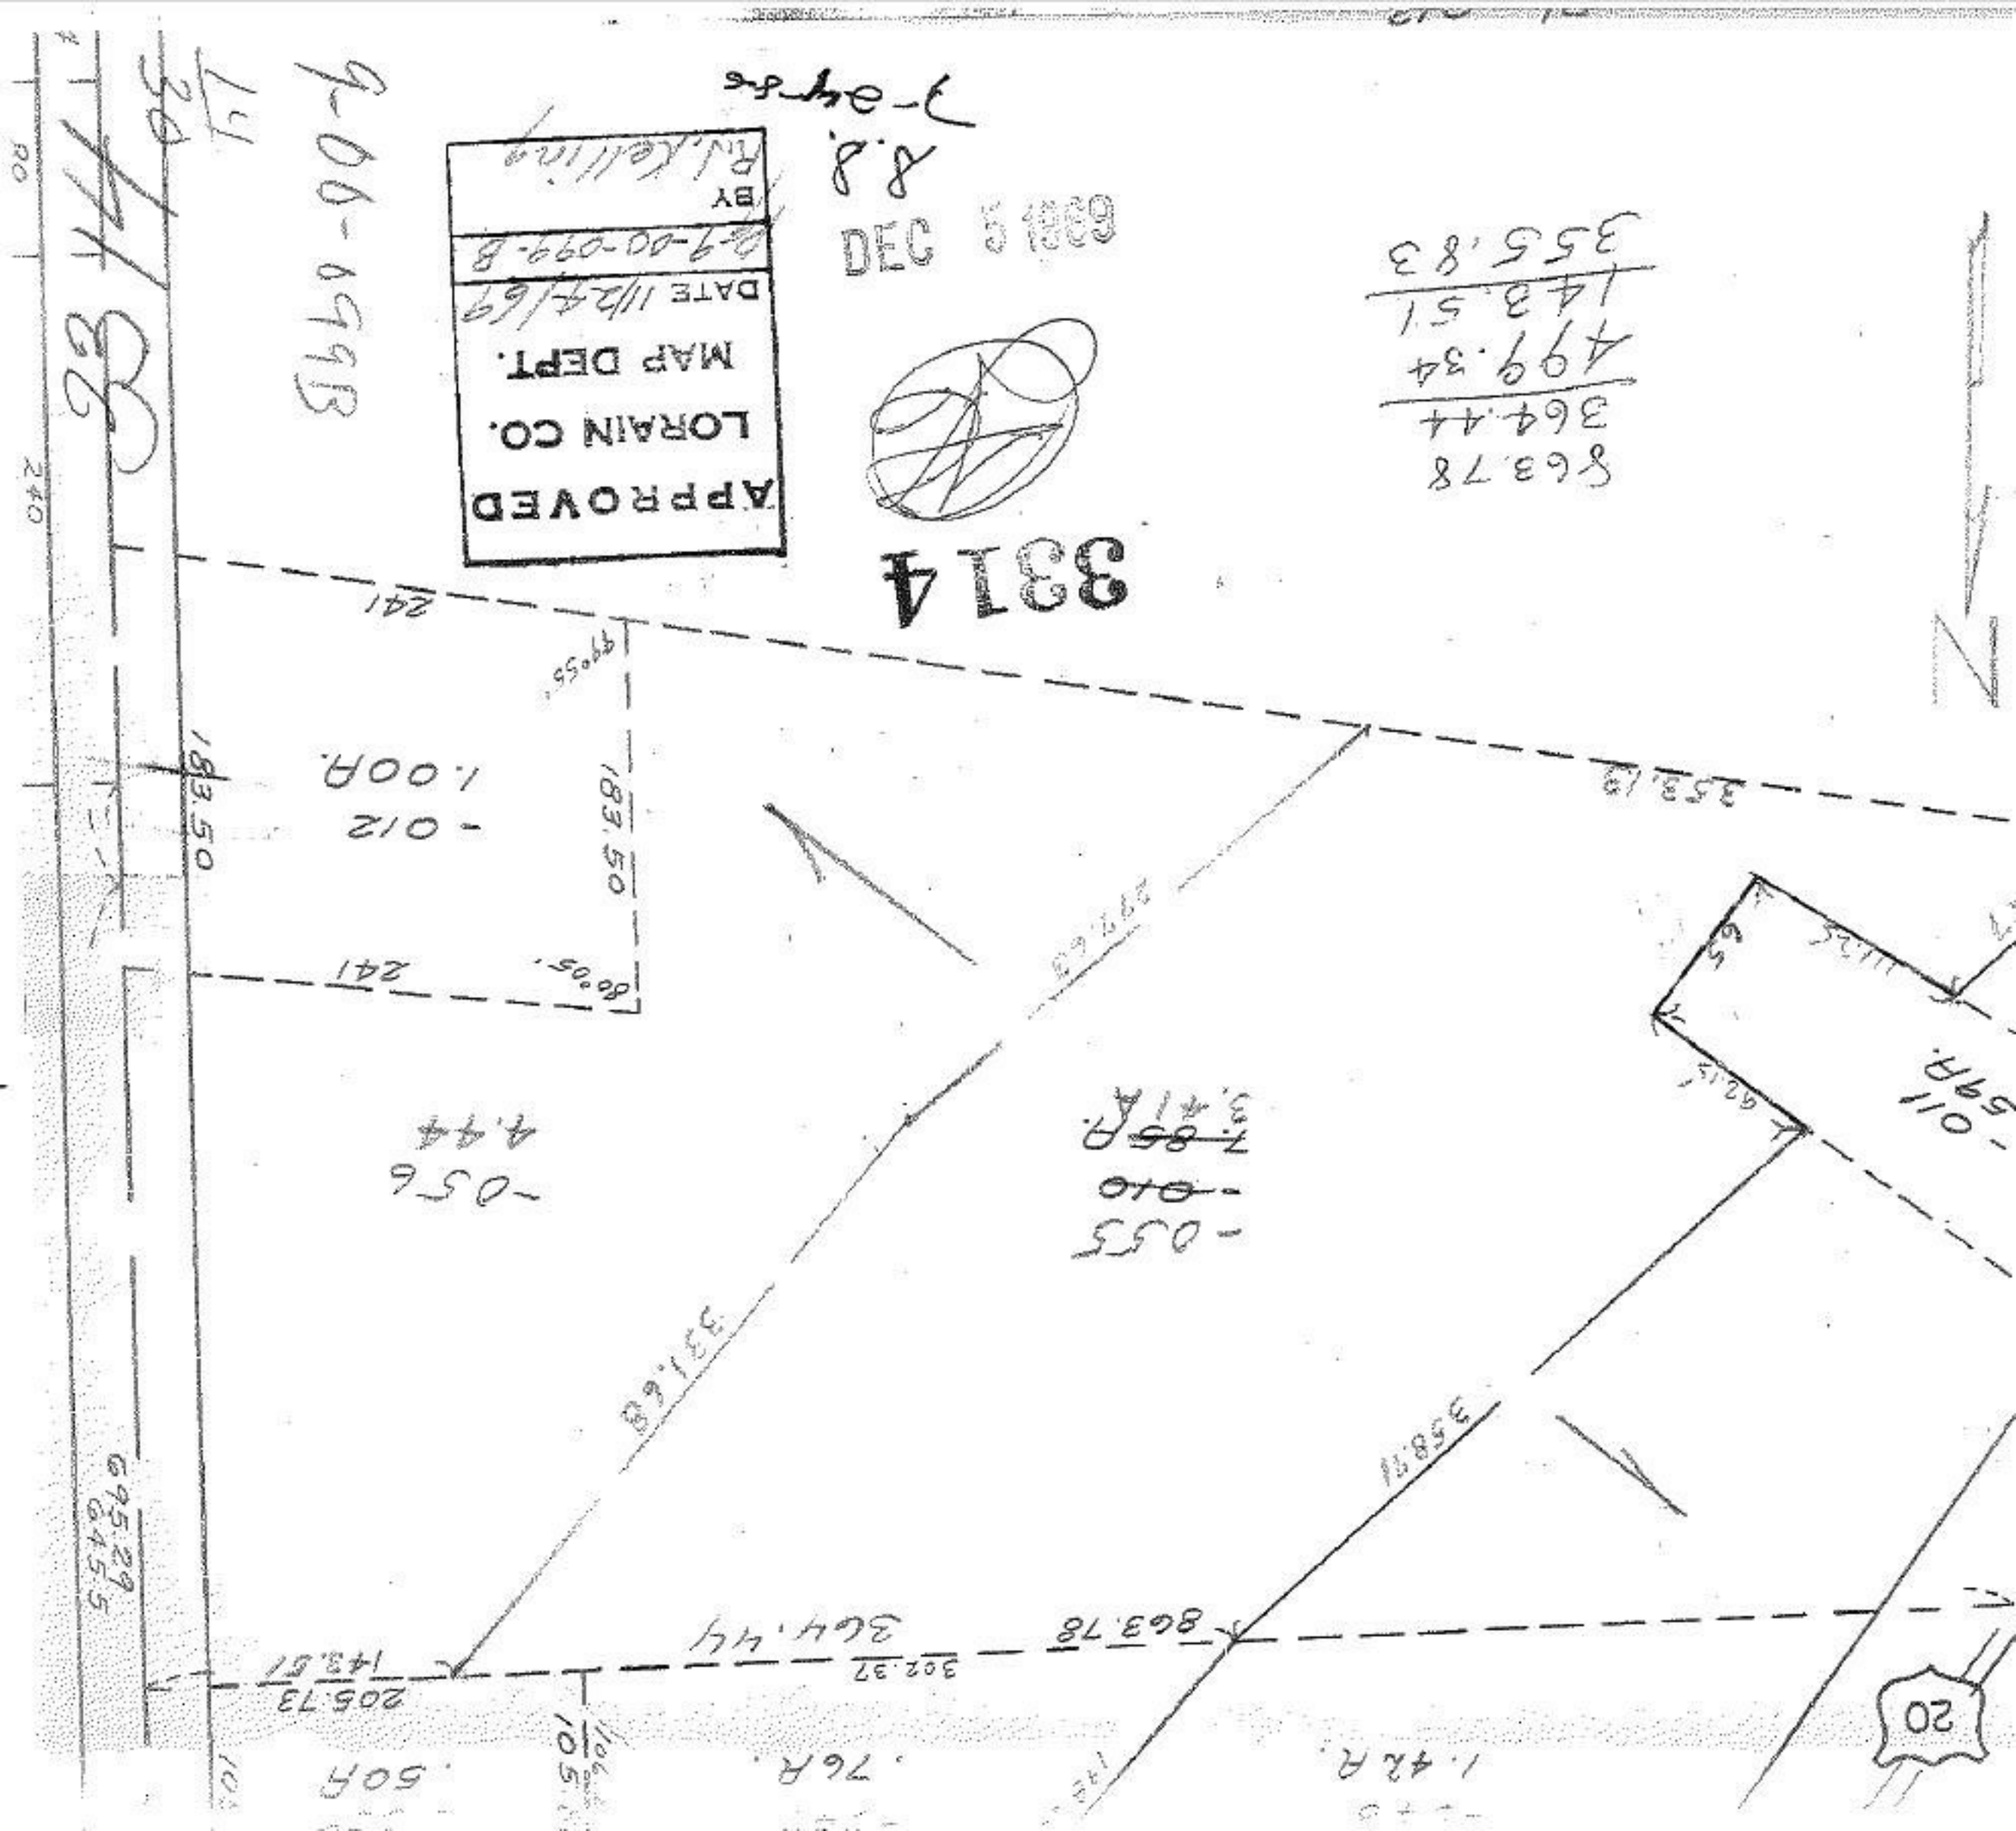

APPROVED
LORAIN CO.
MAP DEPT.
DATE 11/24/69
9-00-099-B
BY
R.J. Kelling
DEC 5 1969
3314
863.78
364.44
499.34
143.51
355.83
353.19
241
99°55'
183.50
80°05'
-012
1.00A.
-056
4.44
-055
3.41A.
331.68
358.71
-011
.59A.
863.78
364.44
302.37
205.73
143.51
695.29
645.5
.50A
.76A
1.42A
20