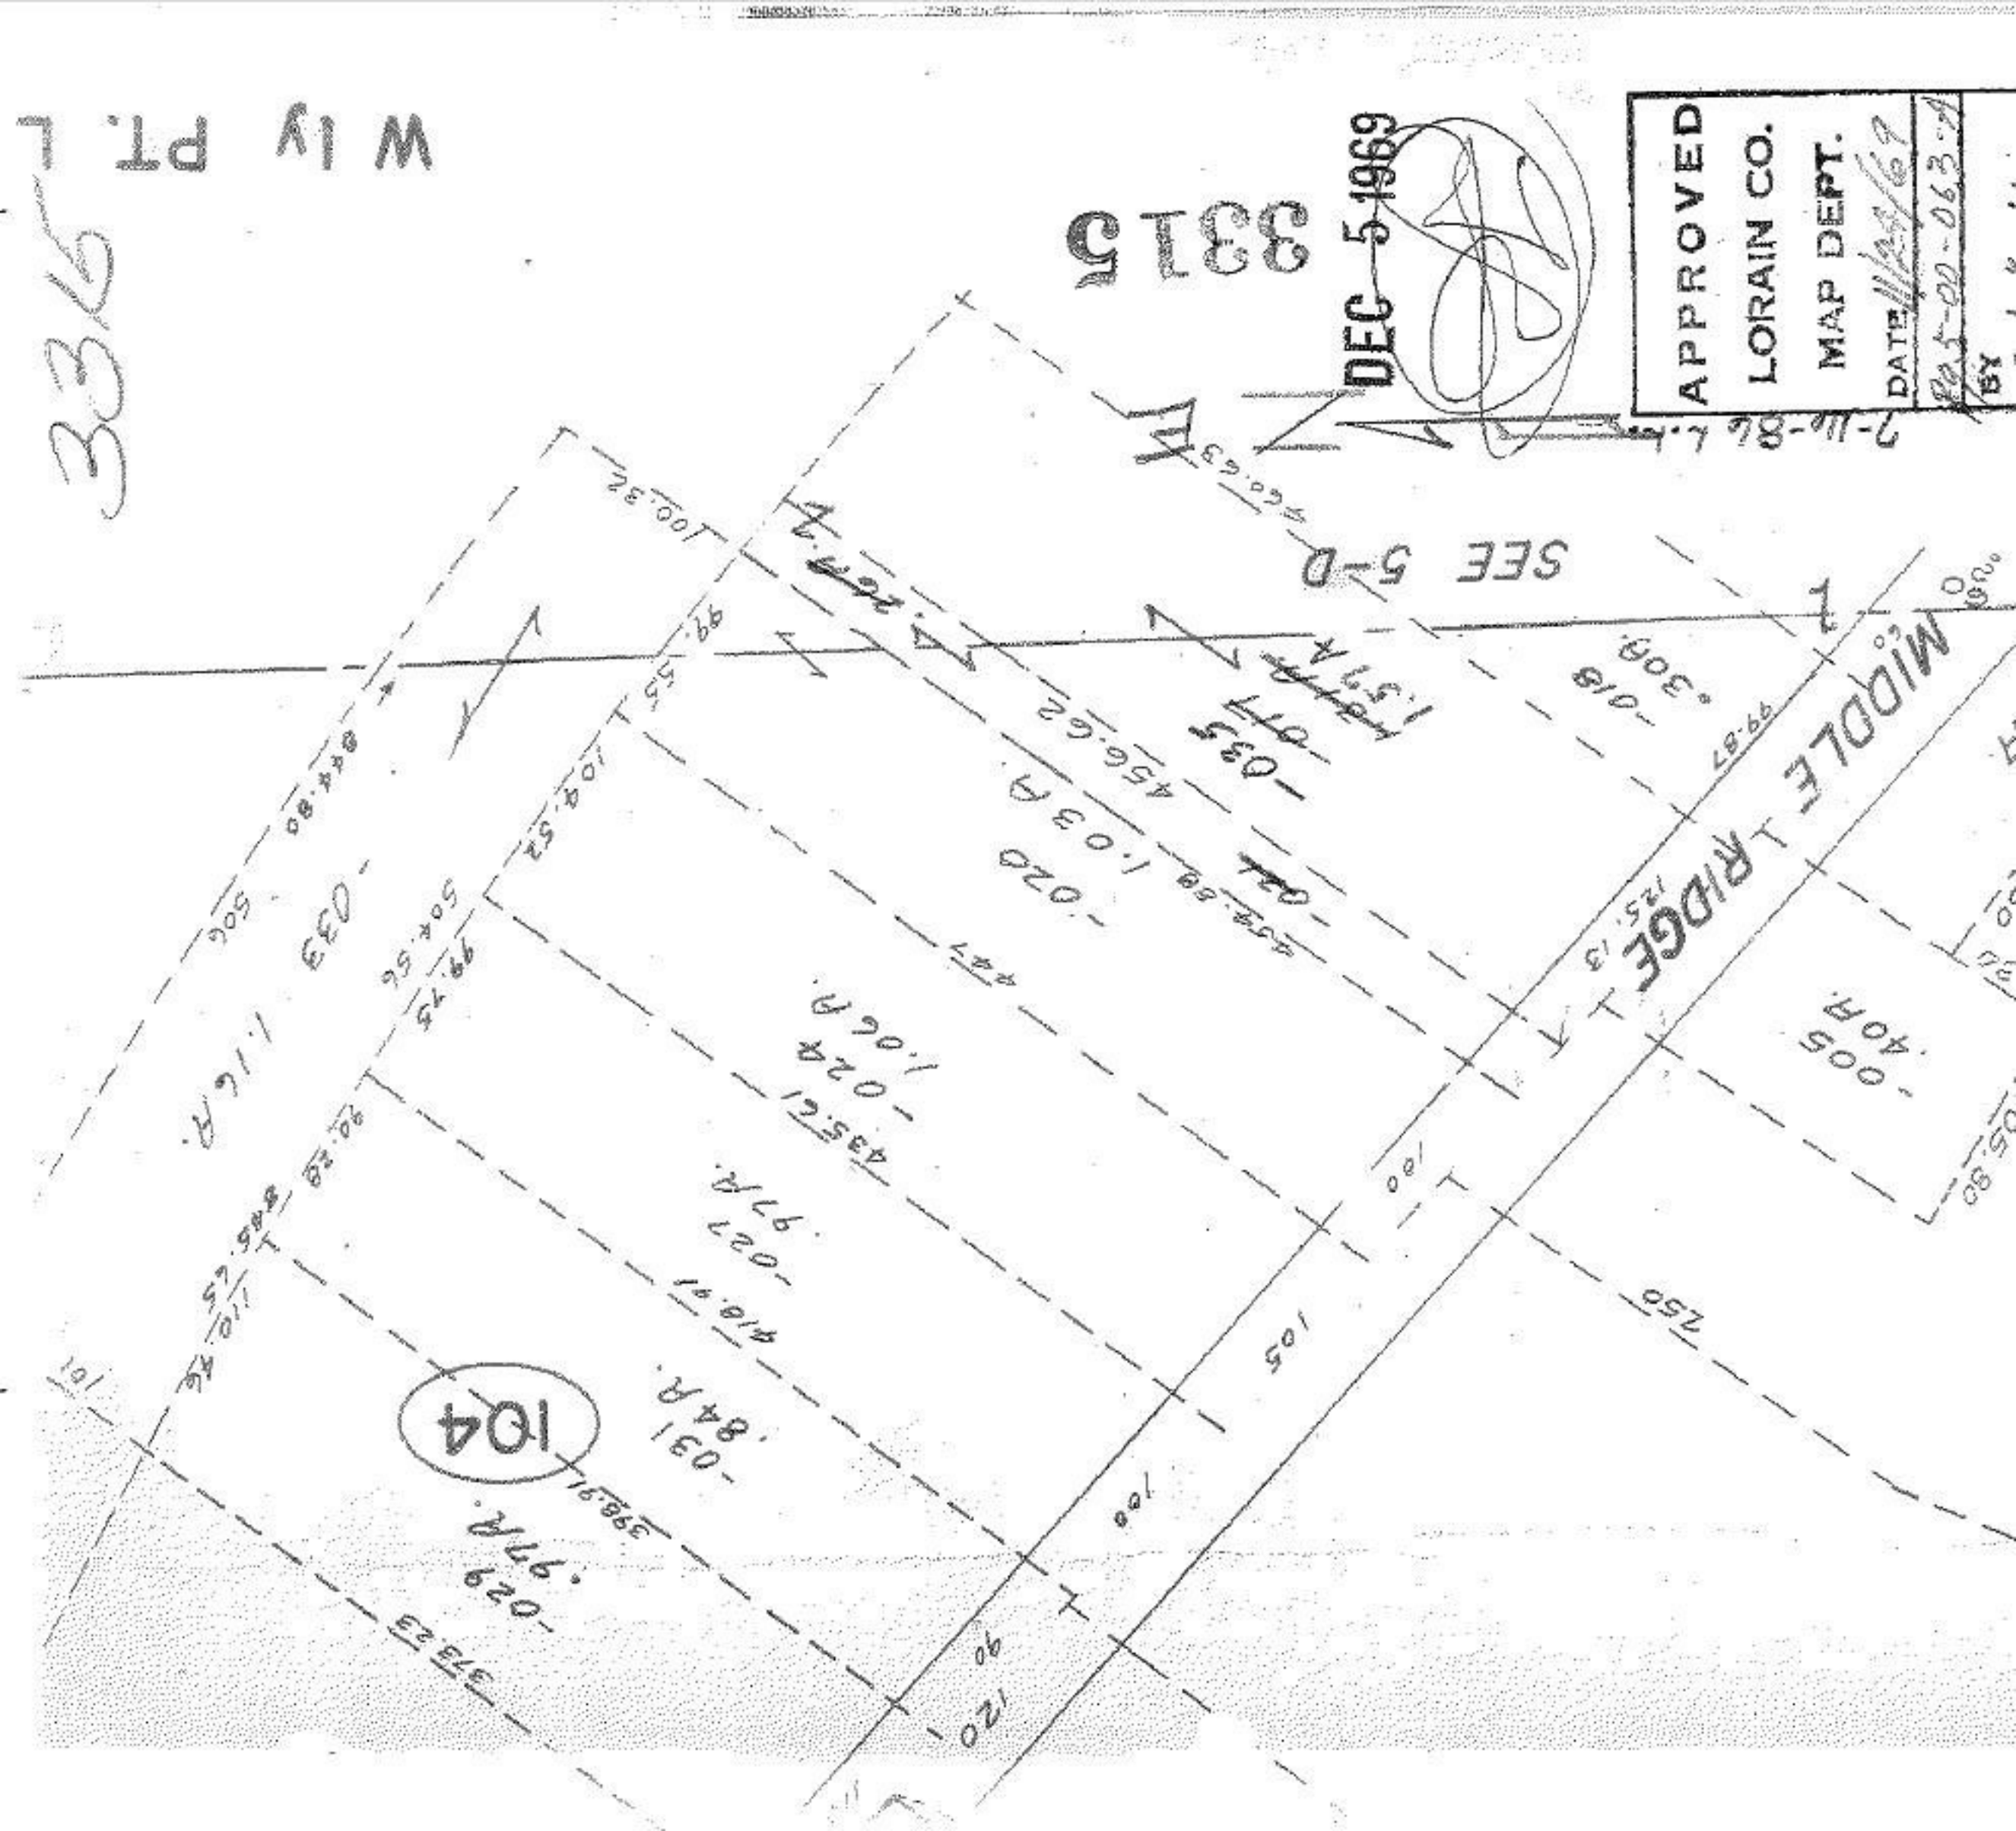

W ly Pt. L
3315
DEC 5 1969
APPROVED
LORAIN CO.
MAP DEPT.
DATE 11/24/69
BY
SEE 5-D
MIDDLE RIDGE
104