3324

#3324
APPROVED
LORAIN CO.
MAP DEPT.
DATE 11-28-69
10-00-008C
BY LW Hall

JAN 6 ENT'D
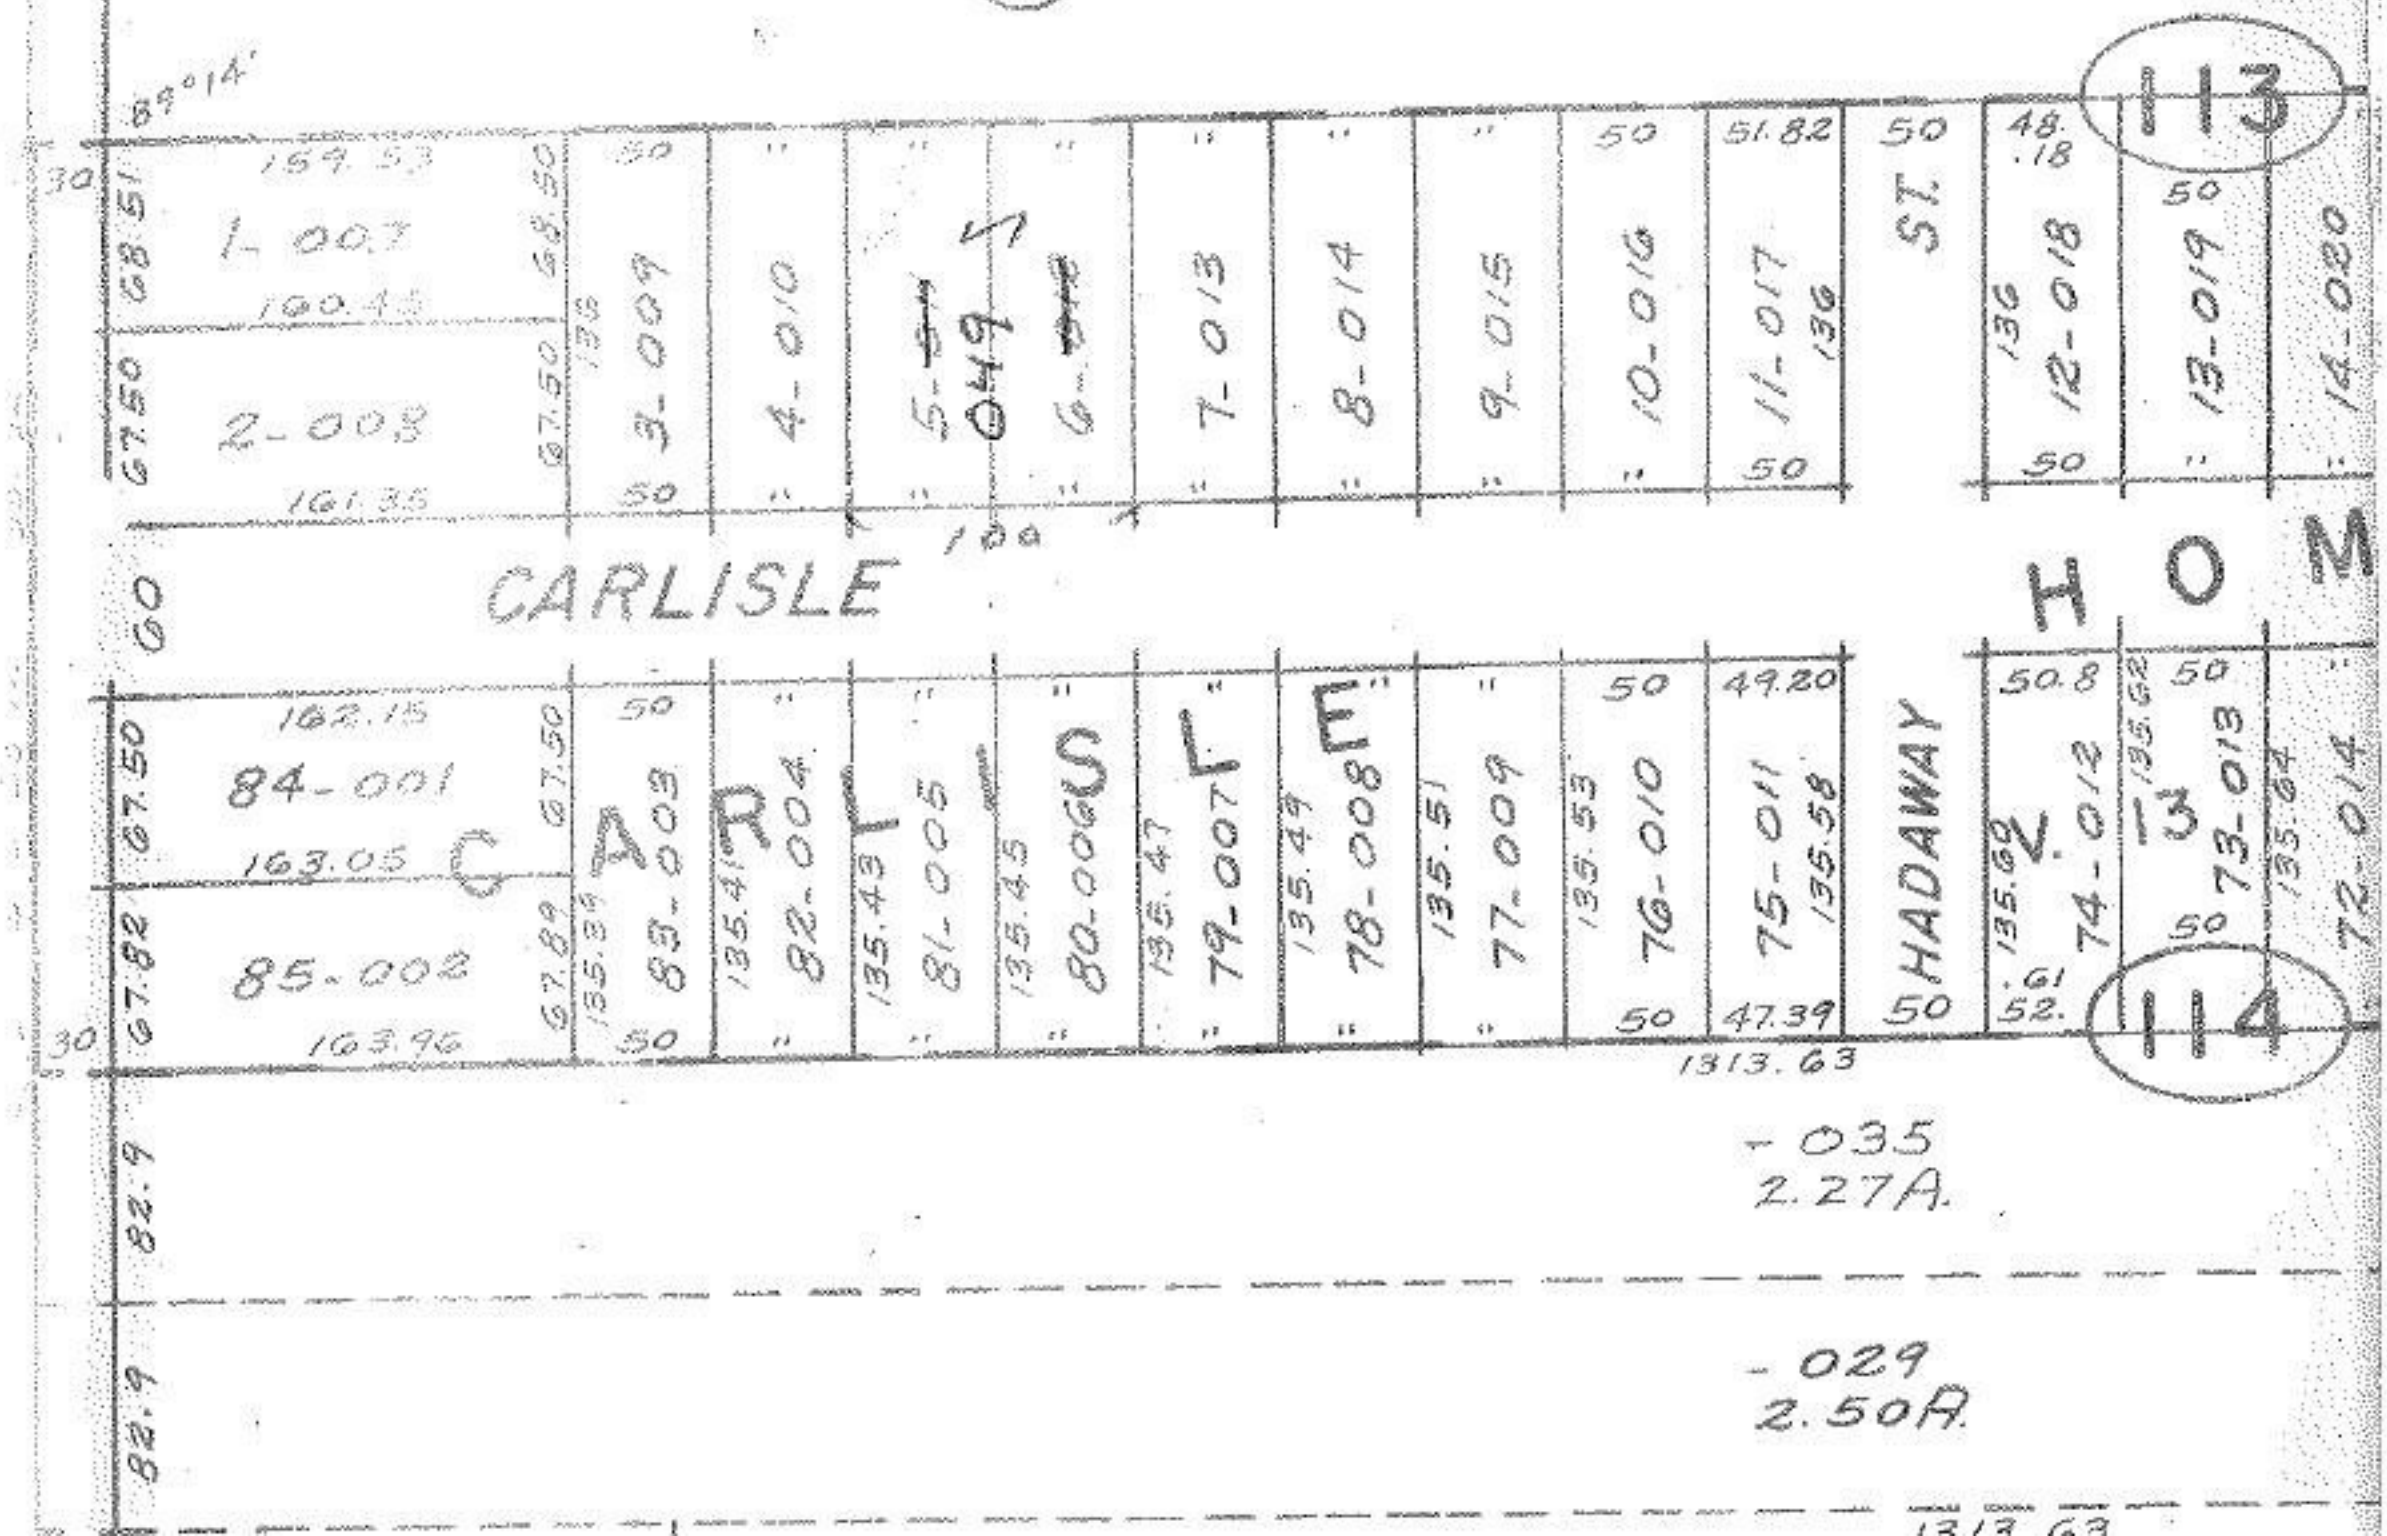
D.D. 7-24-86