00-016-C

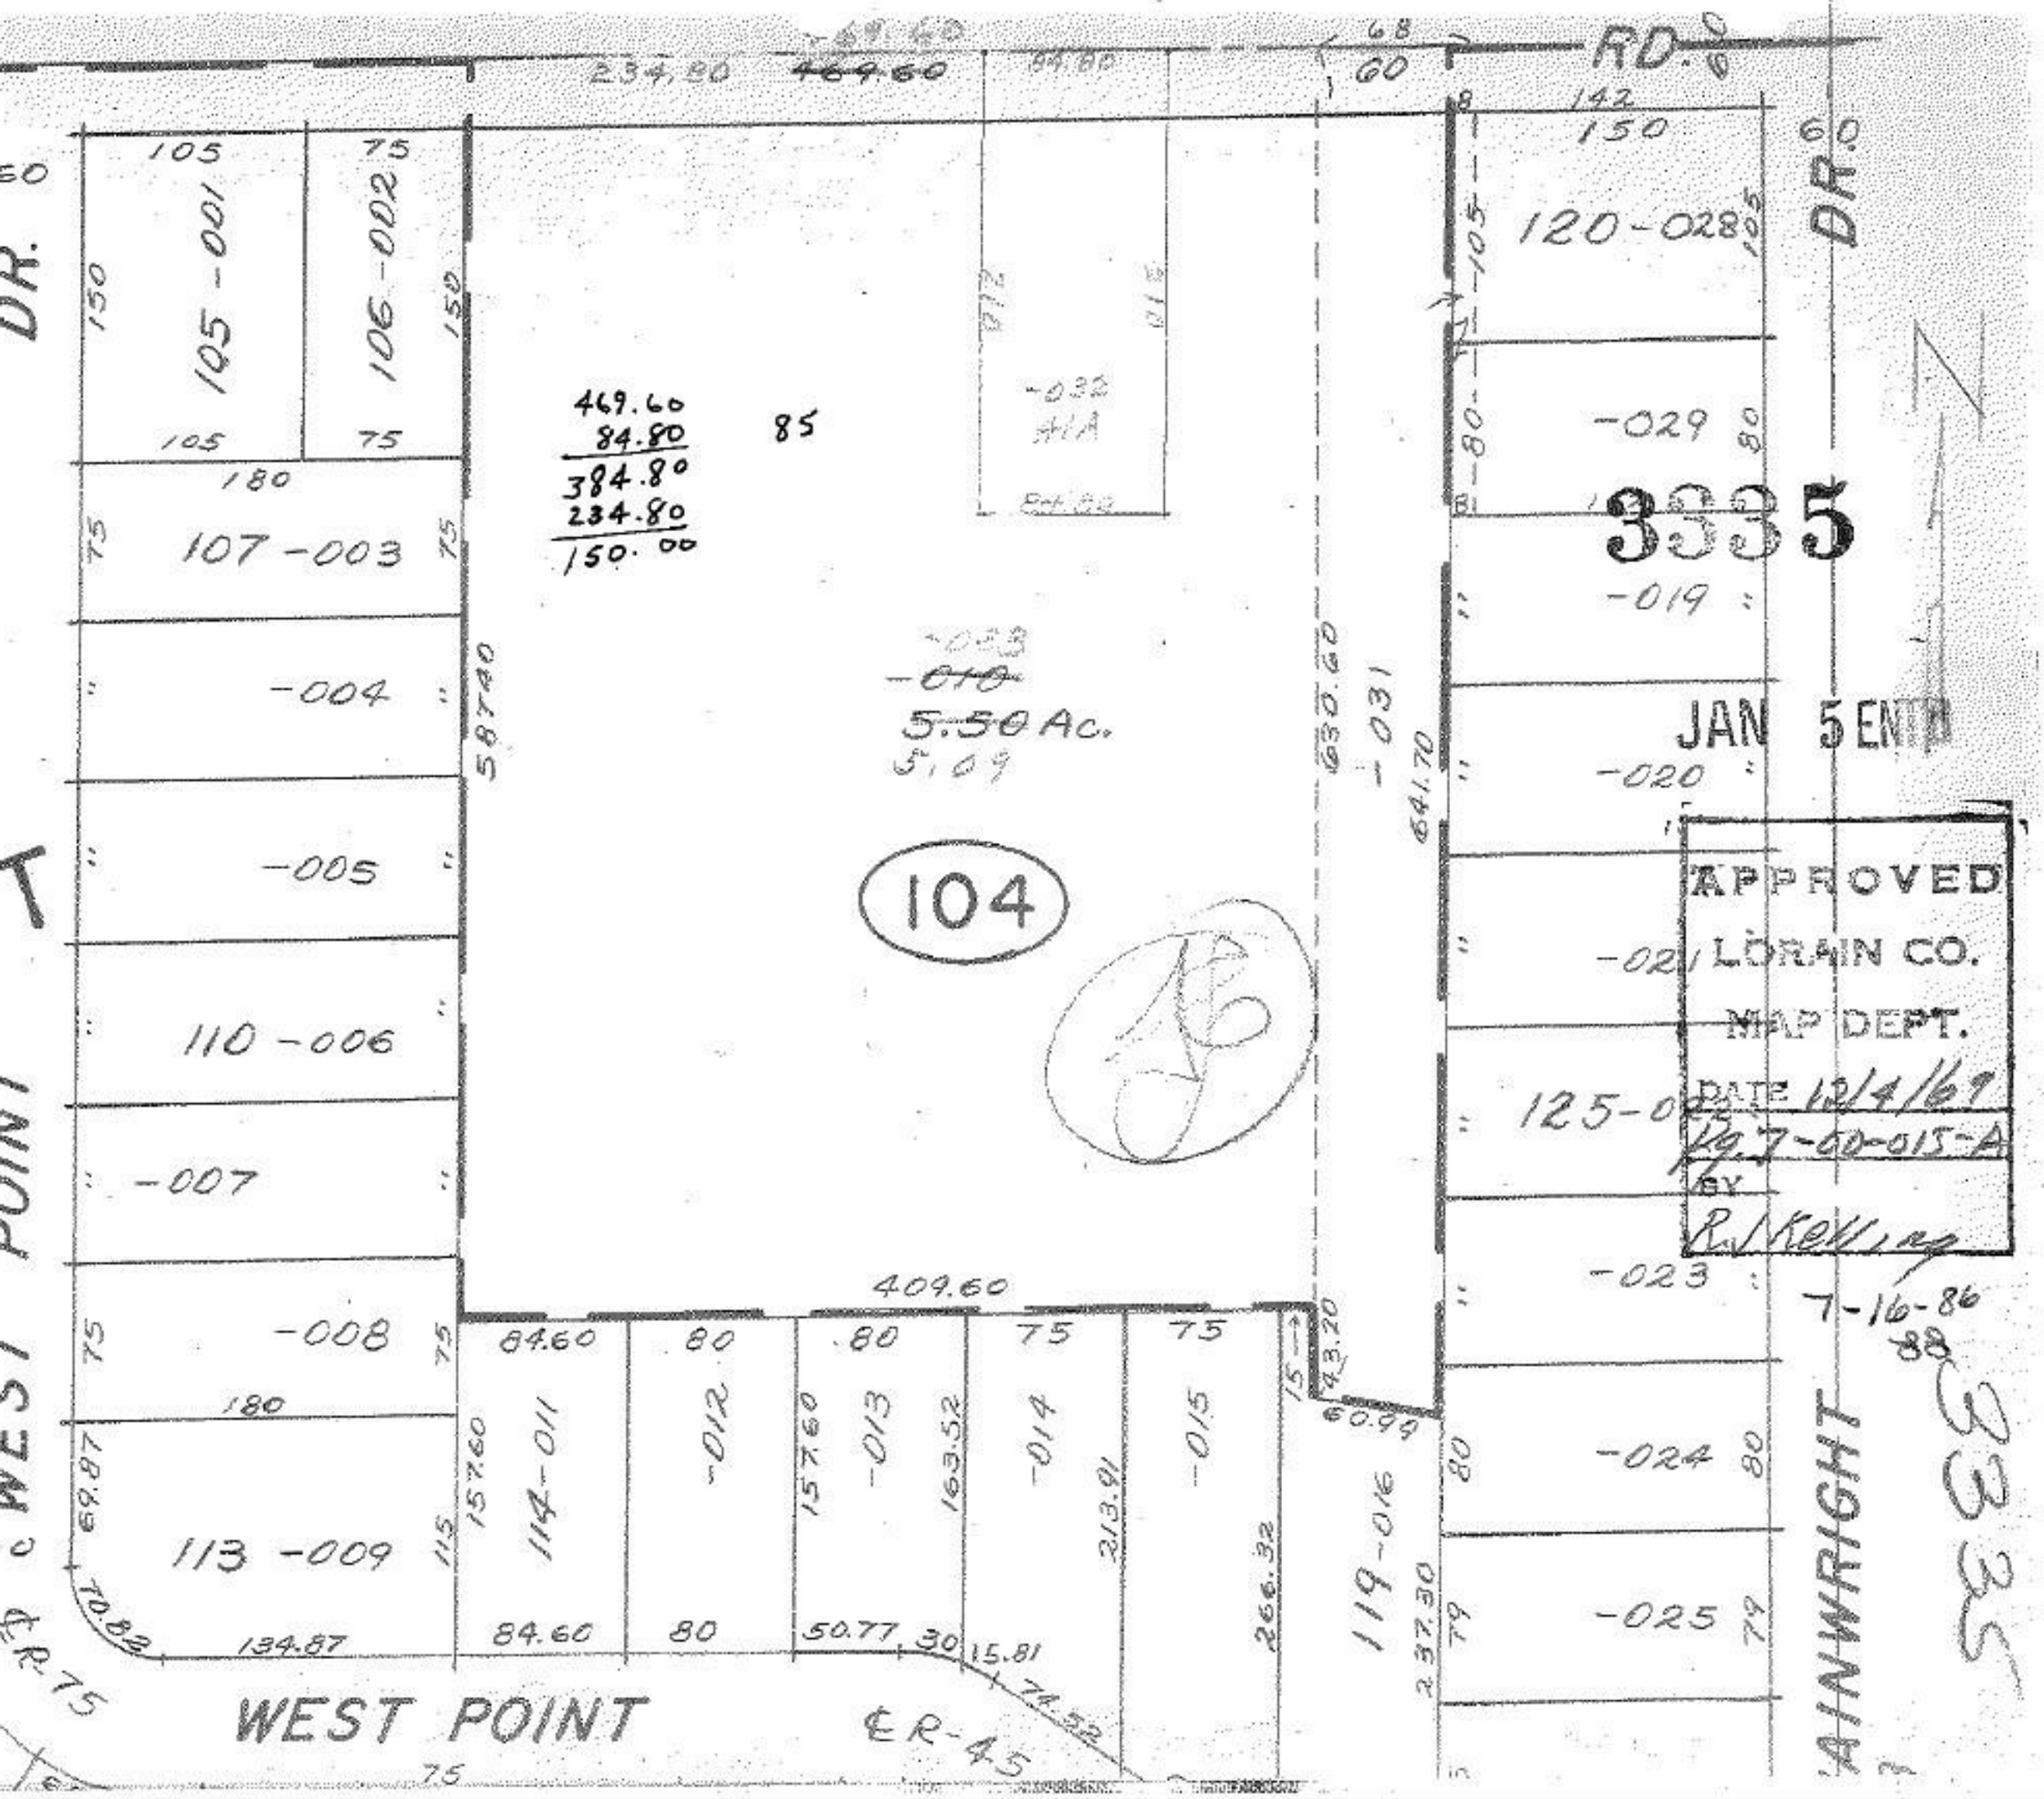

APPROVED
LORAIN CO.
MAP DEPT.
DATE 12/4/69
Pg. 7-00-015-A
BY
R. J. Kelling

7-16-86
88

3335