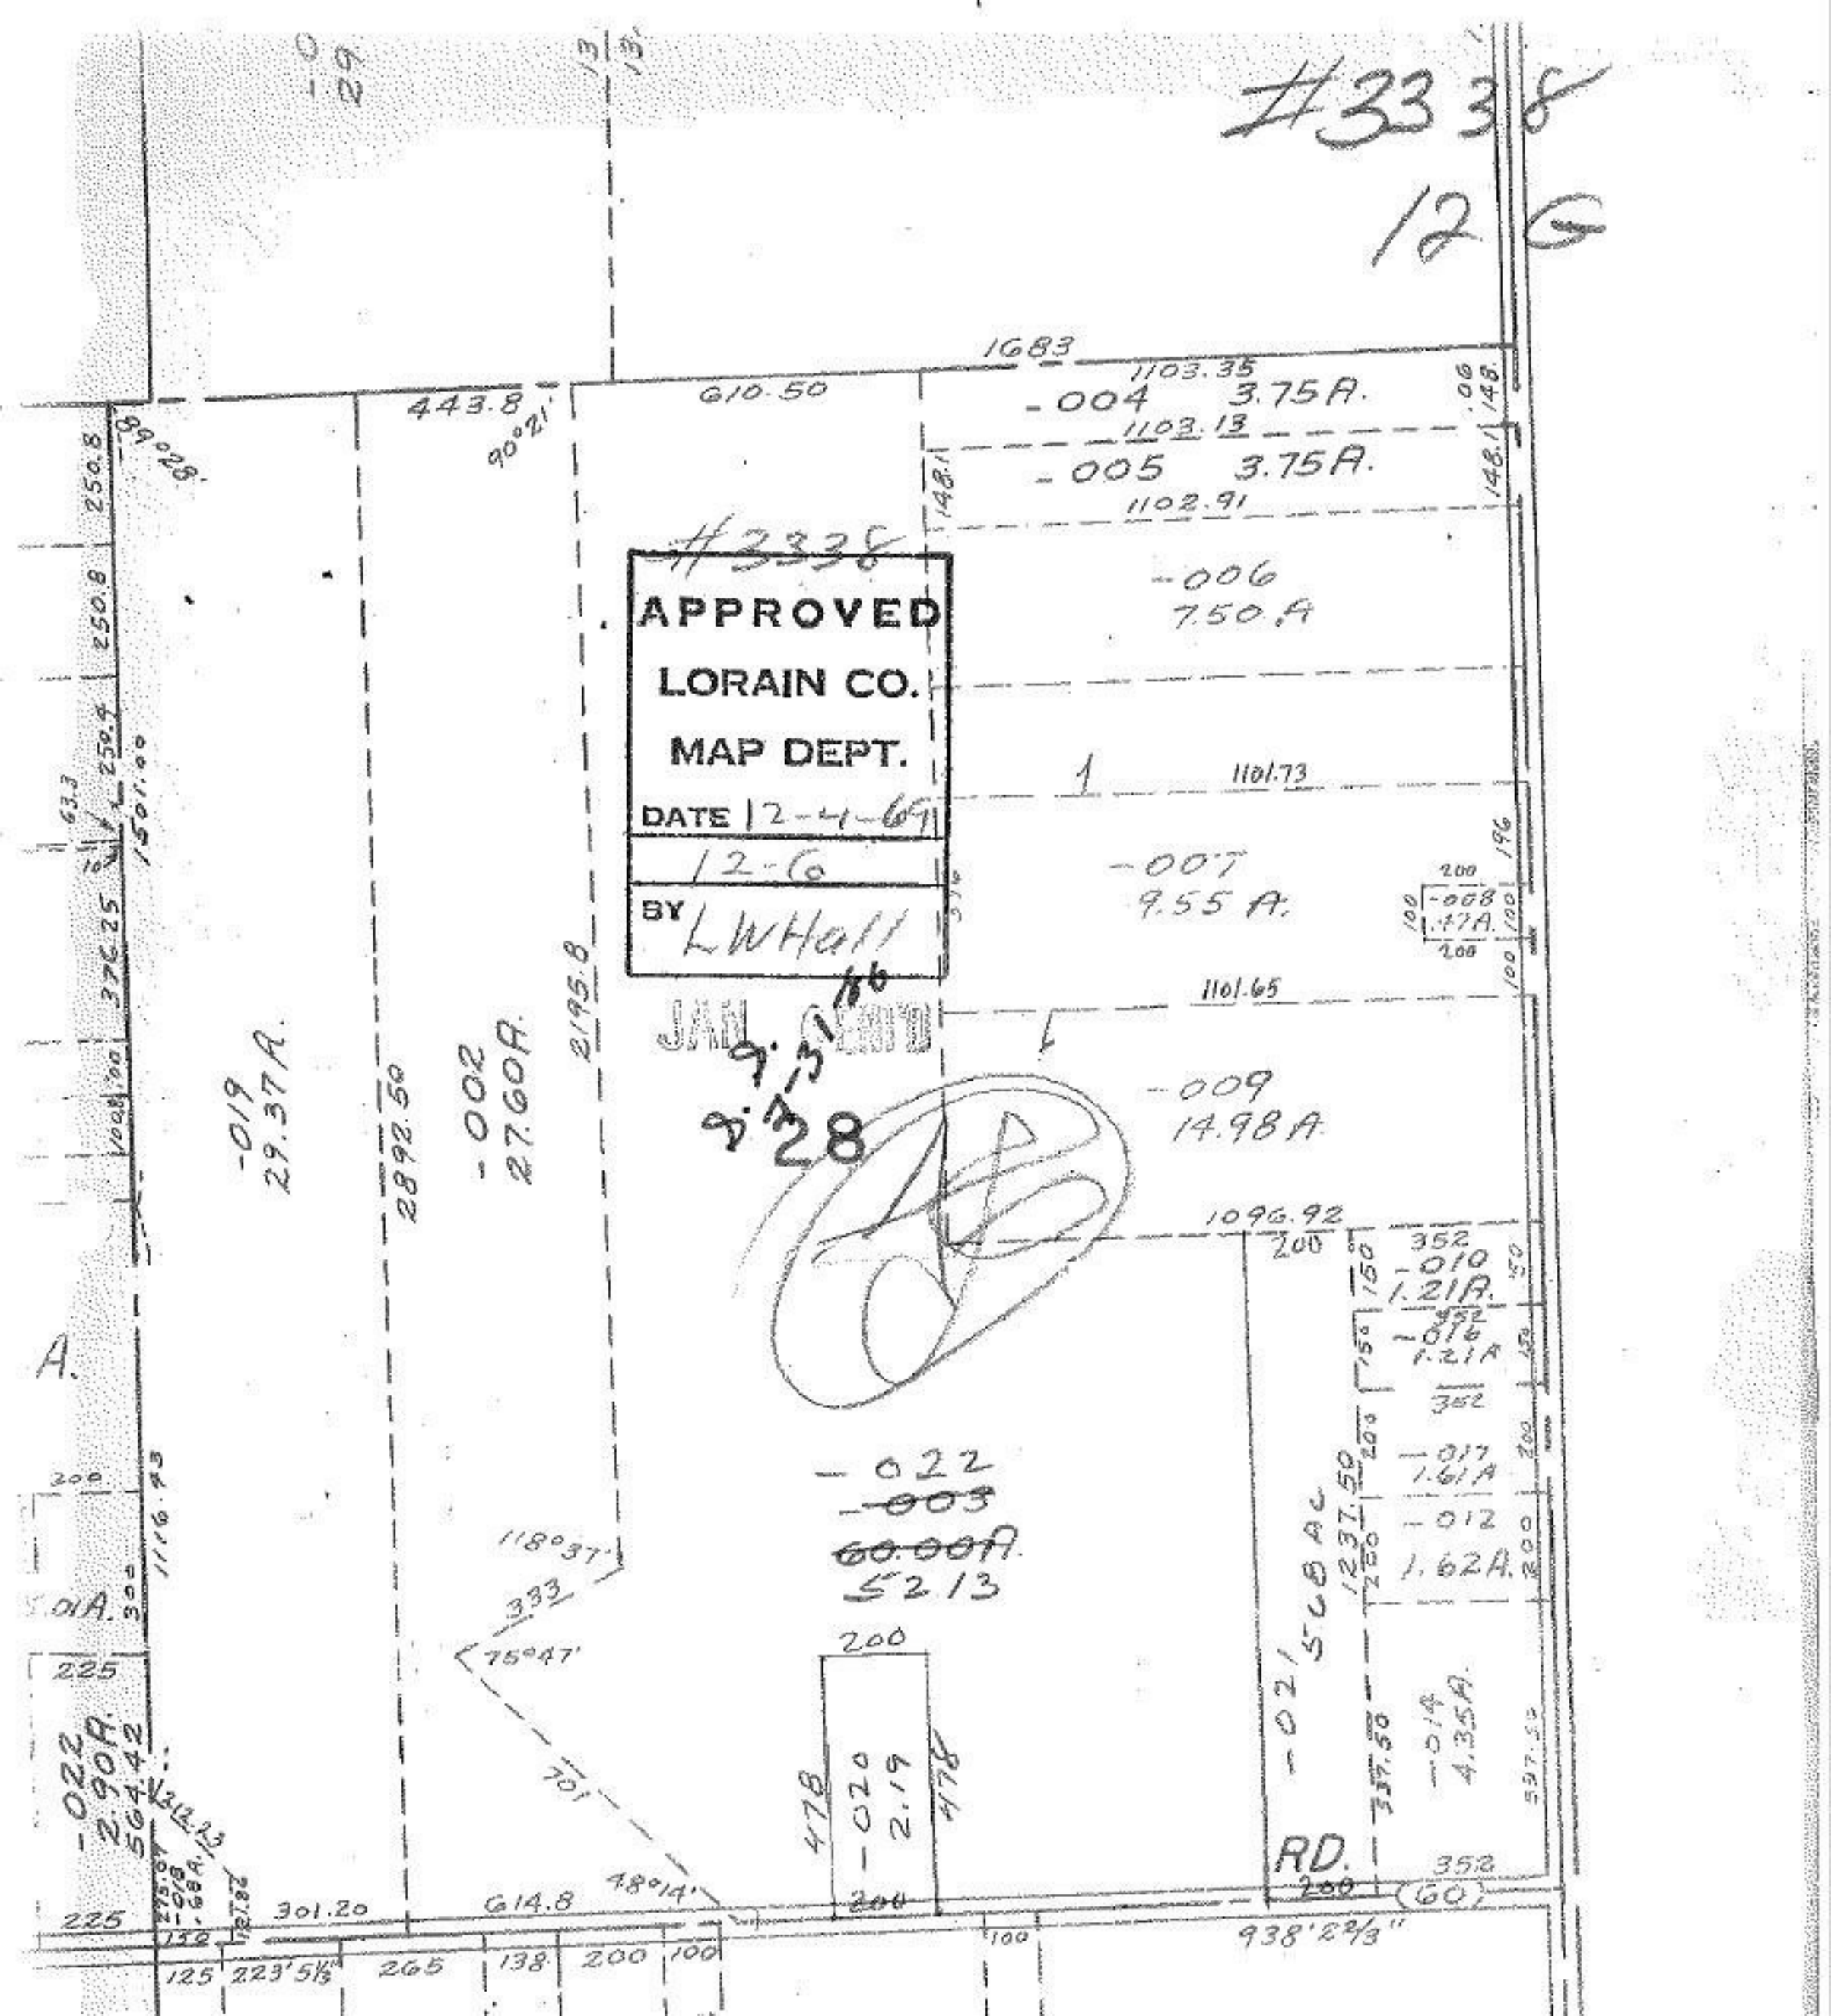
#3338
12 G
APPROVED
LORAIN CO.
MAP DEPT.
DATE 12-4-69
12-G
BY LWHall
JAN 1970
28
1683
1103.35
-004 3.75A.
1103.13
-005 3.75A.
1102.91
-006
7.50 A
1101.73
-007
9.55 A.
1101.65
-009
14.98 A
1096.92
-010
1.21A.
-016
1.21A
-017
1.61A
-012
1.62A.
-014
4.35A.
-021
568 AC
-022
-003
60.00A
52.13
-020
2.19
-019
29.37 A.
-002
27.60A.
-022
2.90A.
RD.
(60)
443.8
610.50
2892.50
2195.8
1501.00
1116.43
1237.50
337.50
938'2 2/3"
301.20
614.8
223'5 1/3"
265
138
200
100
125
225
333
701
118°37'
75°47'
48°14'
90°21'
89°28'
250.8
250.4
376.25
63.3
148.1
148.06
196
352
150
300
478