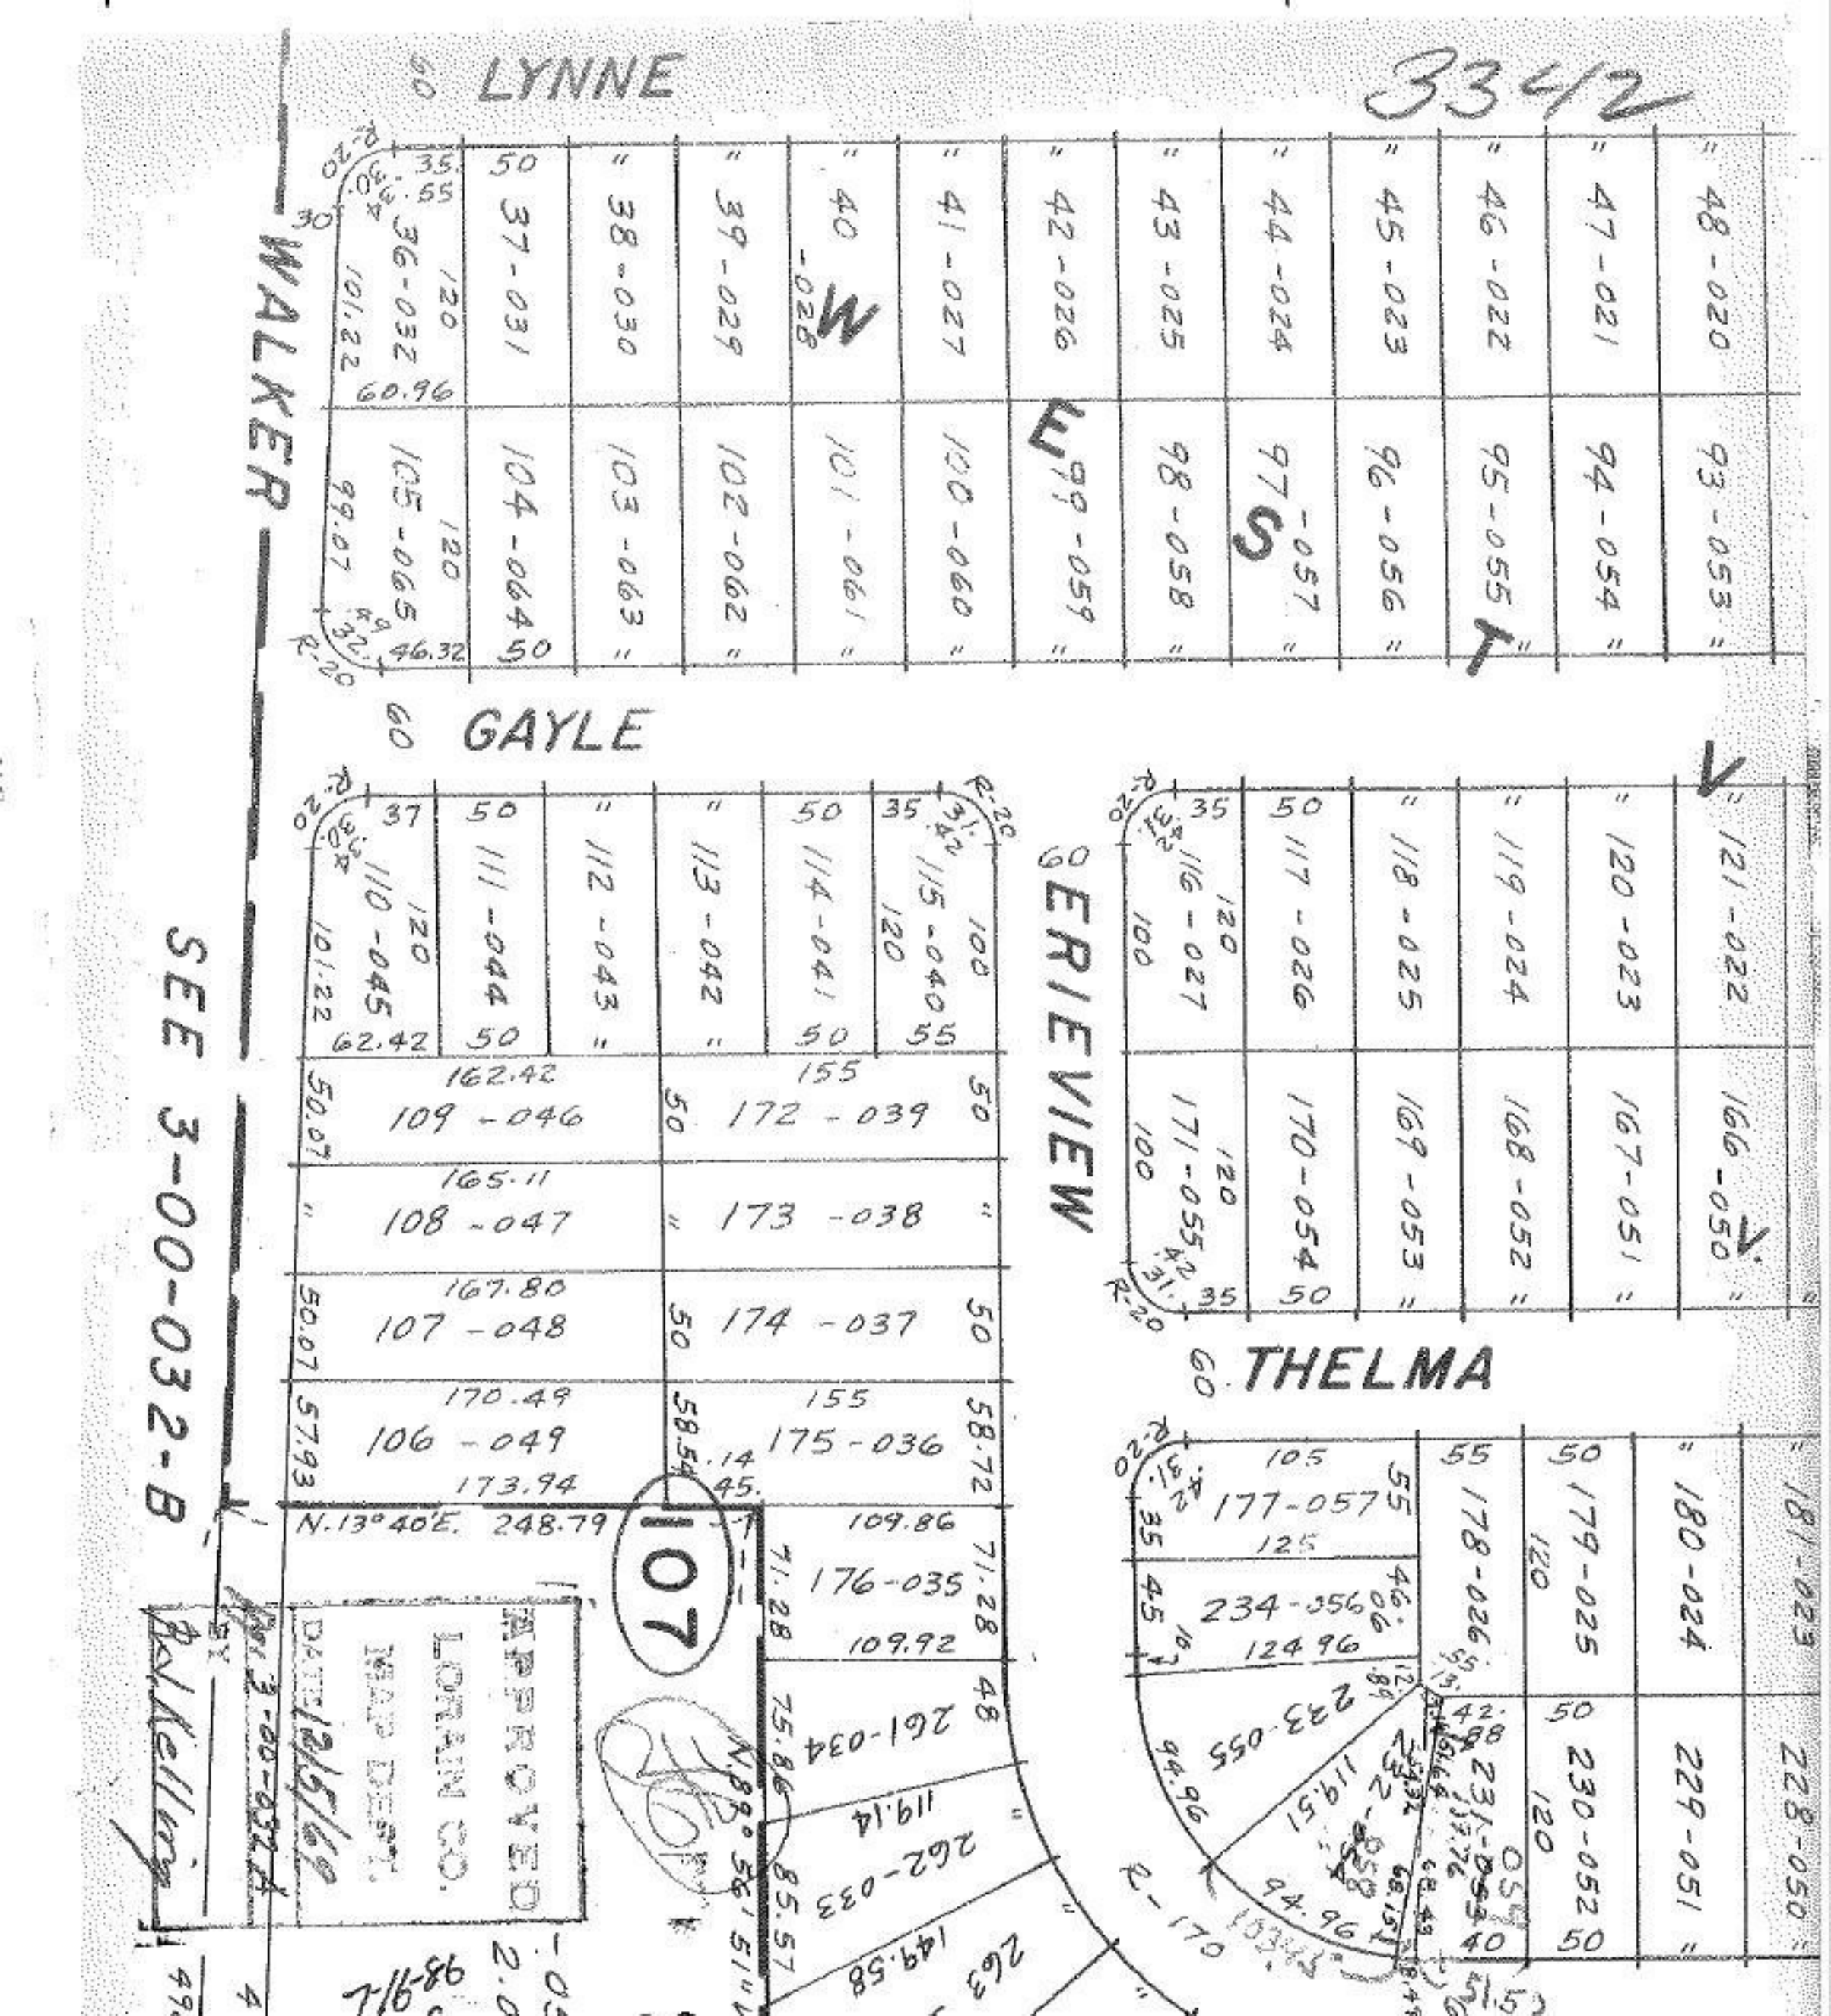
3342
LYNNE
GAYLE
WALKER
ERIEVIEW
THELMA
SEE 3-00-032-B
107
APPROVED
LORAIN CO.
MAP DEPT.
DATE 12/5/69
N.13°40'E. 248.79
N.89°56'51"
R-20
R-170
36-032
37-031
38-030
39-029
40-028
41-027
42-026
43-025
44-024
45-023
46-022
47-021
48-020
105-065
104-064
103-063
102-062
101-061
100-060
99-059
98-058
97-057
96-056
95-055
94-054
93-053
110-045
111-044
112-043
113-042
114-041
115-040
109-046
108-047
107-048
106-049
172-039
173-038
174-037
175-036
176-035
261-034
262-033
177-057
234-056
178-026
179-025
180-024
181-023
223-055
231-053
230-052
229-051
228-050
116-027
117-026
118-025
119-024
120-023
121-022
171-055
170-054
169-053
168-052
167-051
166-050