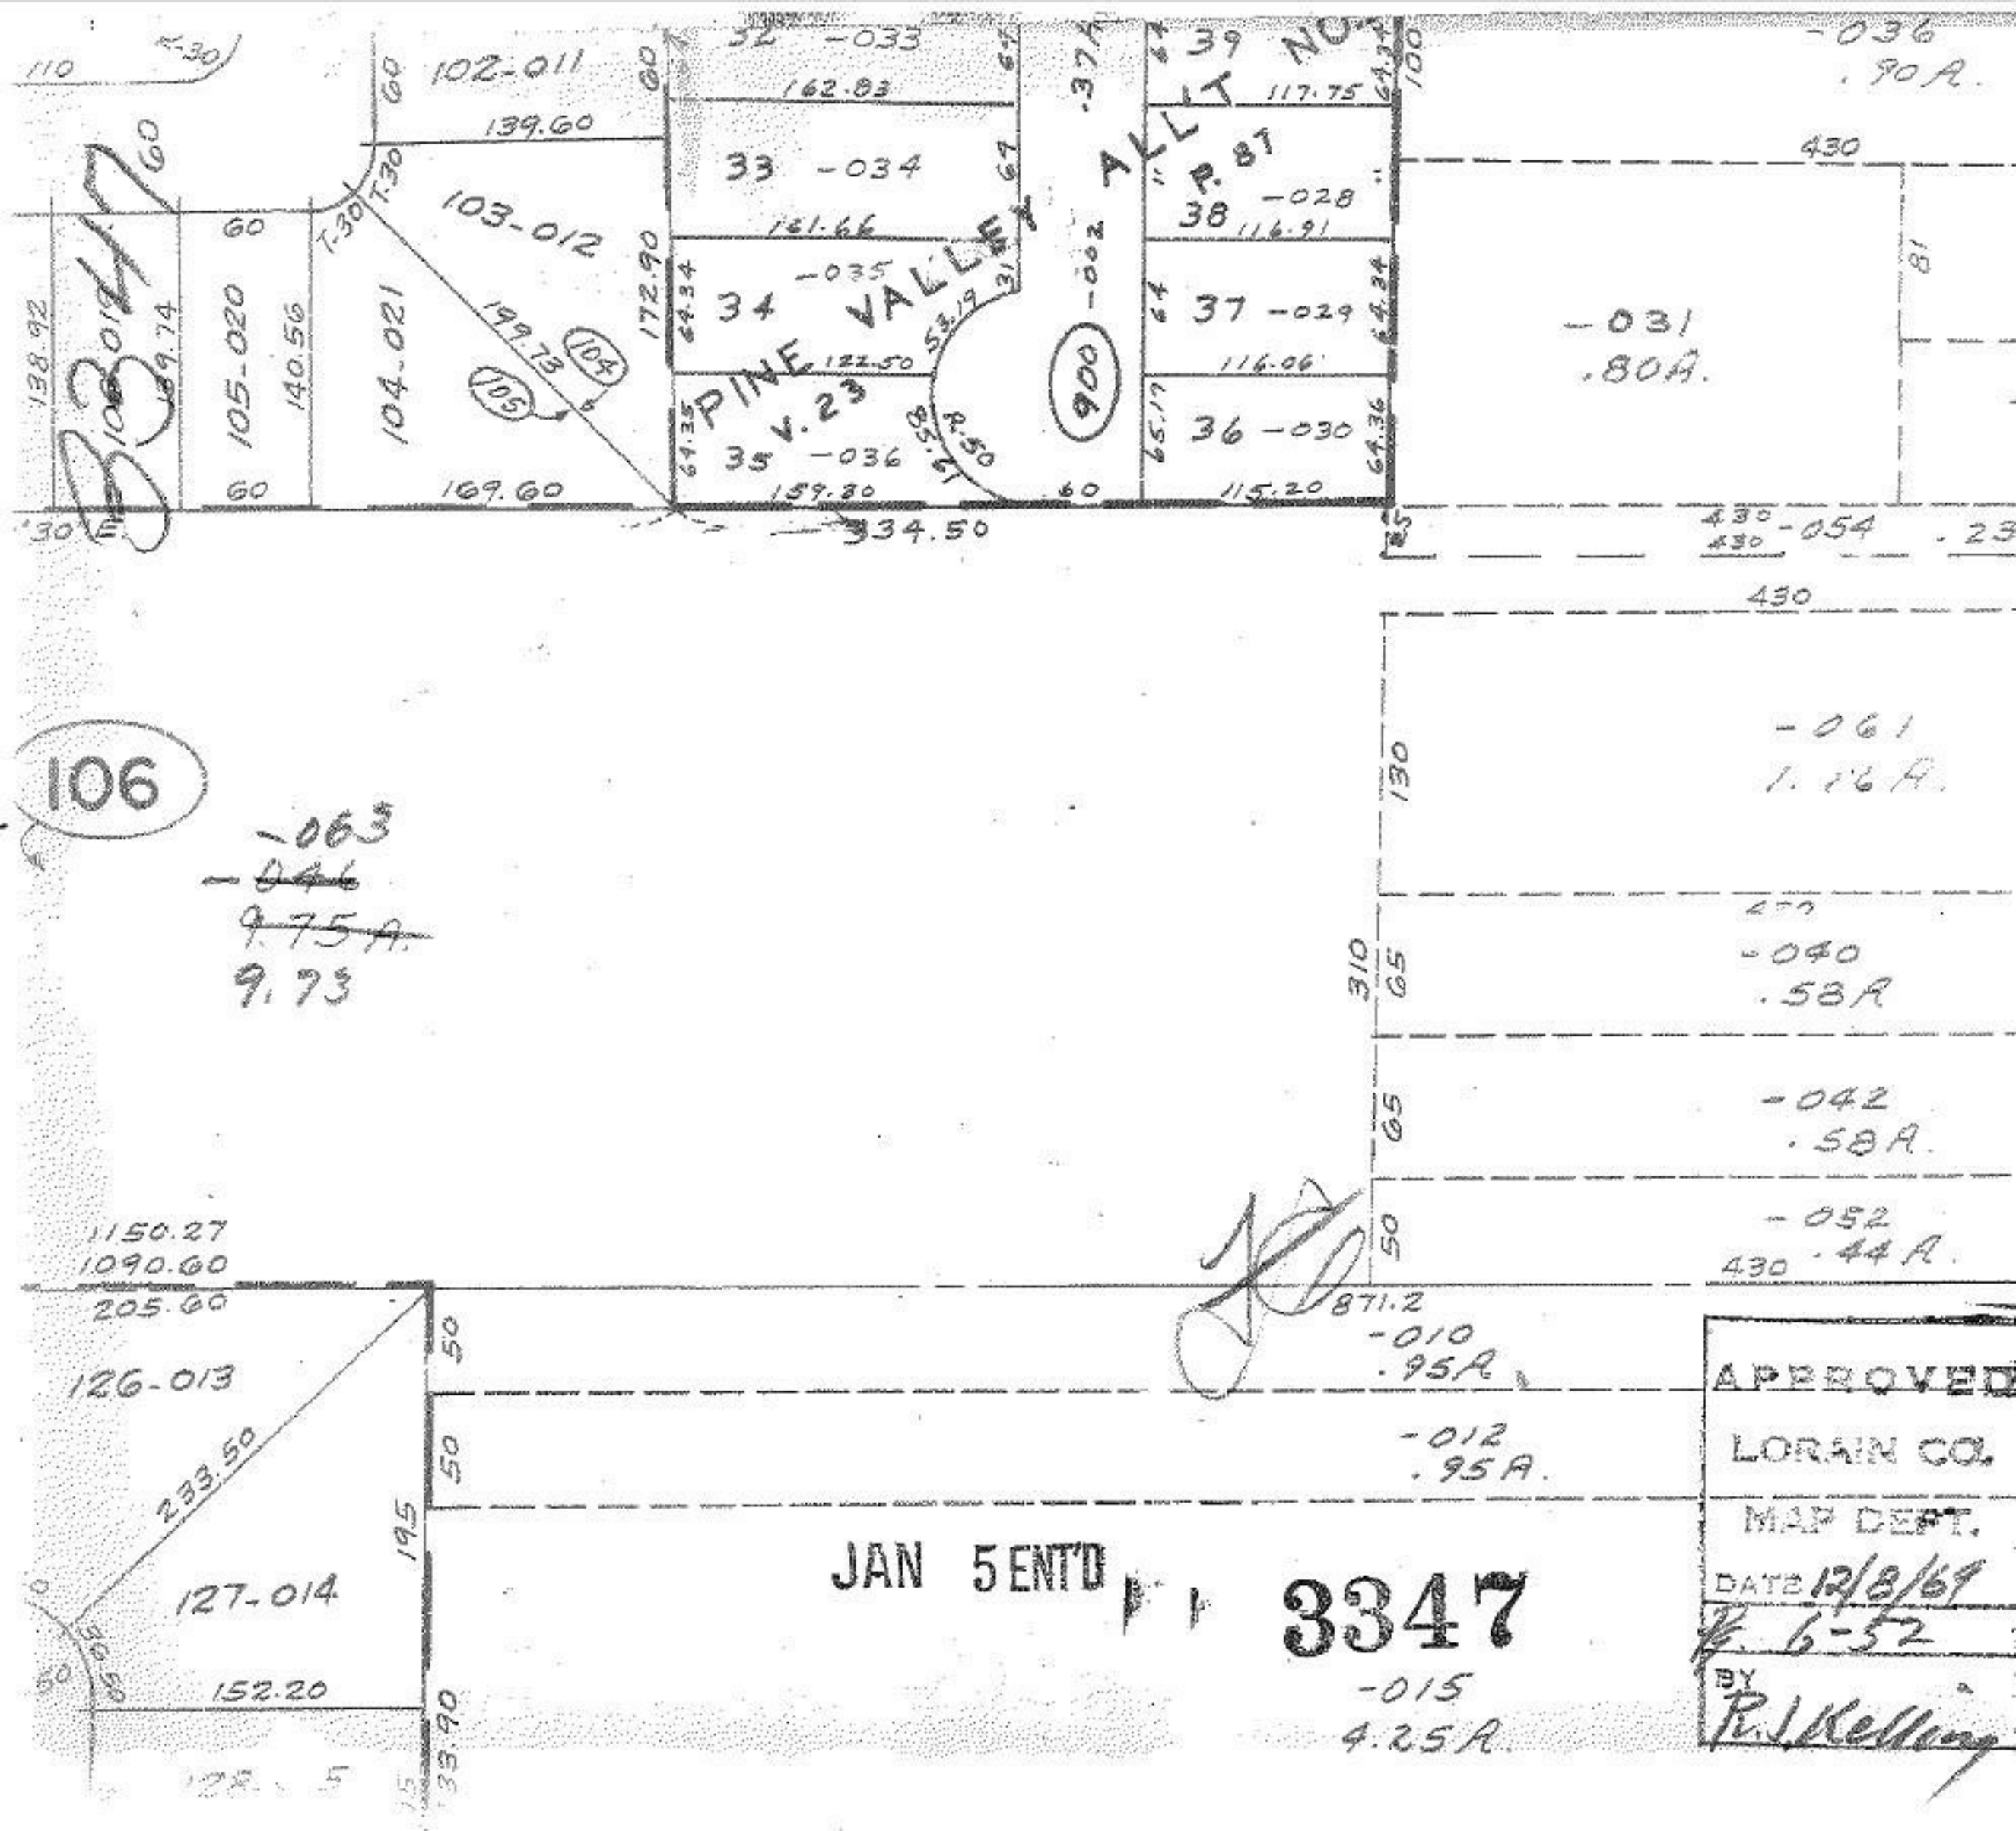

JAN 5 ENT'D

3347

APPROVED
LORAIN CO.
MAP DEPT.
DATE 12/8/69
6-52
BY R. J. Kelling