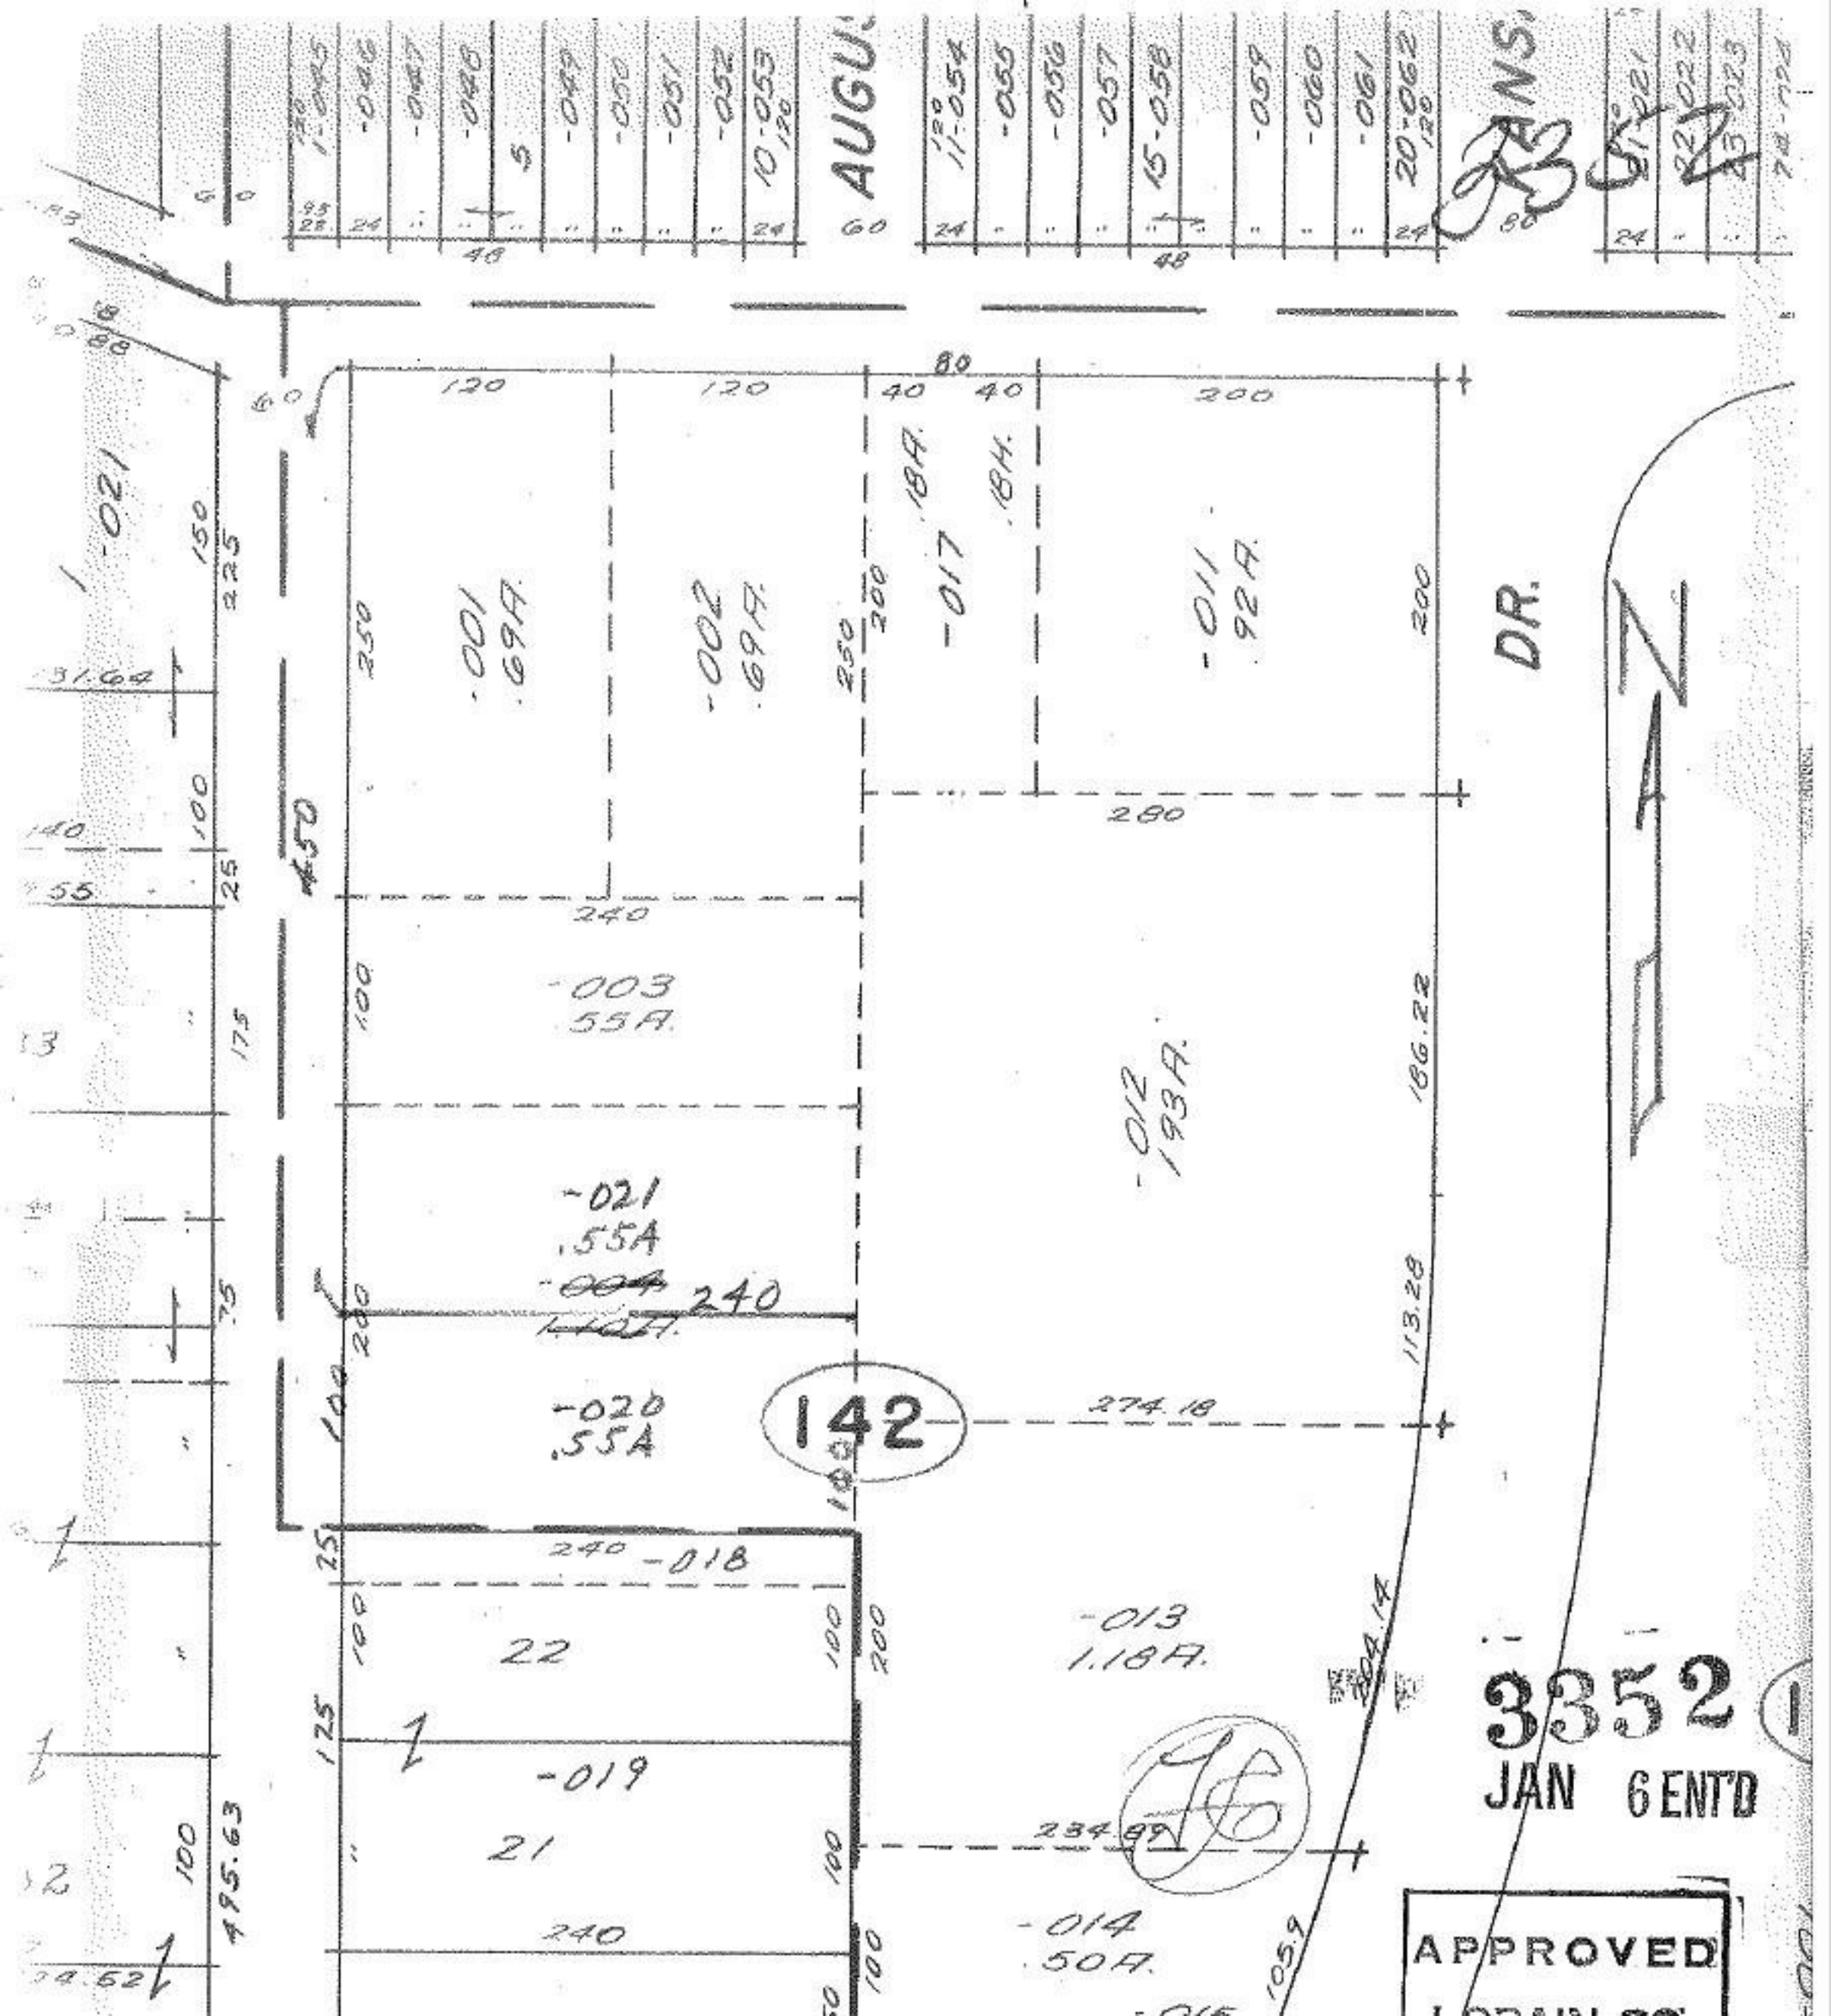
AUGUS
DR.
N
-001
.69A.
-002
.69A.
-017
.18A.
.18H.
-011
.92A.
-003
.55A.
-012
.193A.
-021
.55A
-020
.55A
142
274.18
-018
22
-013
1.18A.
-019
21
234.89
-014
.50A.
3352
JAN 6 ENT'D
APPROVED