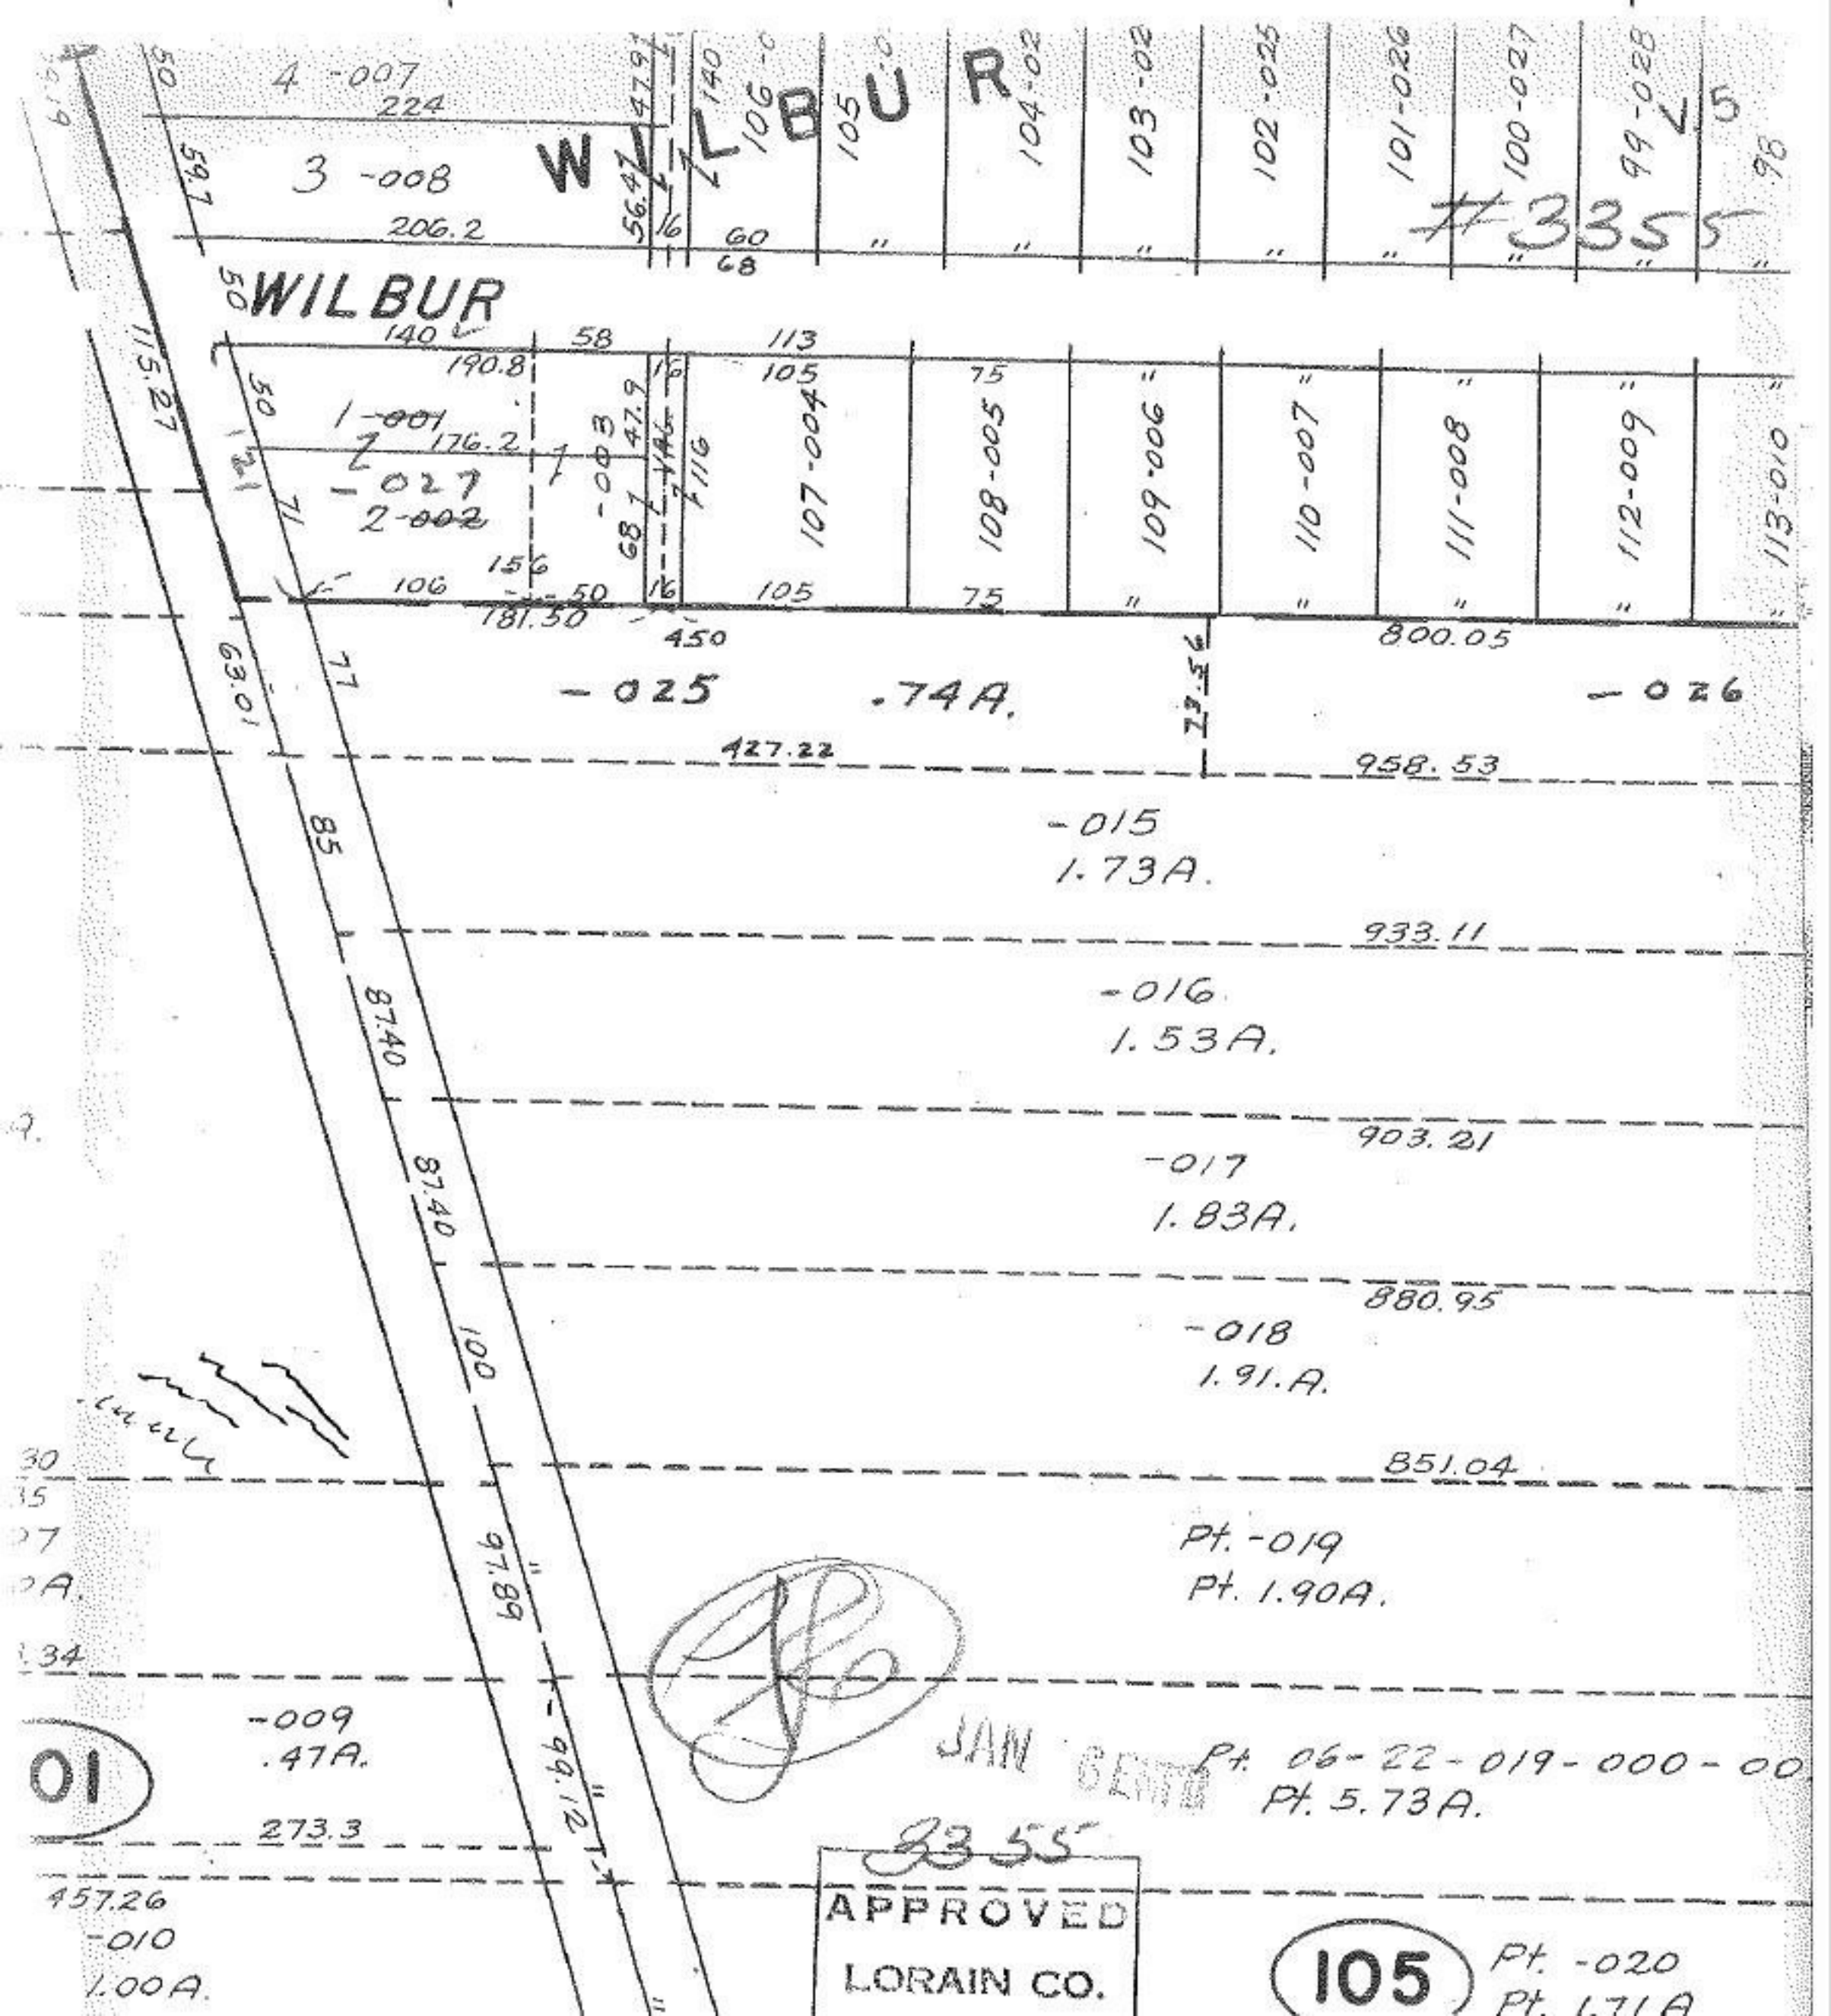

WILBUR
4 -007
224
3 -008
206.2
WILBUR
106
105
104-02
103-02
102-025
101-026
100-027
99-028
V.5
#3355
140
190.8
58
113
105
75
1-001
176.2
-027
2-002
-003
107-004
108-005
109-006
110-007
111-008
112-009
113-010
106
156
50
181.50
450
800.05
-025
.74A.
-026
427.22
958.53
-015
1.73A.
933.11
-016
1.53A.
903.21
-017
1.83A.
880.95
-018
1.91.A.
851.04
Pt. -019
Pt. 1.90A.
-009
.47A.
273.3
Pt. 06-22-019-000-00
Pt. 5.73A.
457.26
-010
1.00A.
01
JAN
3355
APPROVED
LORAIN CO.
105
Pt. -020
Pt. 1.71A