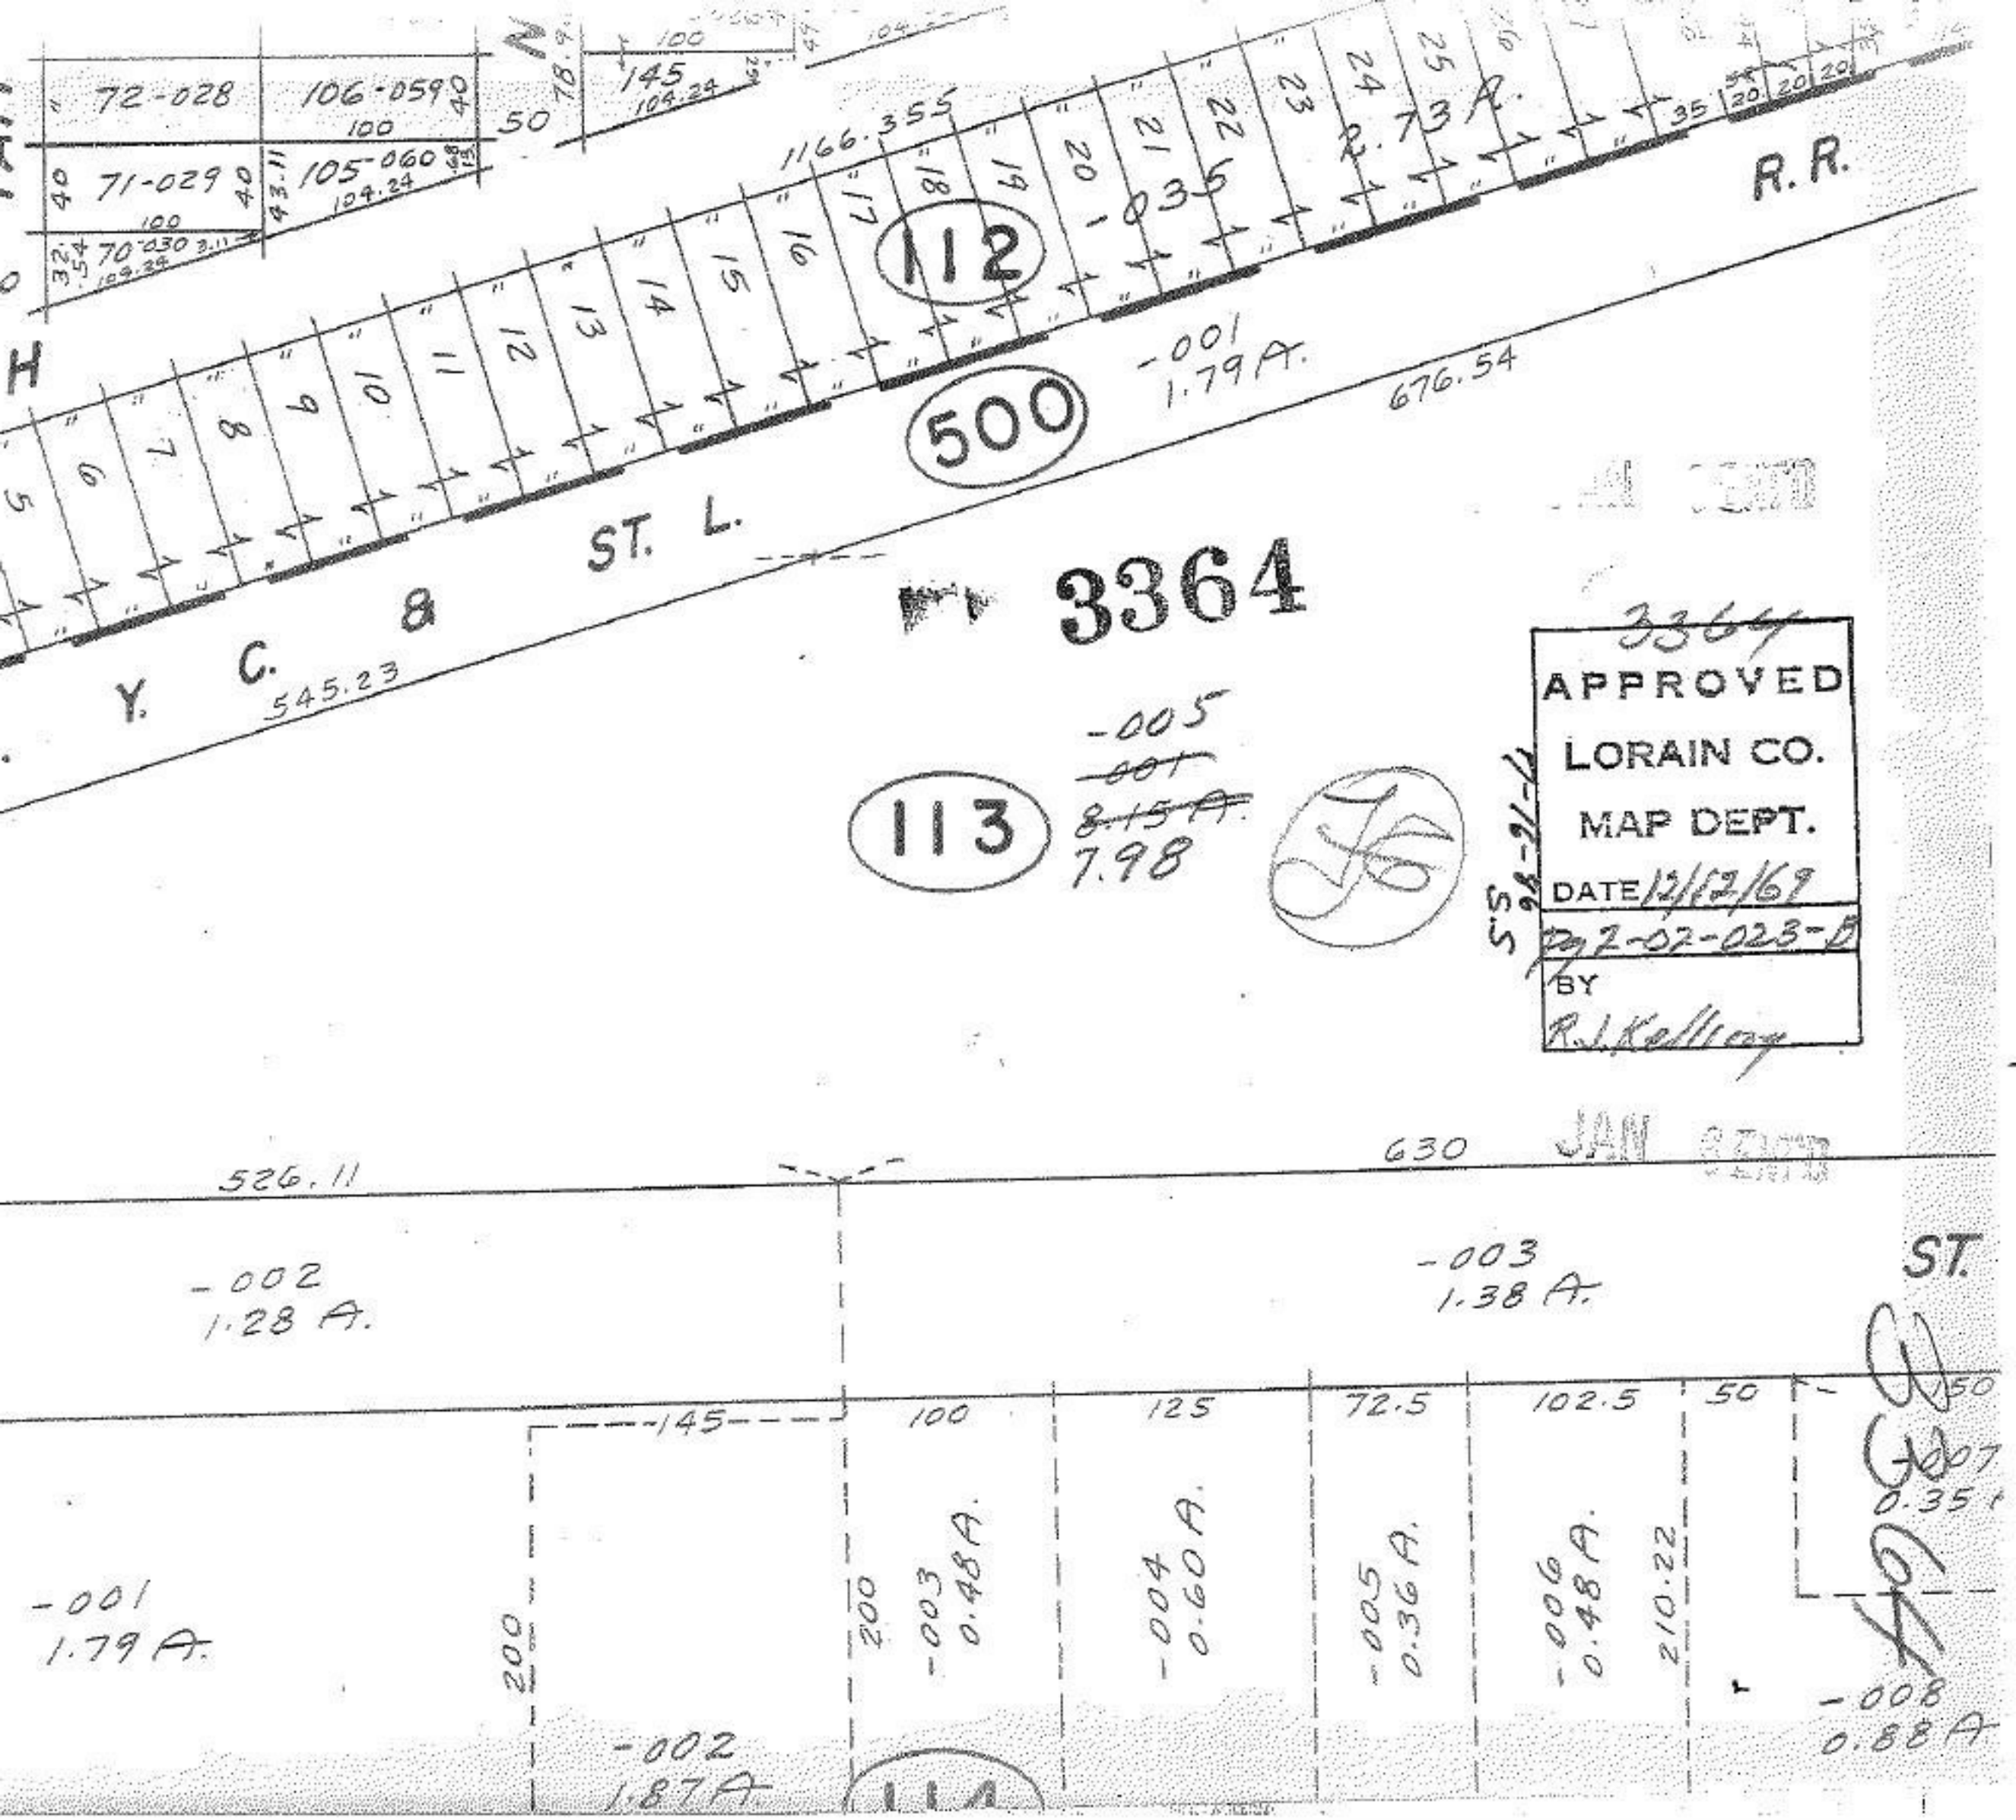

72-028
106-059
100
40
71-029
40
100
70-030
109.24
105-060
104.24
43.11
50
78.9
145
104.24
100
1166.355
112
-035
2.73 A.
R.R.
500
-001
1.79 A.
676.54
Y. C. & ST. L.
545.23
3364
113
-005
~~-001~~
~~8.15 A.~~
7.98
APPROVED
LORAIN CO.
MAP DEPT.
DATE 12/12/69
BY
R.J. Kelley
JAN
526.11
630
-002
1.28 A.
-003
1.38 A.
ST.
145
100
125
72.5
102.5
50
150
-001
1.79 A.
200
200
-003
0.48 A.
-004
0.60 A.
-005
0.36 A.
-006
0.48 A.
210.22
-007
0.35
-008
0.88 A
-002
1.87 A.
114