3368

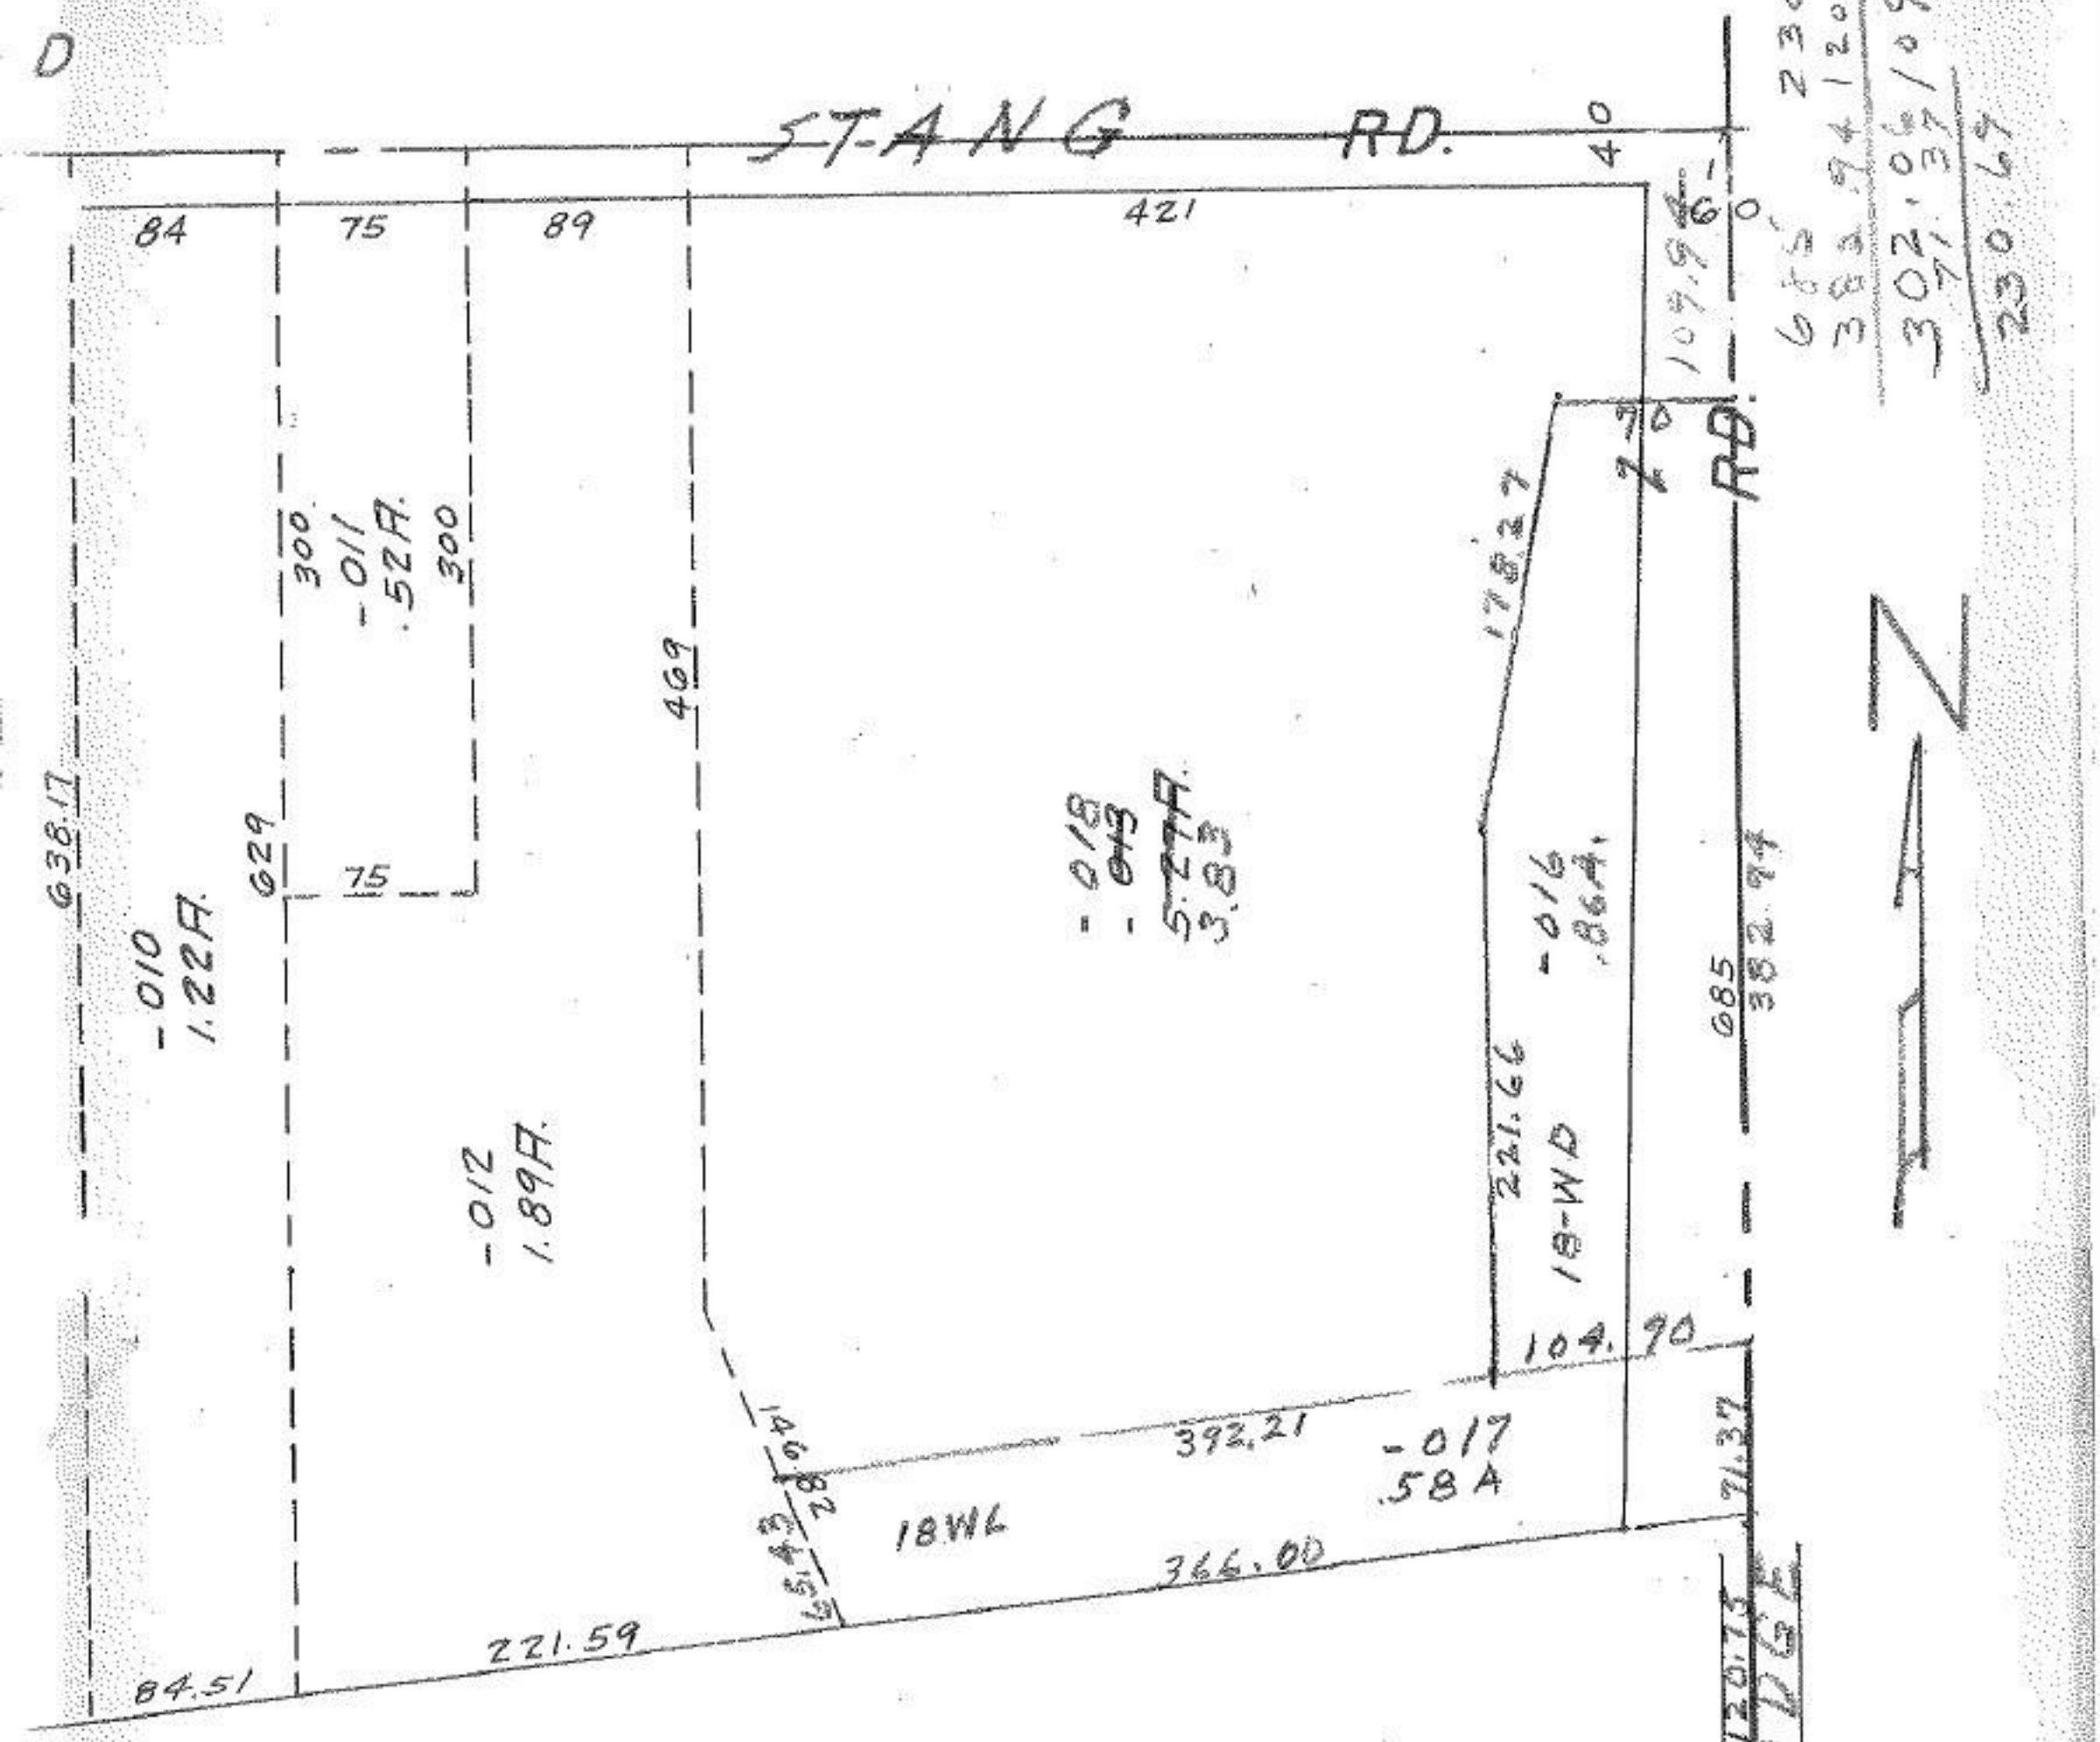

N 29 ENTD 3368

TURNPIKE

Dup. #1
Dup. #2
Total

APPROVED

16.82
43