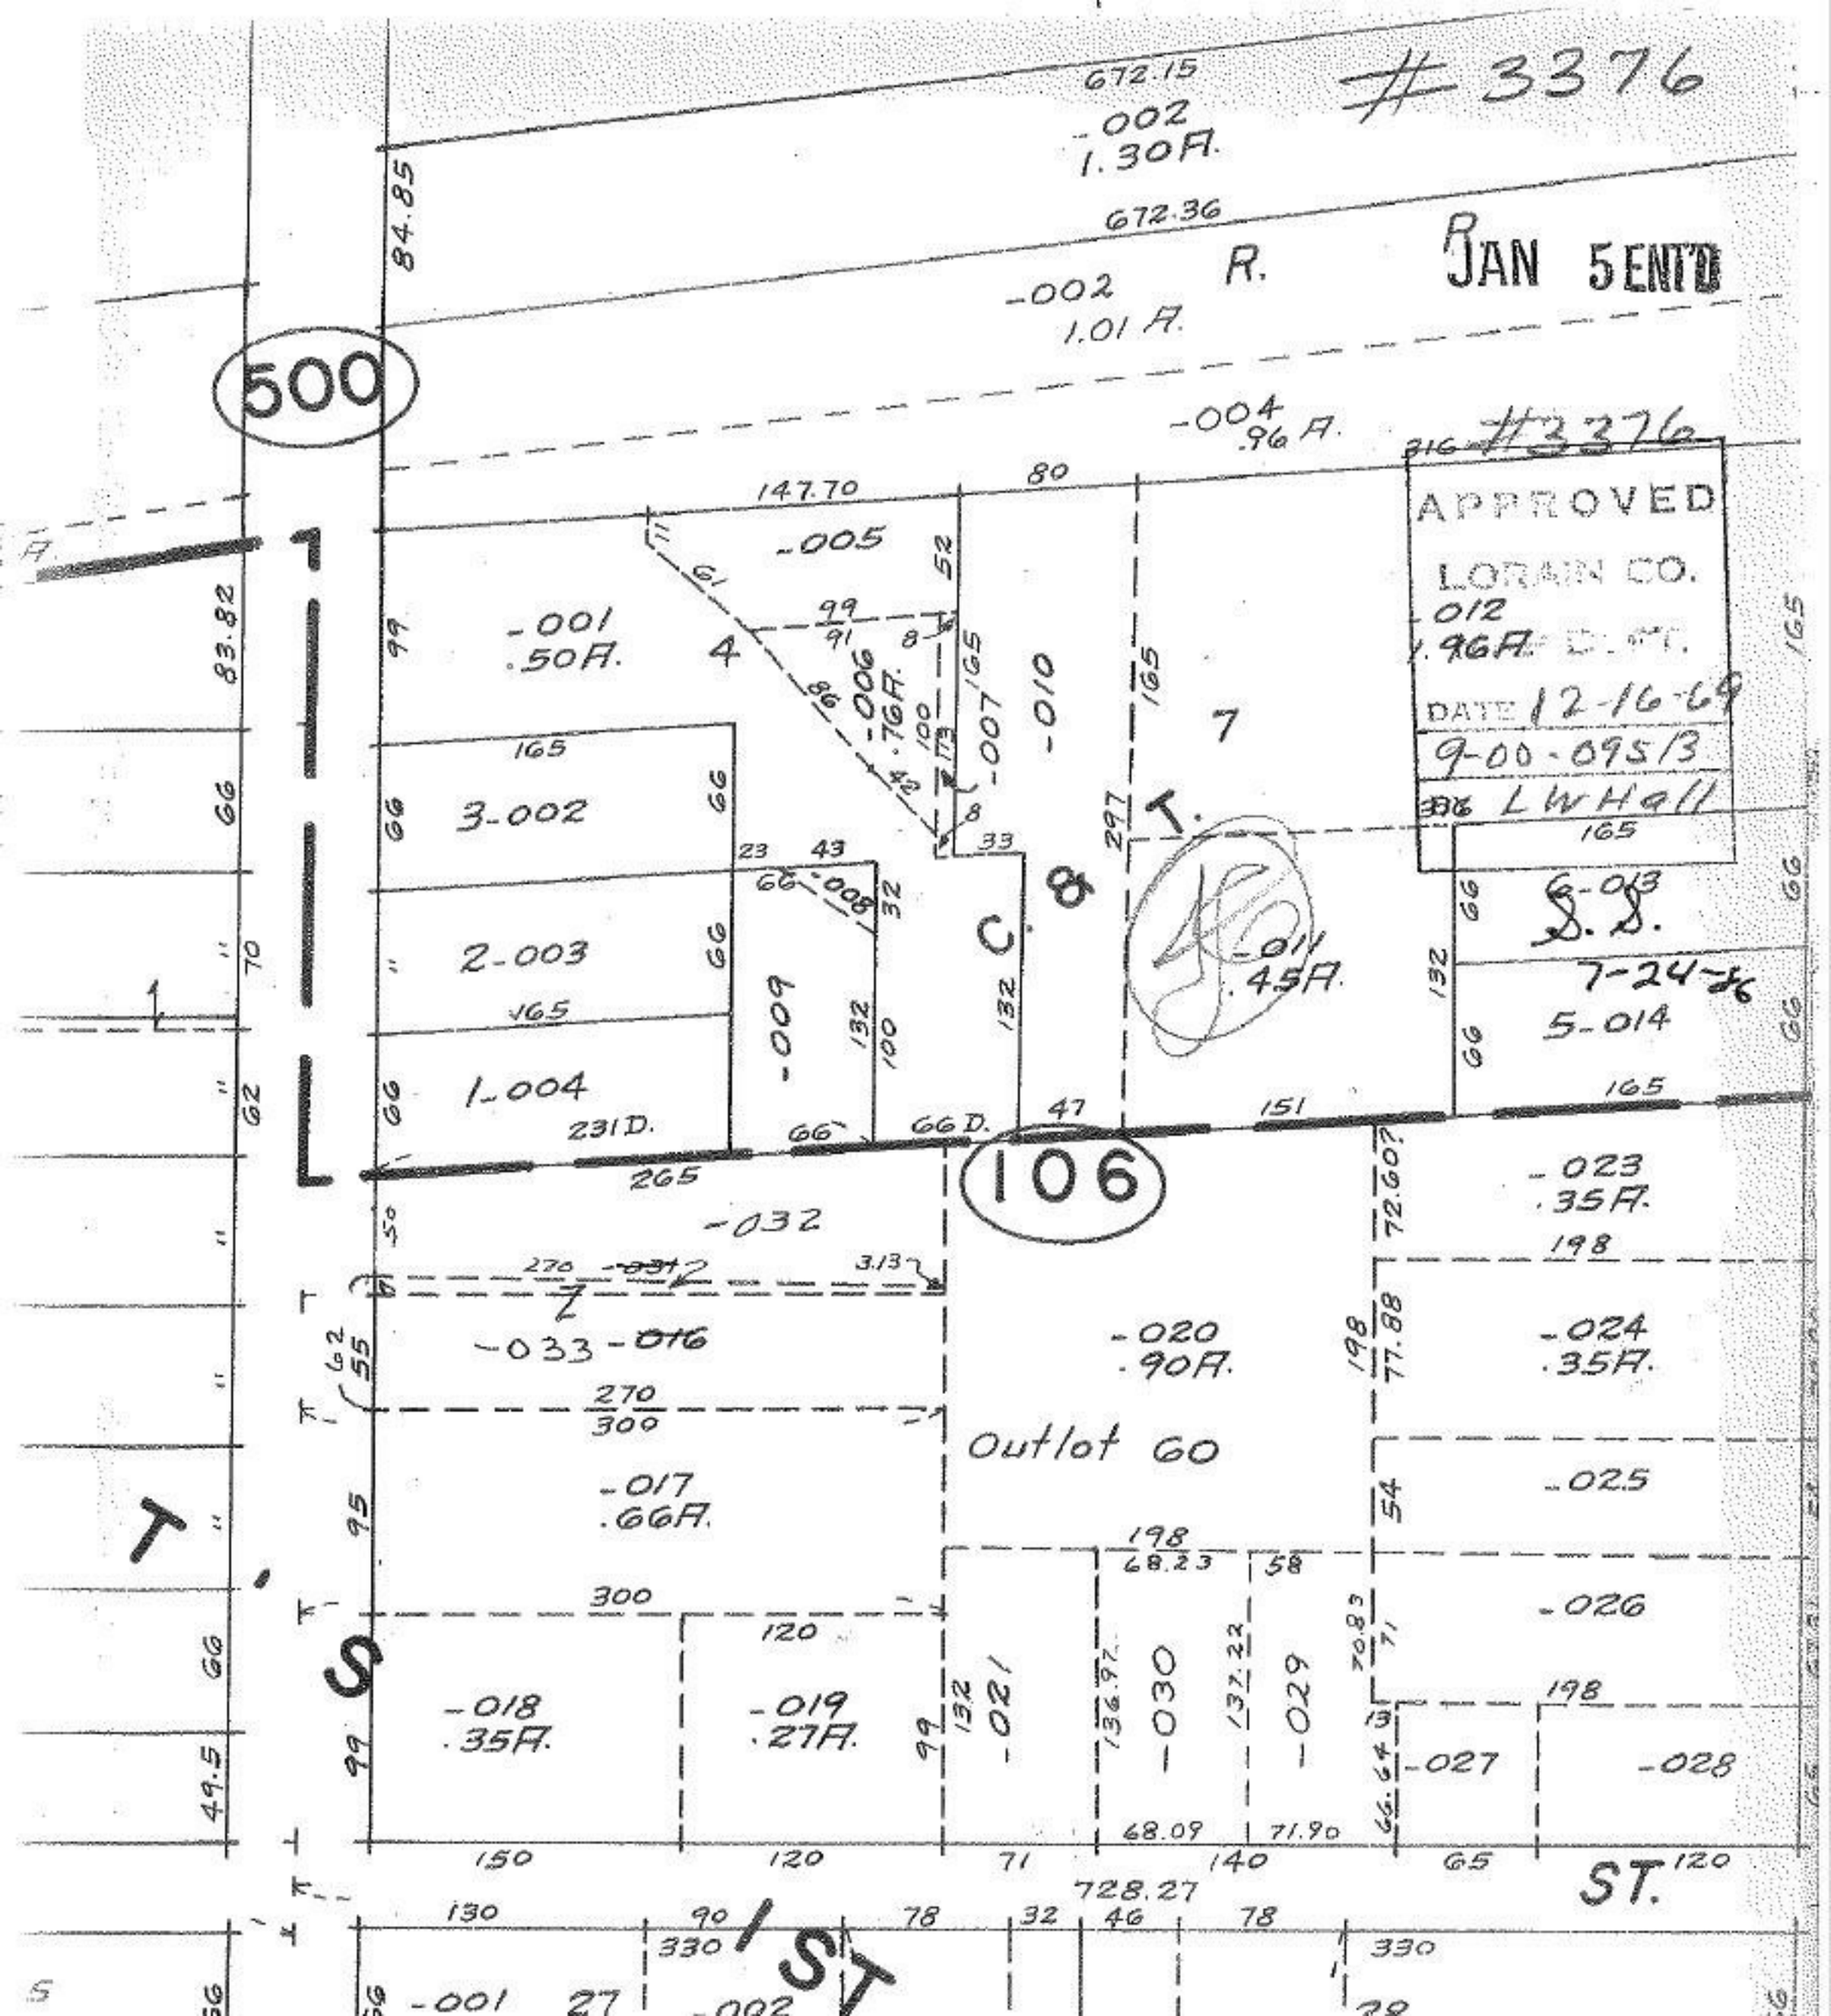

#3376
JAN 5 ENT'D
APPROVED
LORAIN CO.
DATE 12-16-69
9-00-095B
LWHall
500
106
C. & T.
S. S.
7-24-86
Outlot 60
ST.
1ST