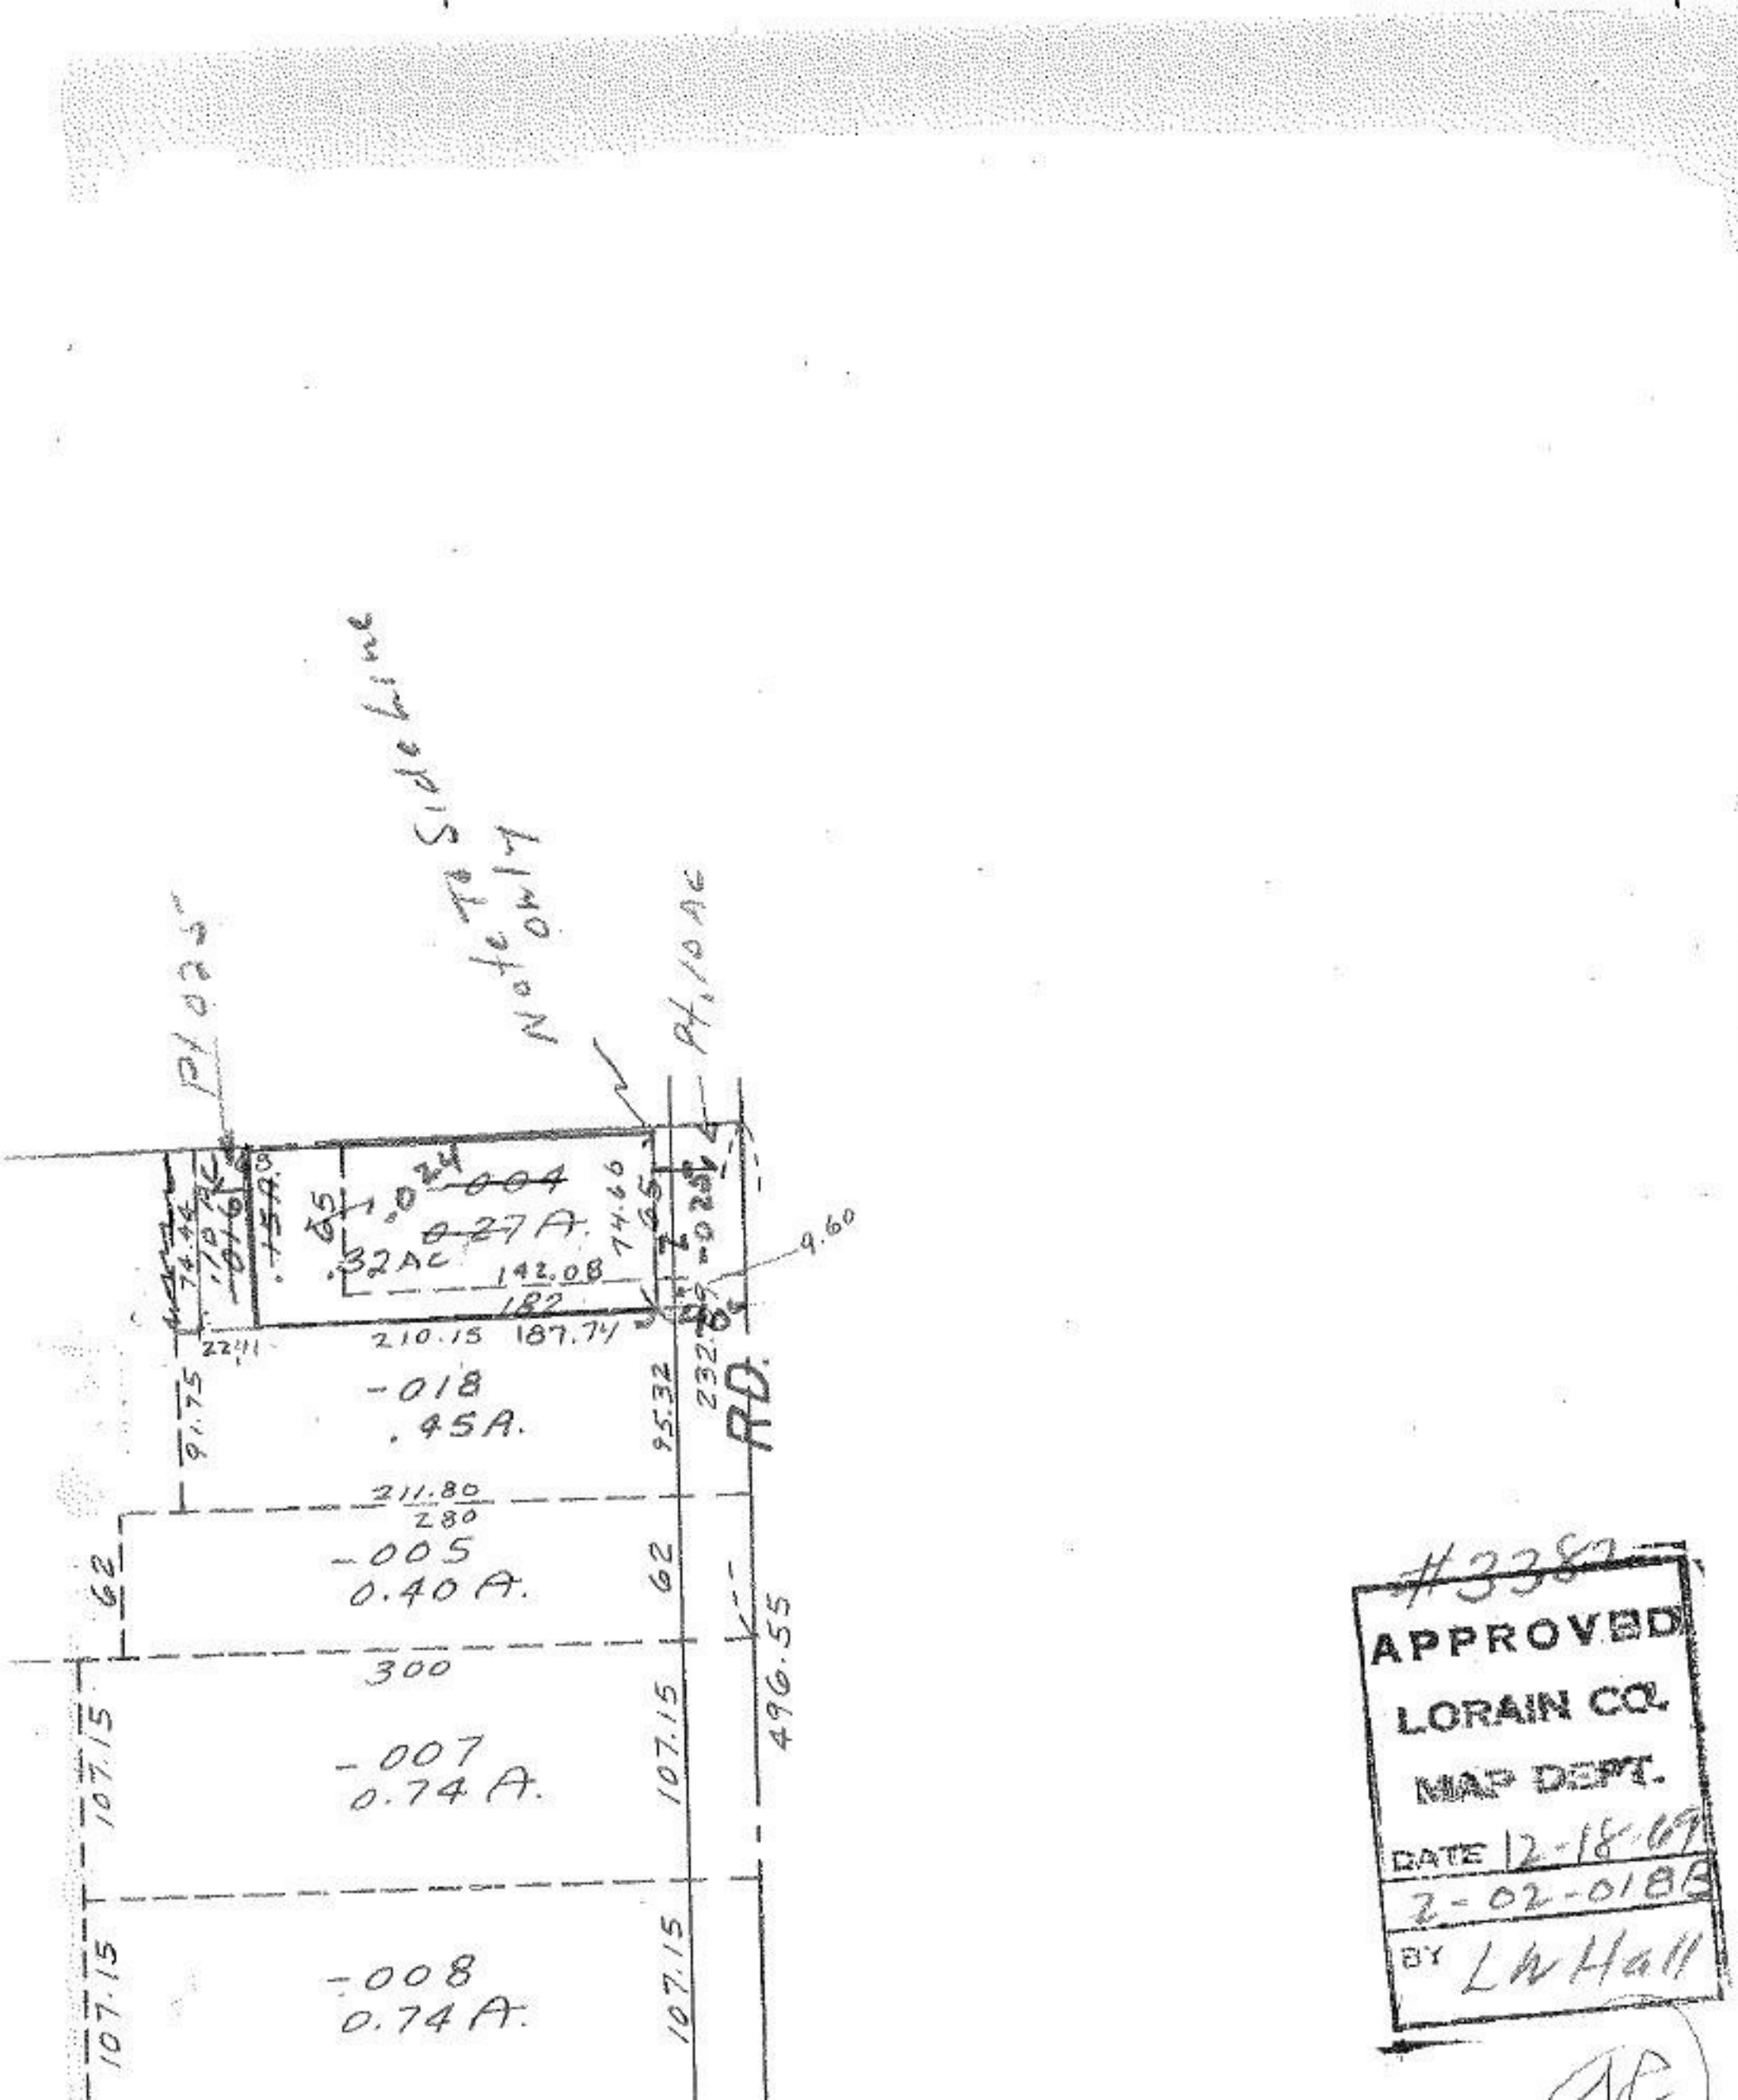

#3382

APPROVED
LORAIN CO.
MAP DEPT.
DATE 12-18-69
2-02-018
BY L W Hall