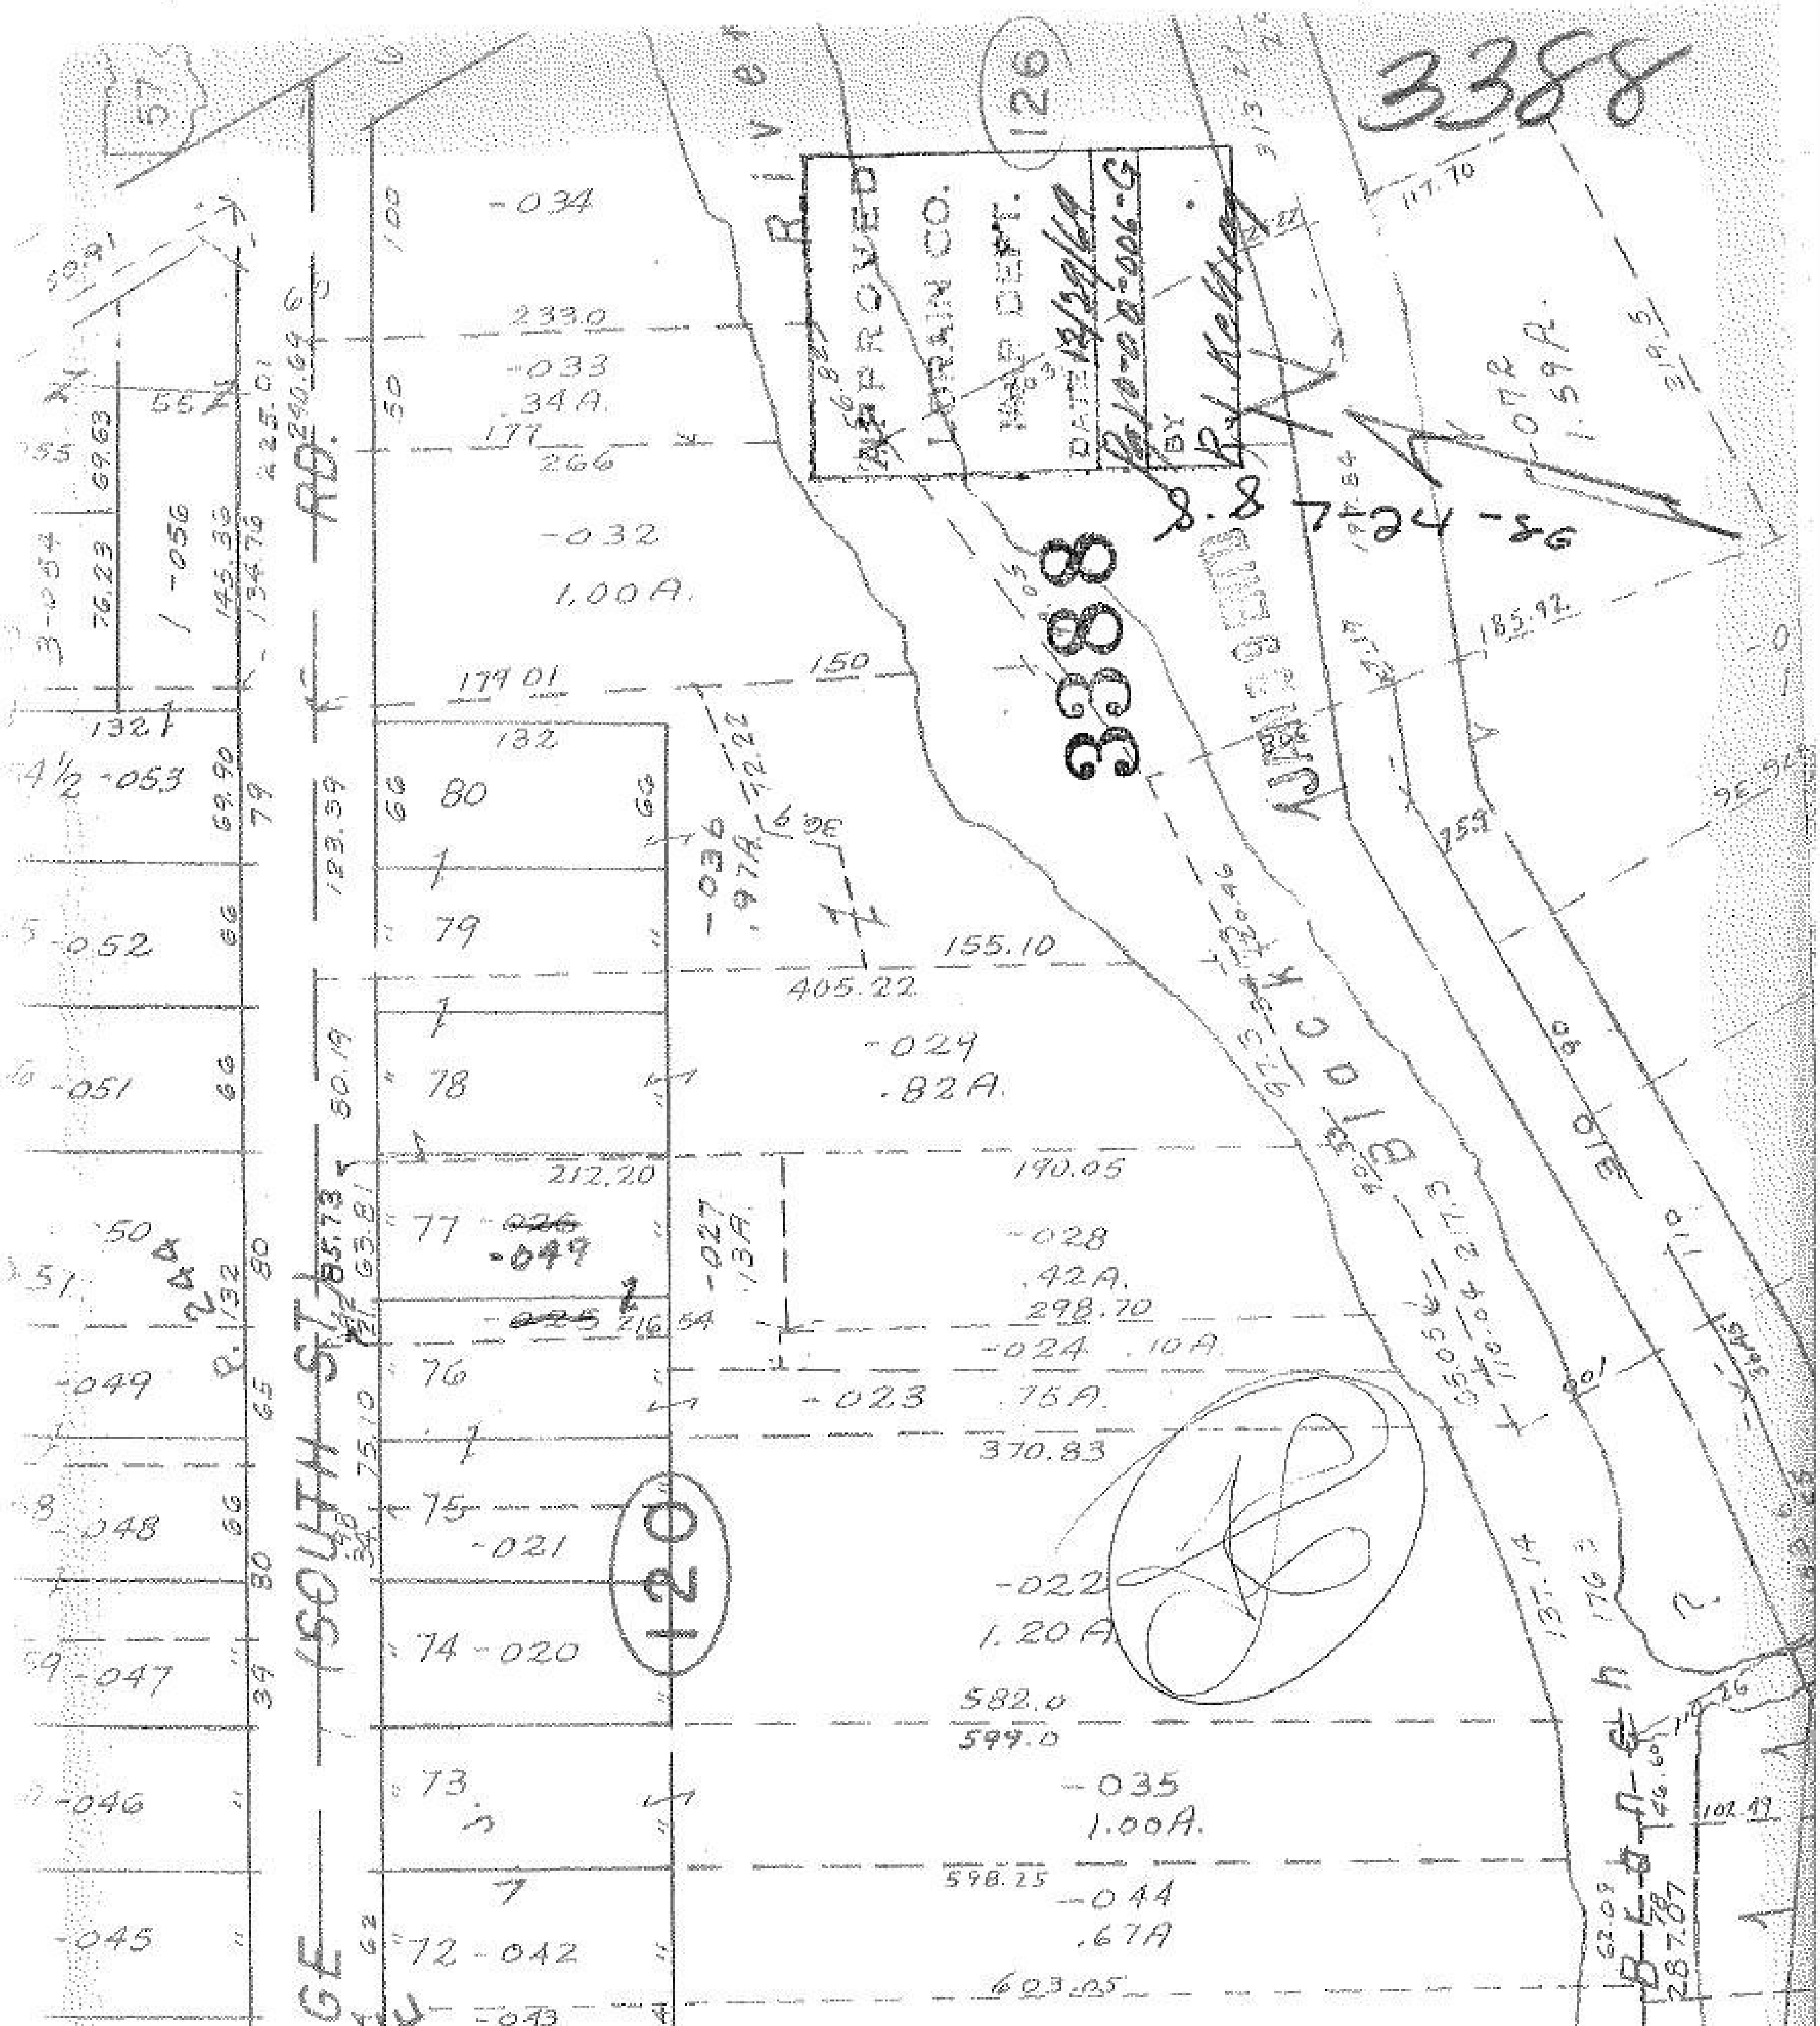

3388
APPROVED
LORAIN CO.
MAP DEPT.
DATE
BY
8.8 7-24-86
126
120
SOUTH ST.
RD.
Black River
-034
233.0
-033
.34A.
177
266
-032
1.00A.
177.01
150
132
80
79
78
77
76
75
74
73
72
-036
.97A
405.22
155.10
-029
.82A.
212.20
190.05
-027
.13A.
-028
.42A.
298.70
216.54
-024
.10A.
-023
.75A.
370.83
-021
-020
-022
1.20A
582.0
599.0
-035
1.00A.
598.25
-044
.67A
603.85
-042
-043
-072
1.59A.
117.70
185.92
-056
-054
-053
-052
-051
-049
-048
-047
-046
-045
123.59
50.19
65.81
85.73
145.39
134.79
225.01
240.64
76.23
69.63
69.90
102.49