3396

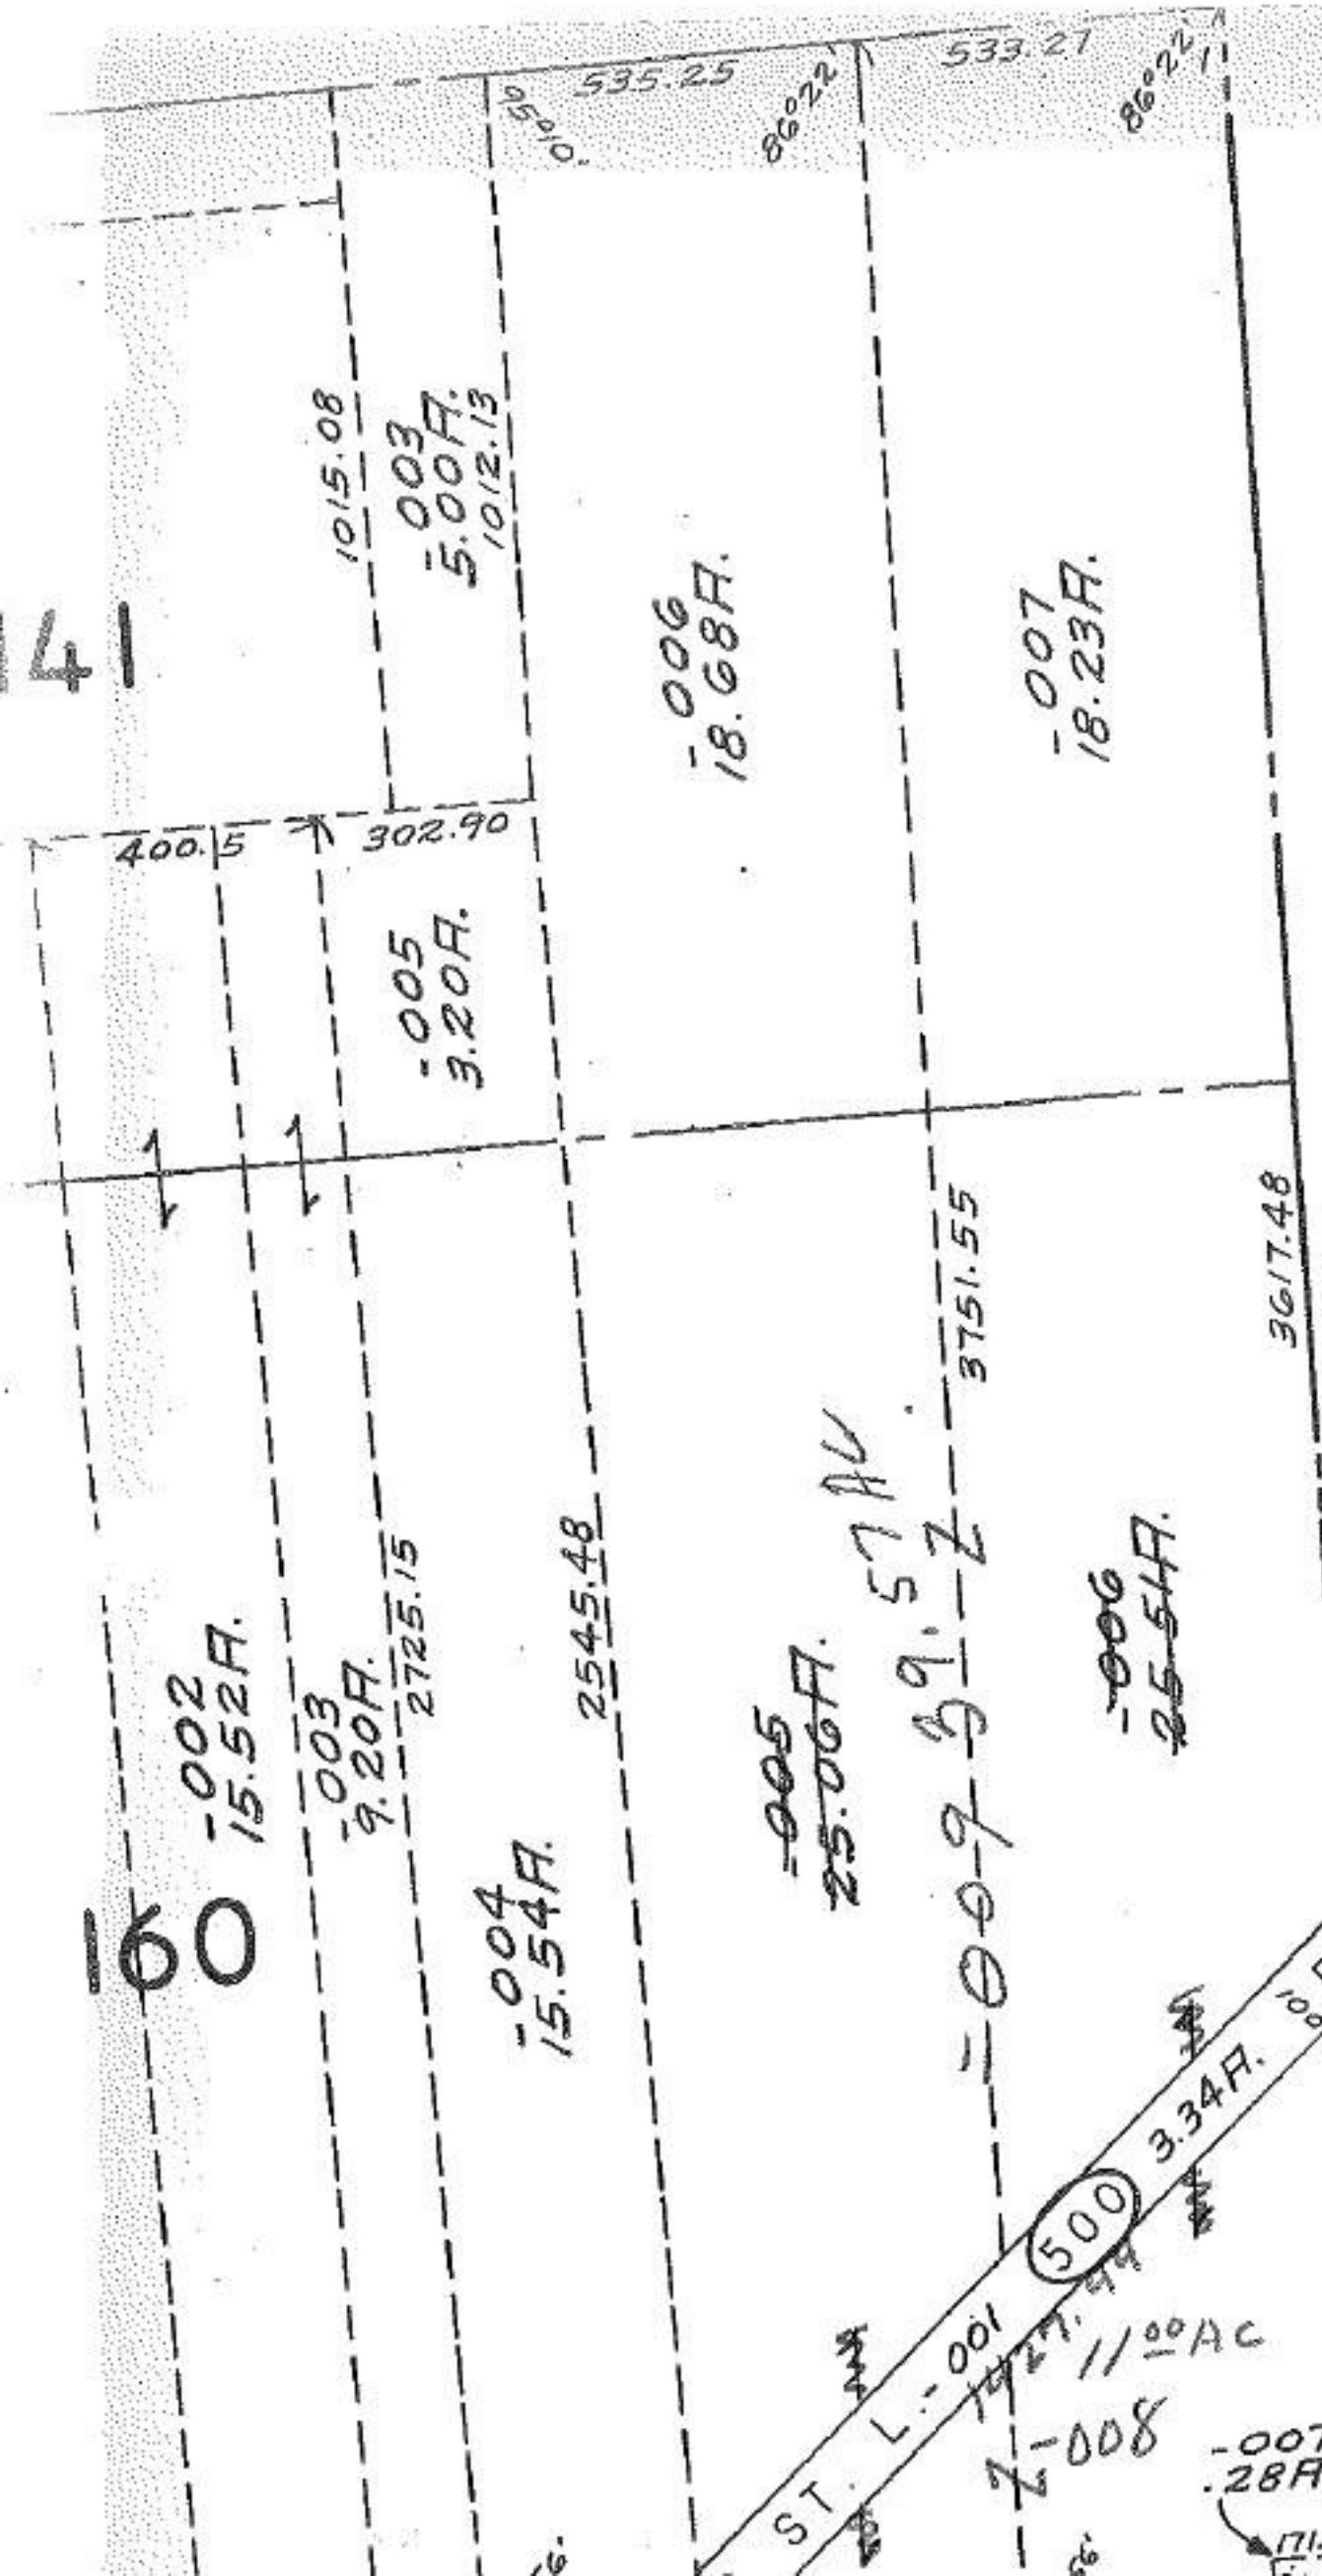

JAN 29 ENT'D

#3396
APPROVED
LOGAN CO.
MAP DEPT.
DATE 1-13-70
LLH
BY LLH

7-28-81 LLH

#3396