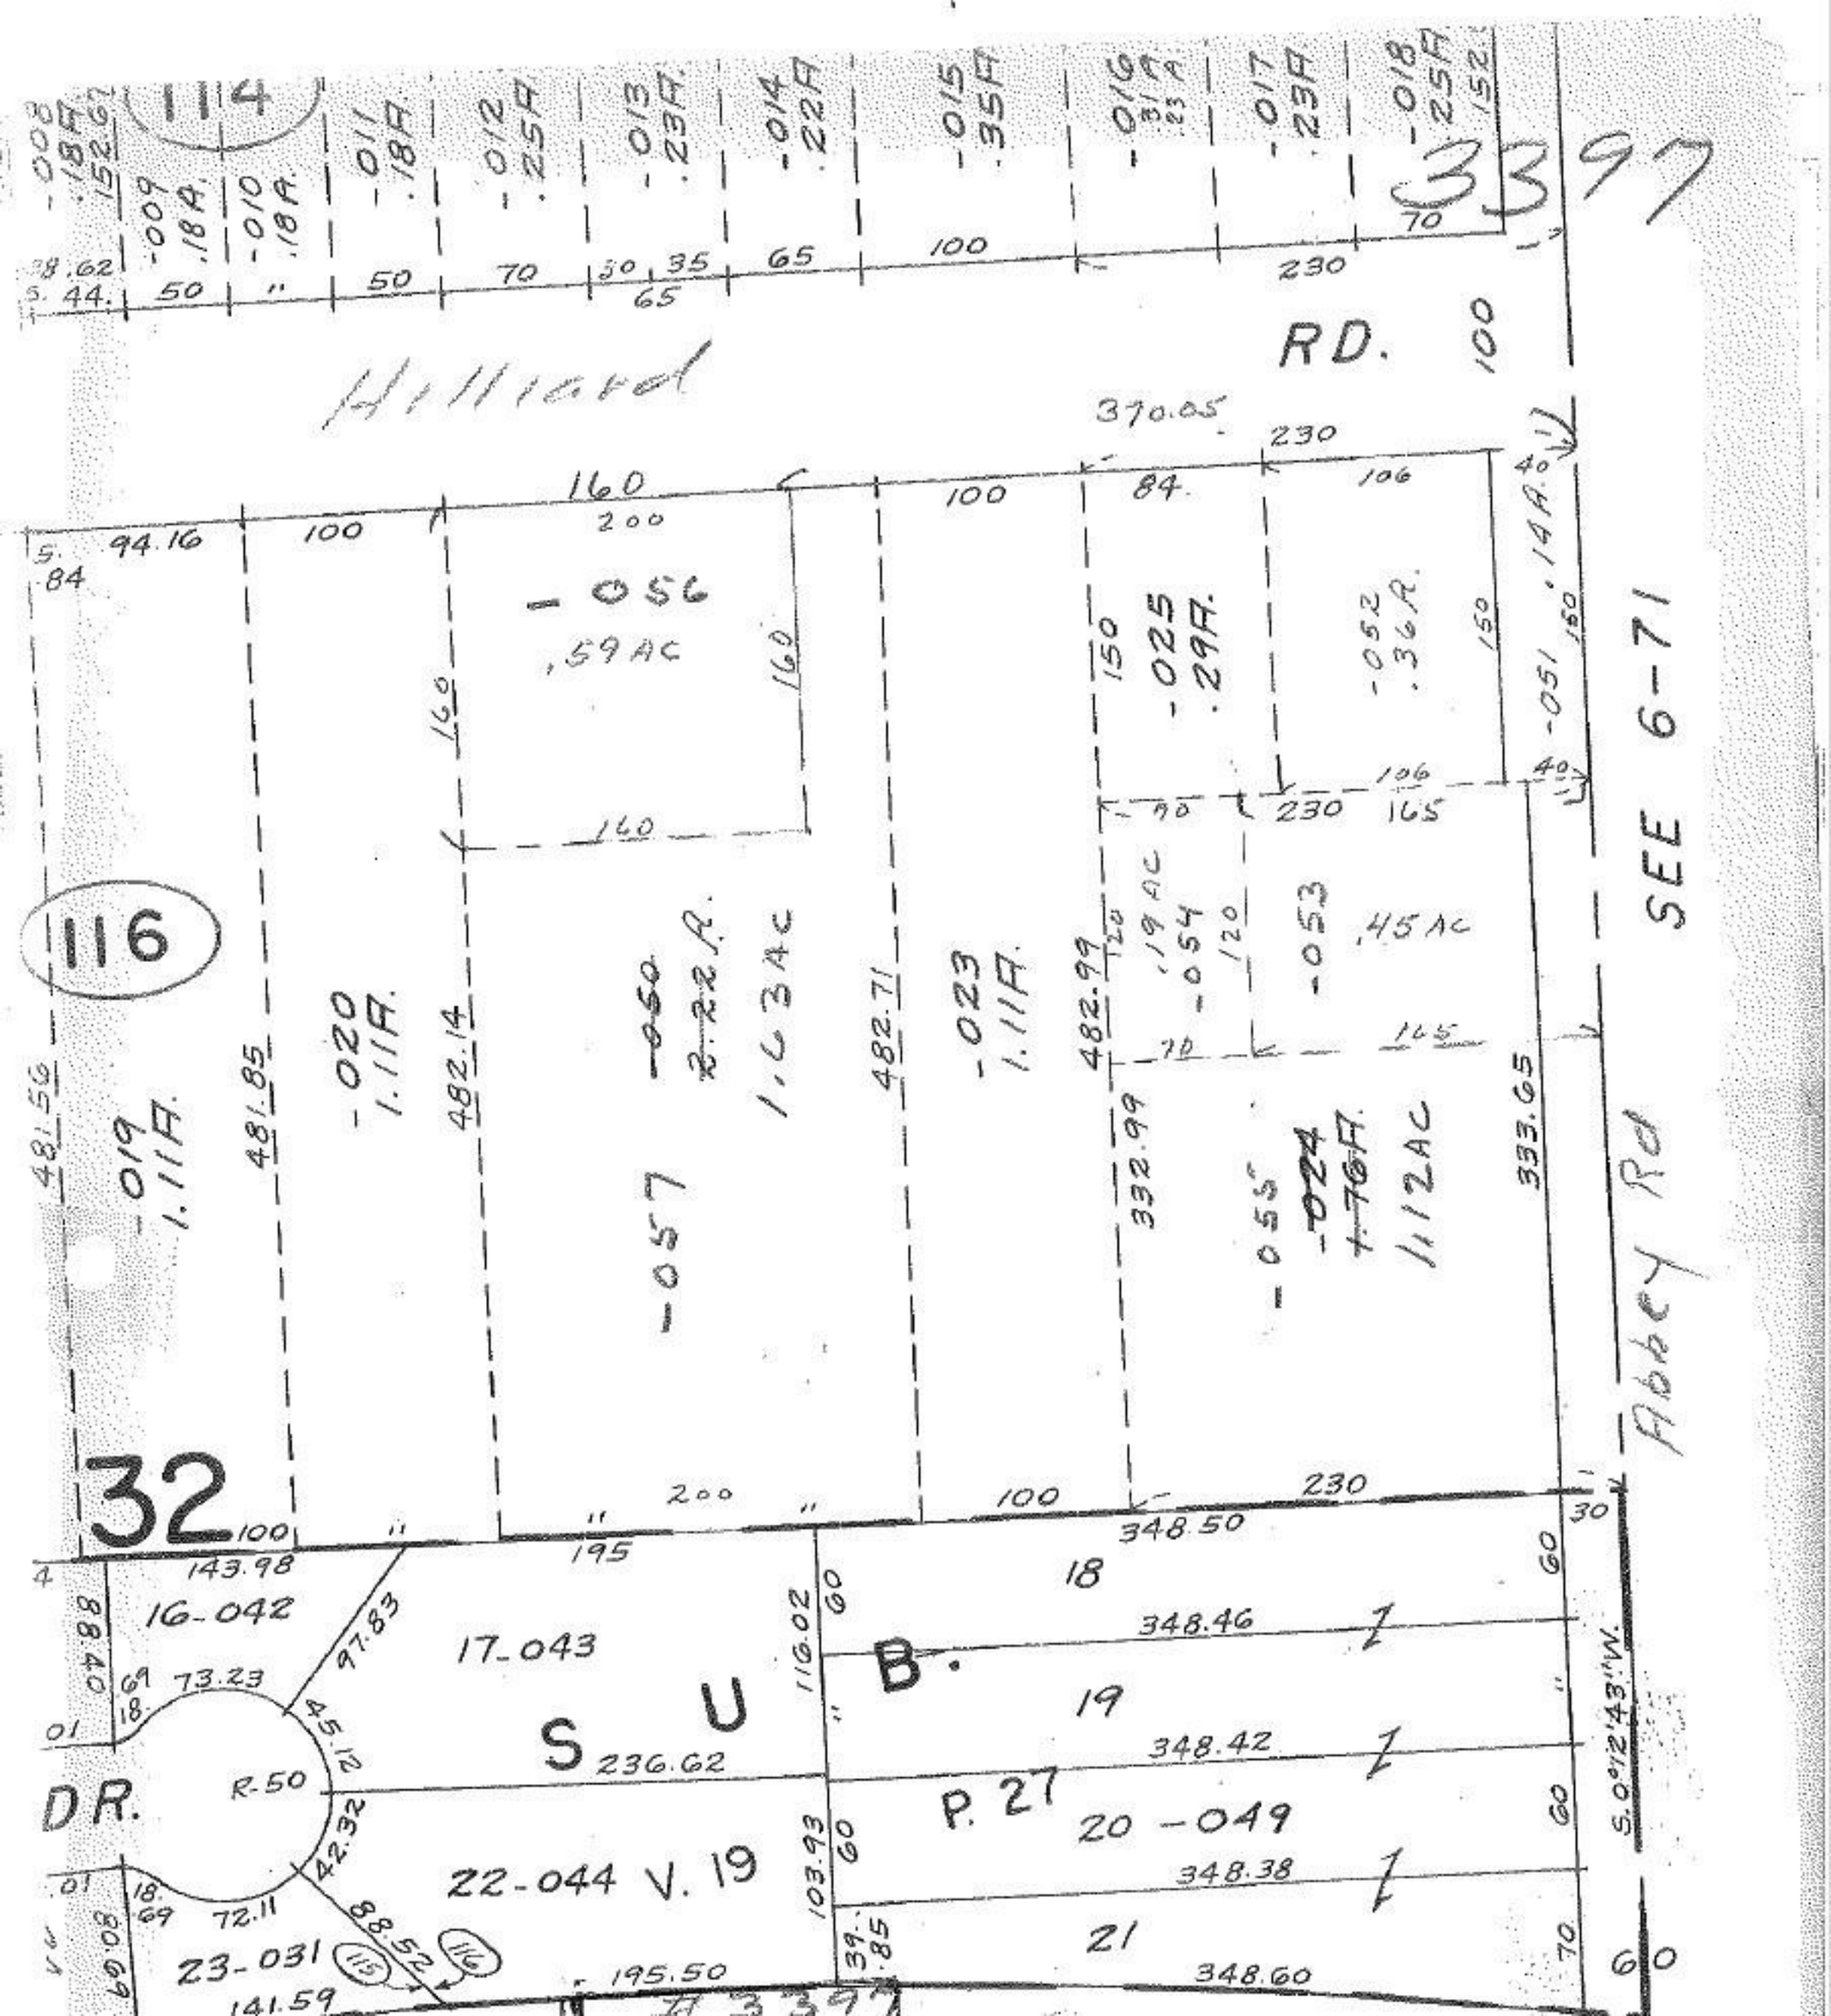

114
3397
Hilliard
RD.
370.05
160
200
100
84
106
94.16
-056
.59 AC
-025
.29A.
-052
.36A.
-051
.14A.
SEE 6-71
116
-019
1.11A.
481.56
481.85
-020
1.11A.
482.14
-050
2.22A.
1.63 AC
-057
482.71
-023
1.11A.
482.99
332.99
-054
.19 AC
-053
.45 AC
-055
-024
1.76A.
1.12AC
333.65
Abbey Rd
32
143.98
195
348.50
16-042
17-043
18
348.46
19
348.42
S U B.
236.62
P. 27
20-049
348.38
22-044 V. 19
21
348.60
DR.
R-50
73.23
97.83
45.12
42.32
72.11
88.52
23-031
141.59
195.50
116.02
103.93
S.0°12'43"W.