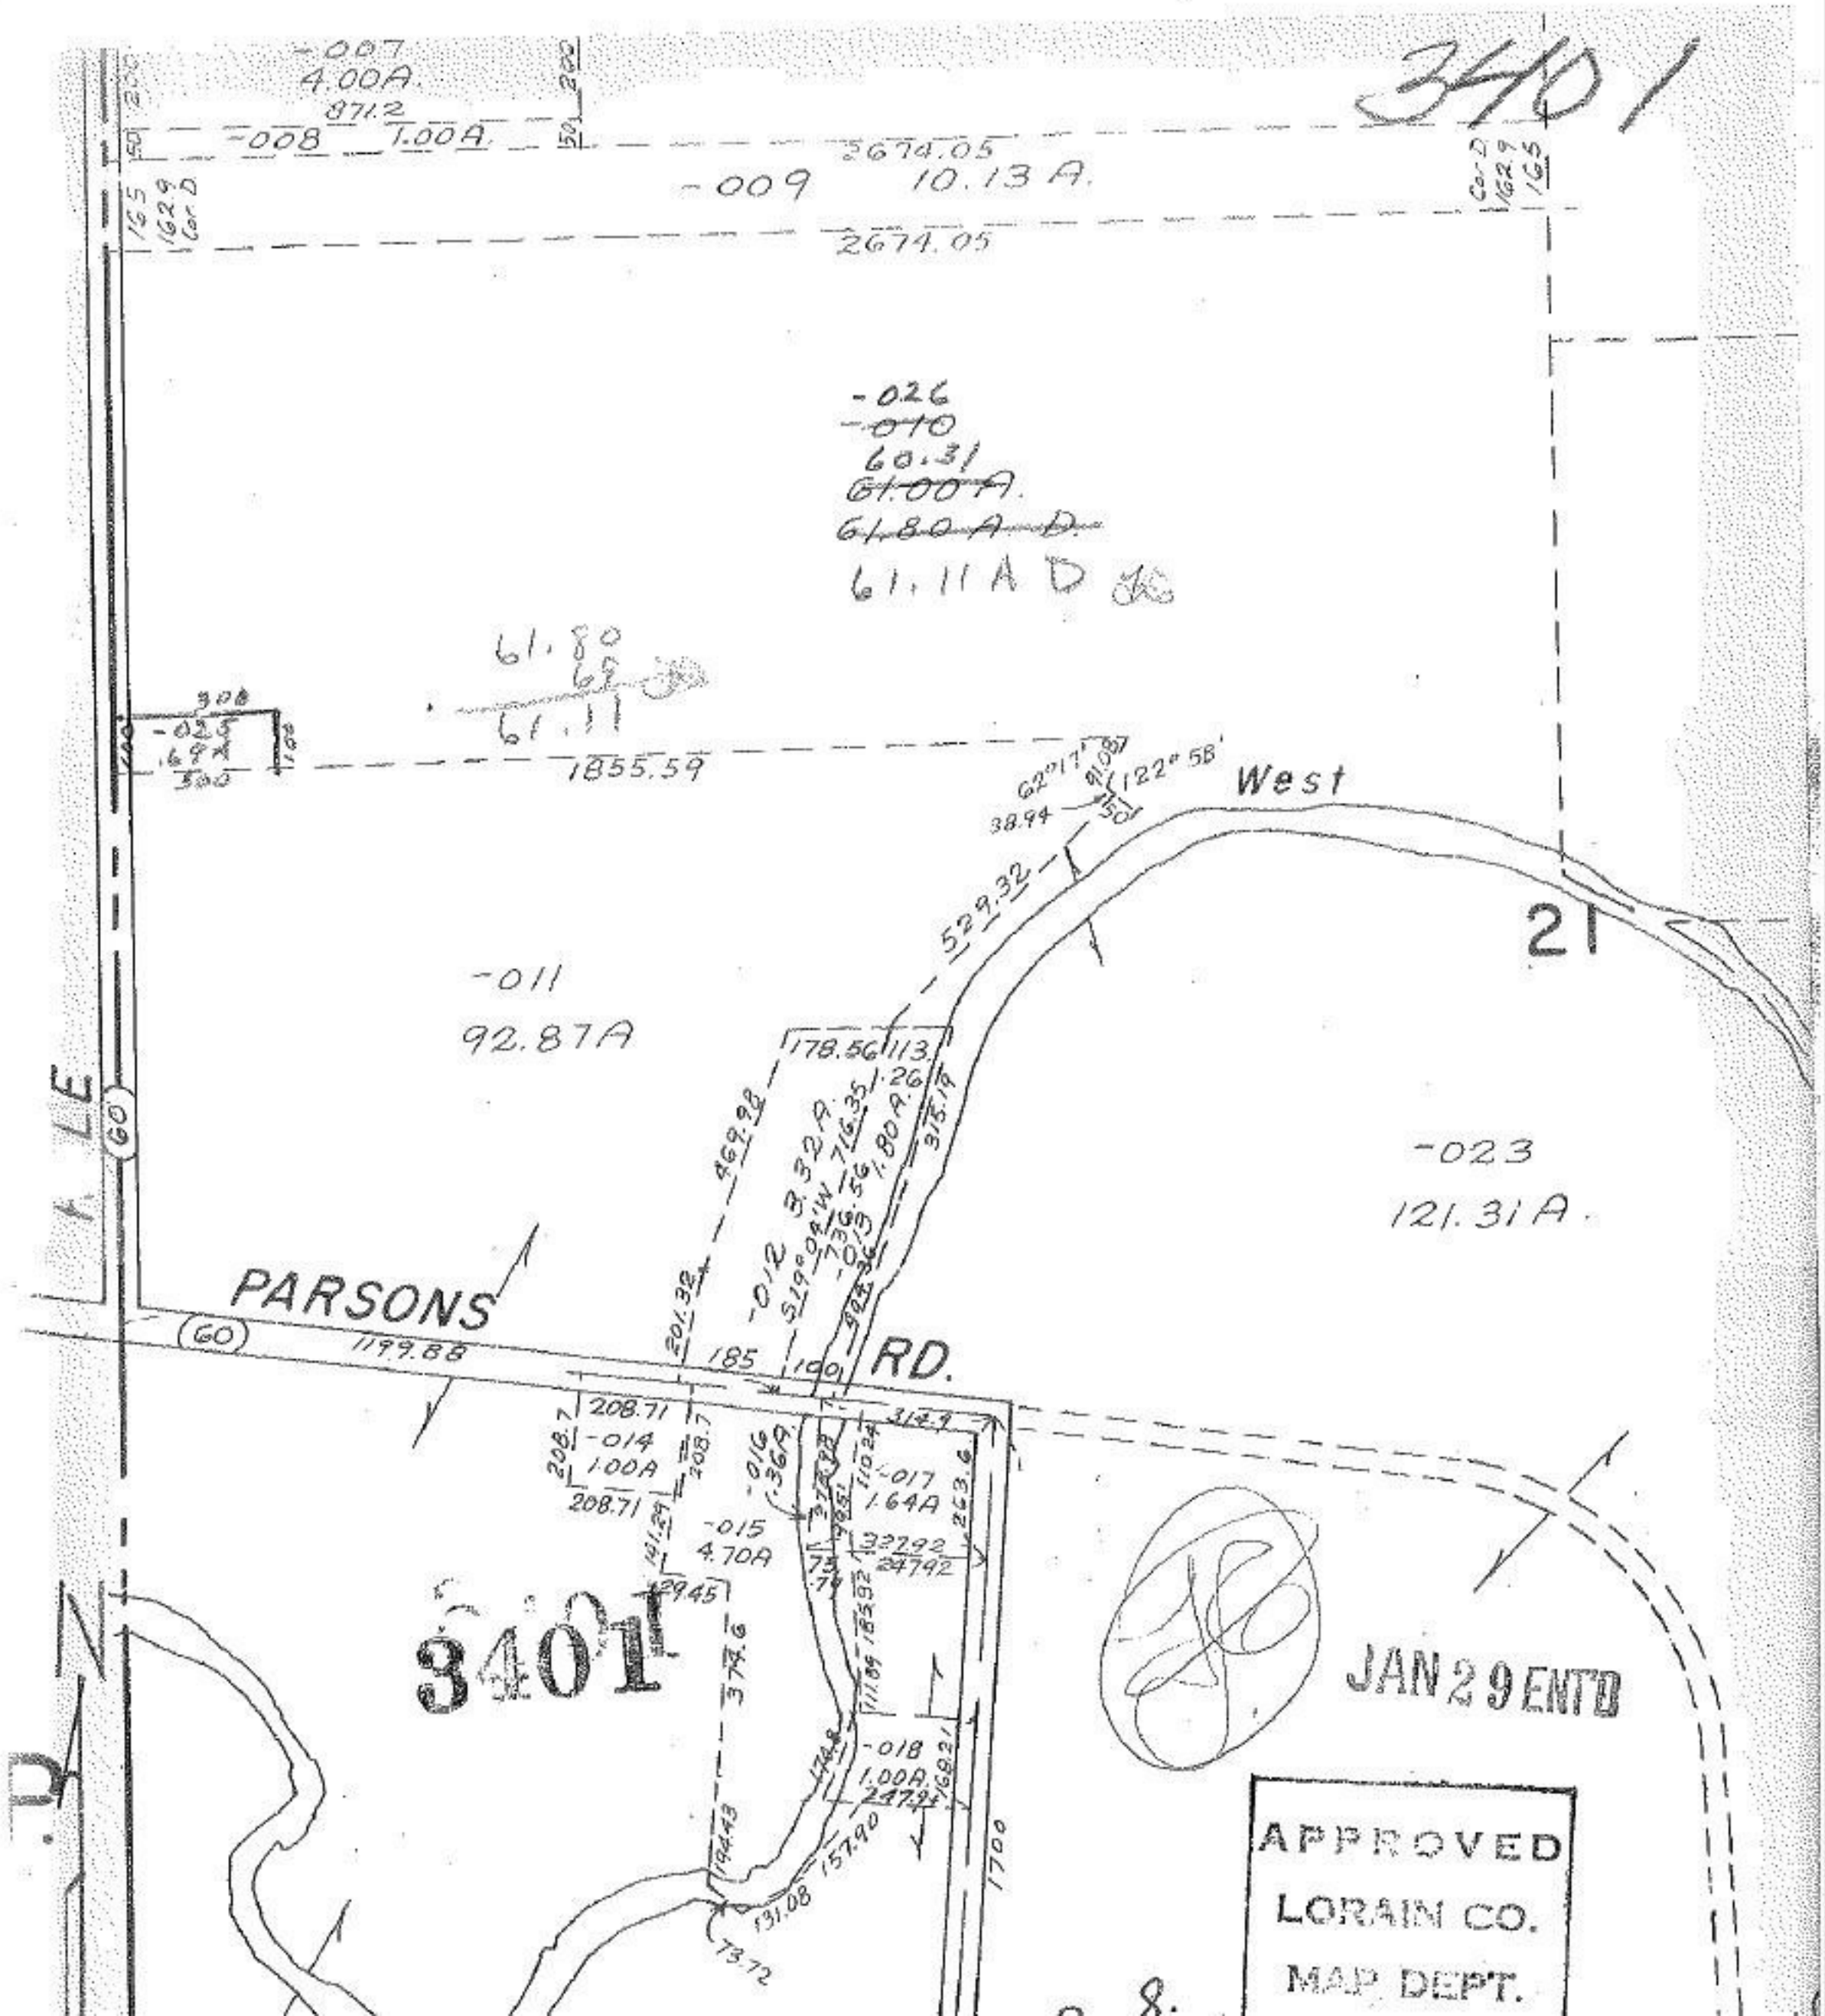
3401
-007
4.00A.
871.2
-008 1.00A.
2674.05
-009 10.13 A.
2674.05
-026
~~-010~~
60.31
~~61.00 A.~~
~~61.80 A. D.~~
61.11 A D
61.80
69
61.11
1855.59
West
21
-011
92.87A
-023
121.31 A.
PARSONS
RD.
1199.88
-014
1.00A
-015
4.70A
-017
1.64A
-018
1.00A.
3401
JAN 29 ENTD
APPROVED
LORAIN CO.
MAP DEPT.