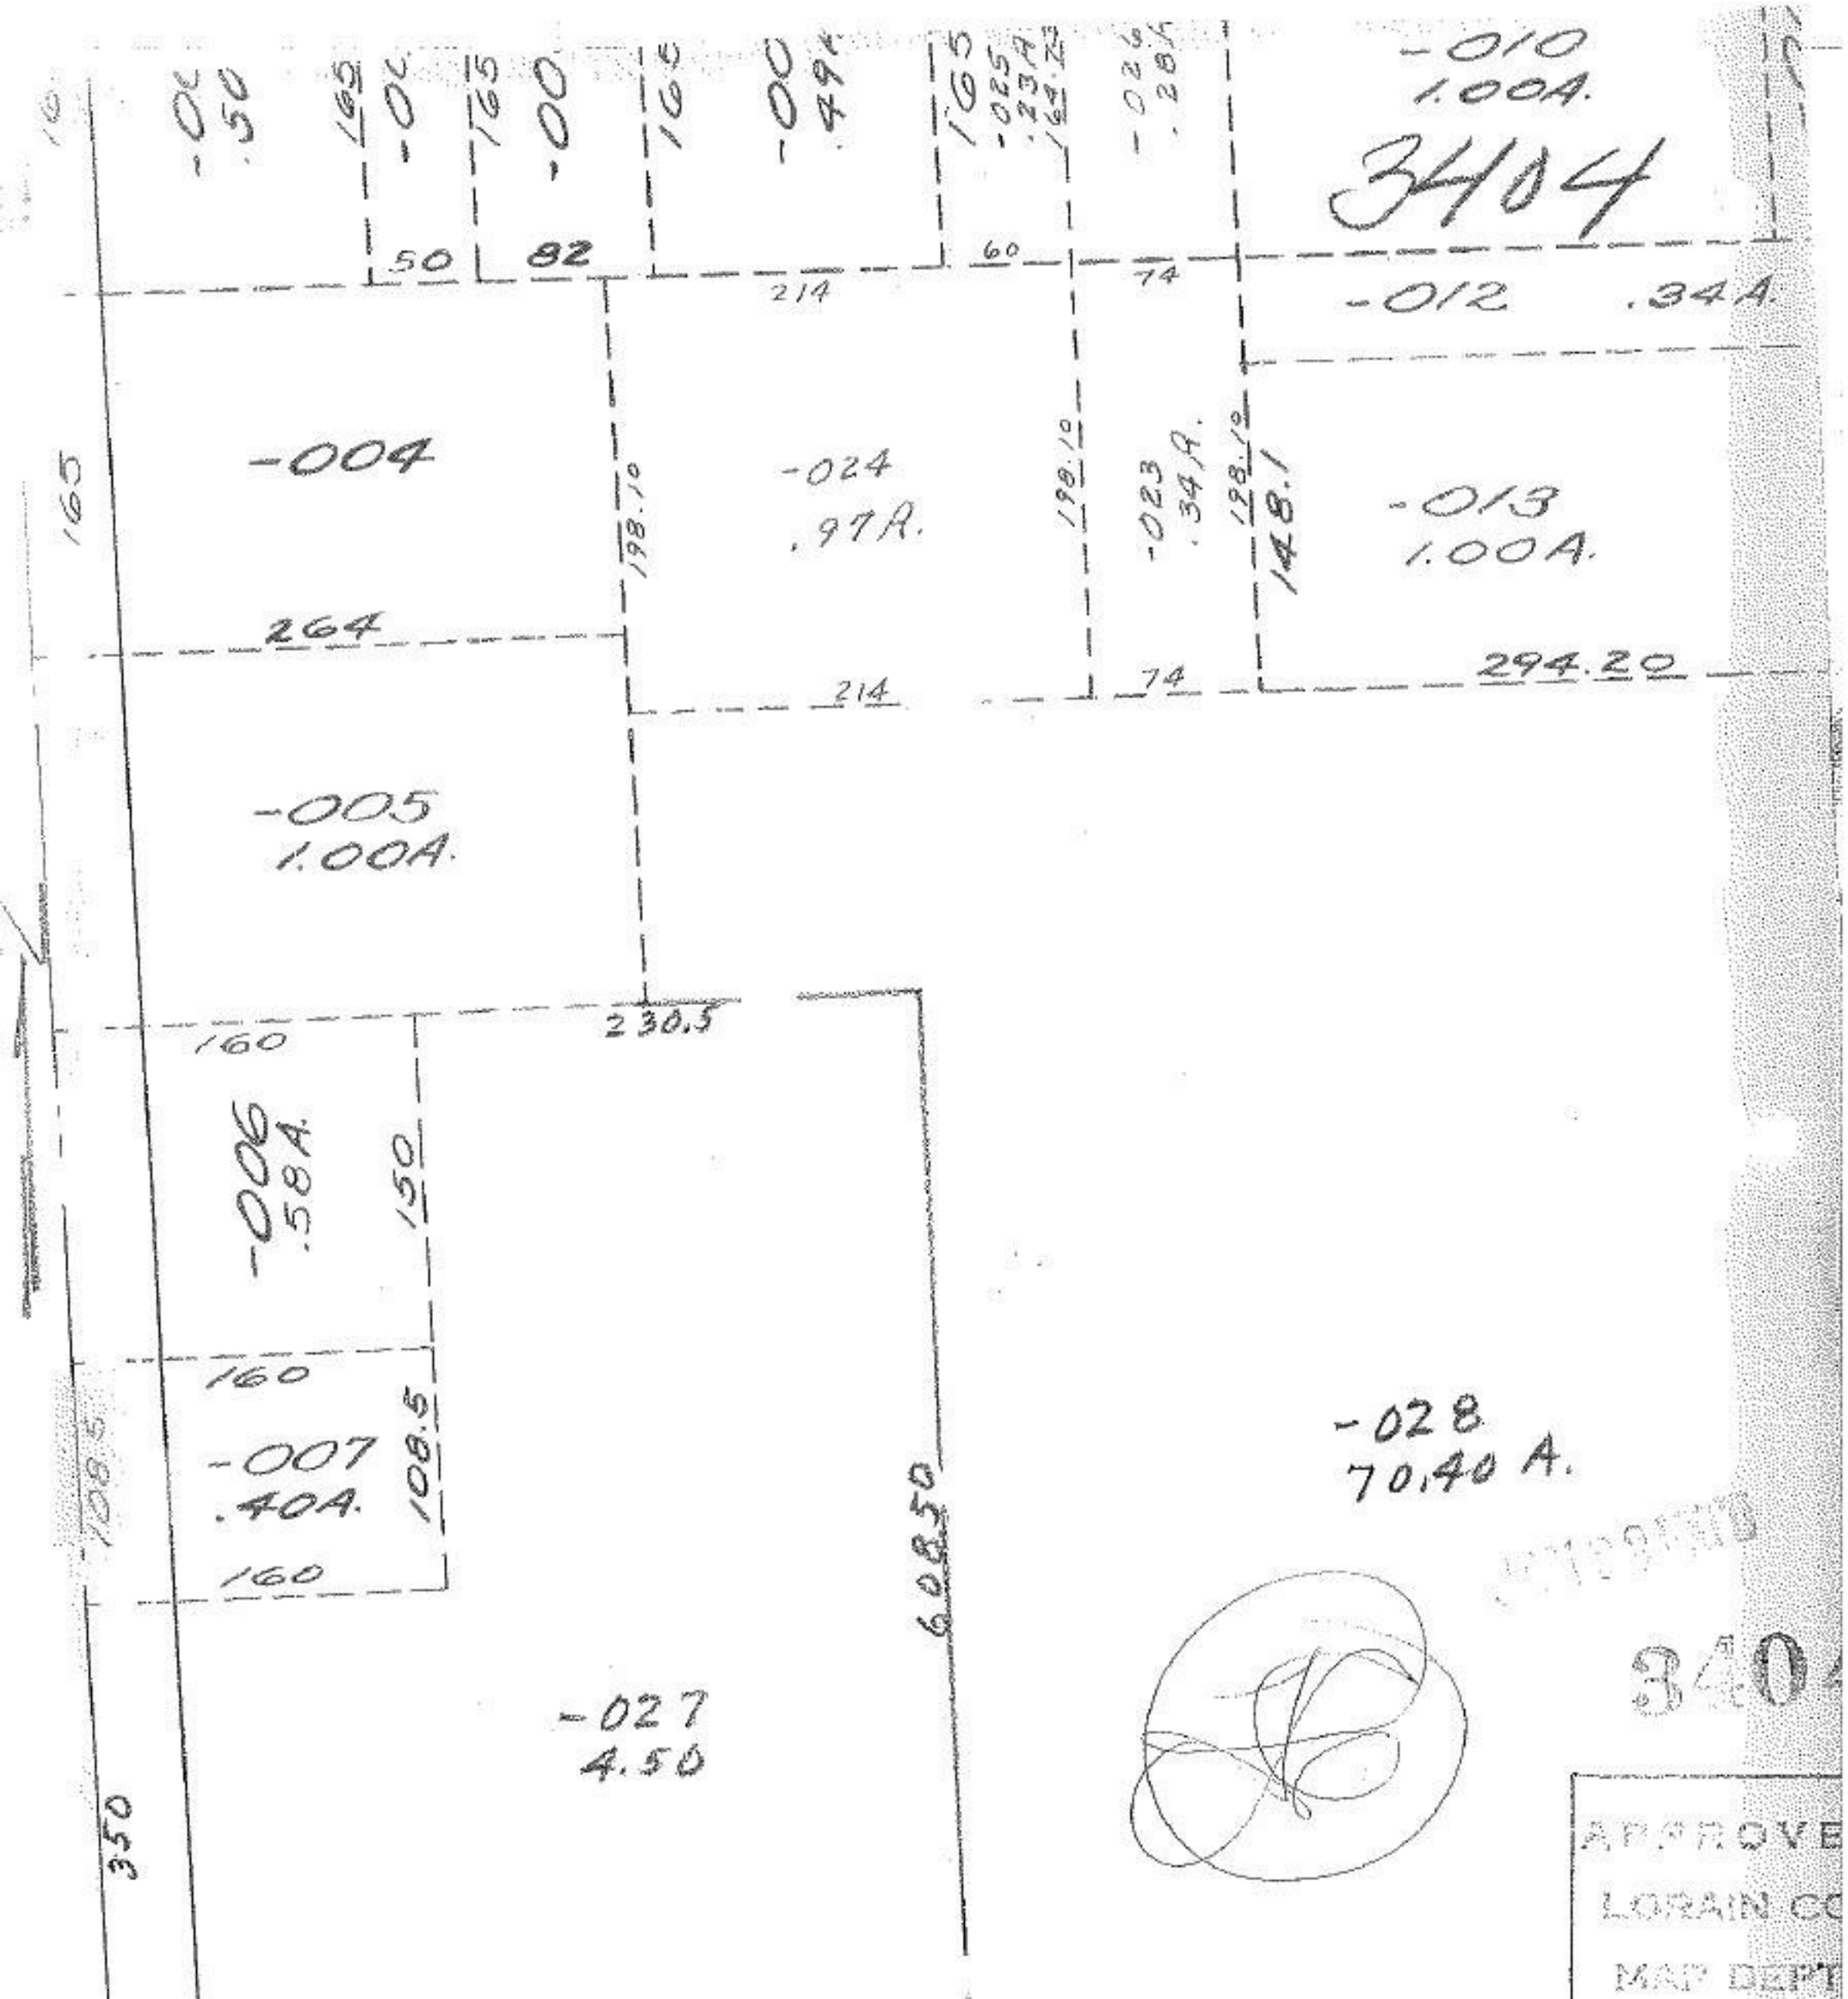

3404
APPROVE
LORAIN CO
MAP DEPT