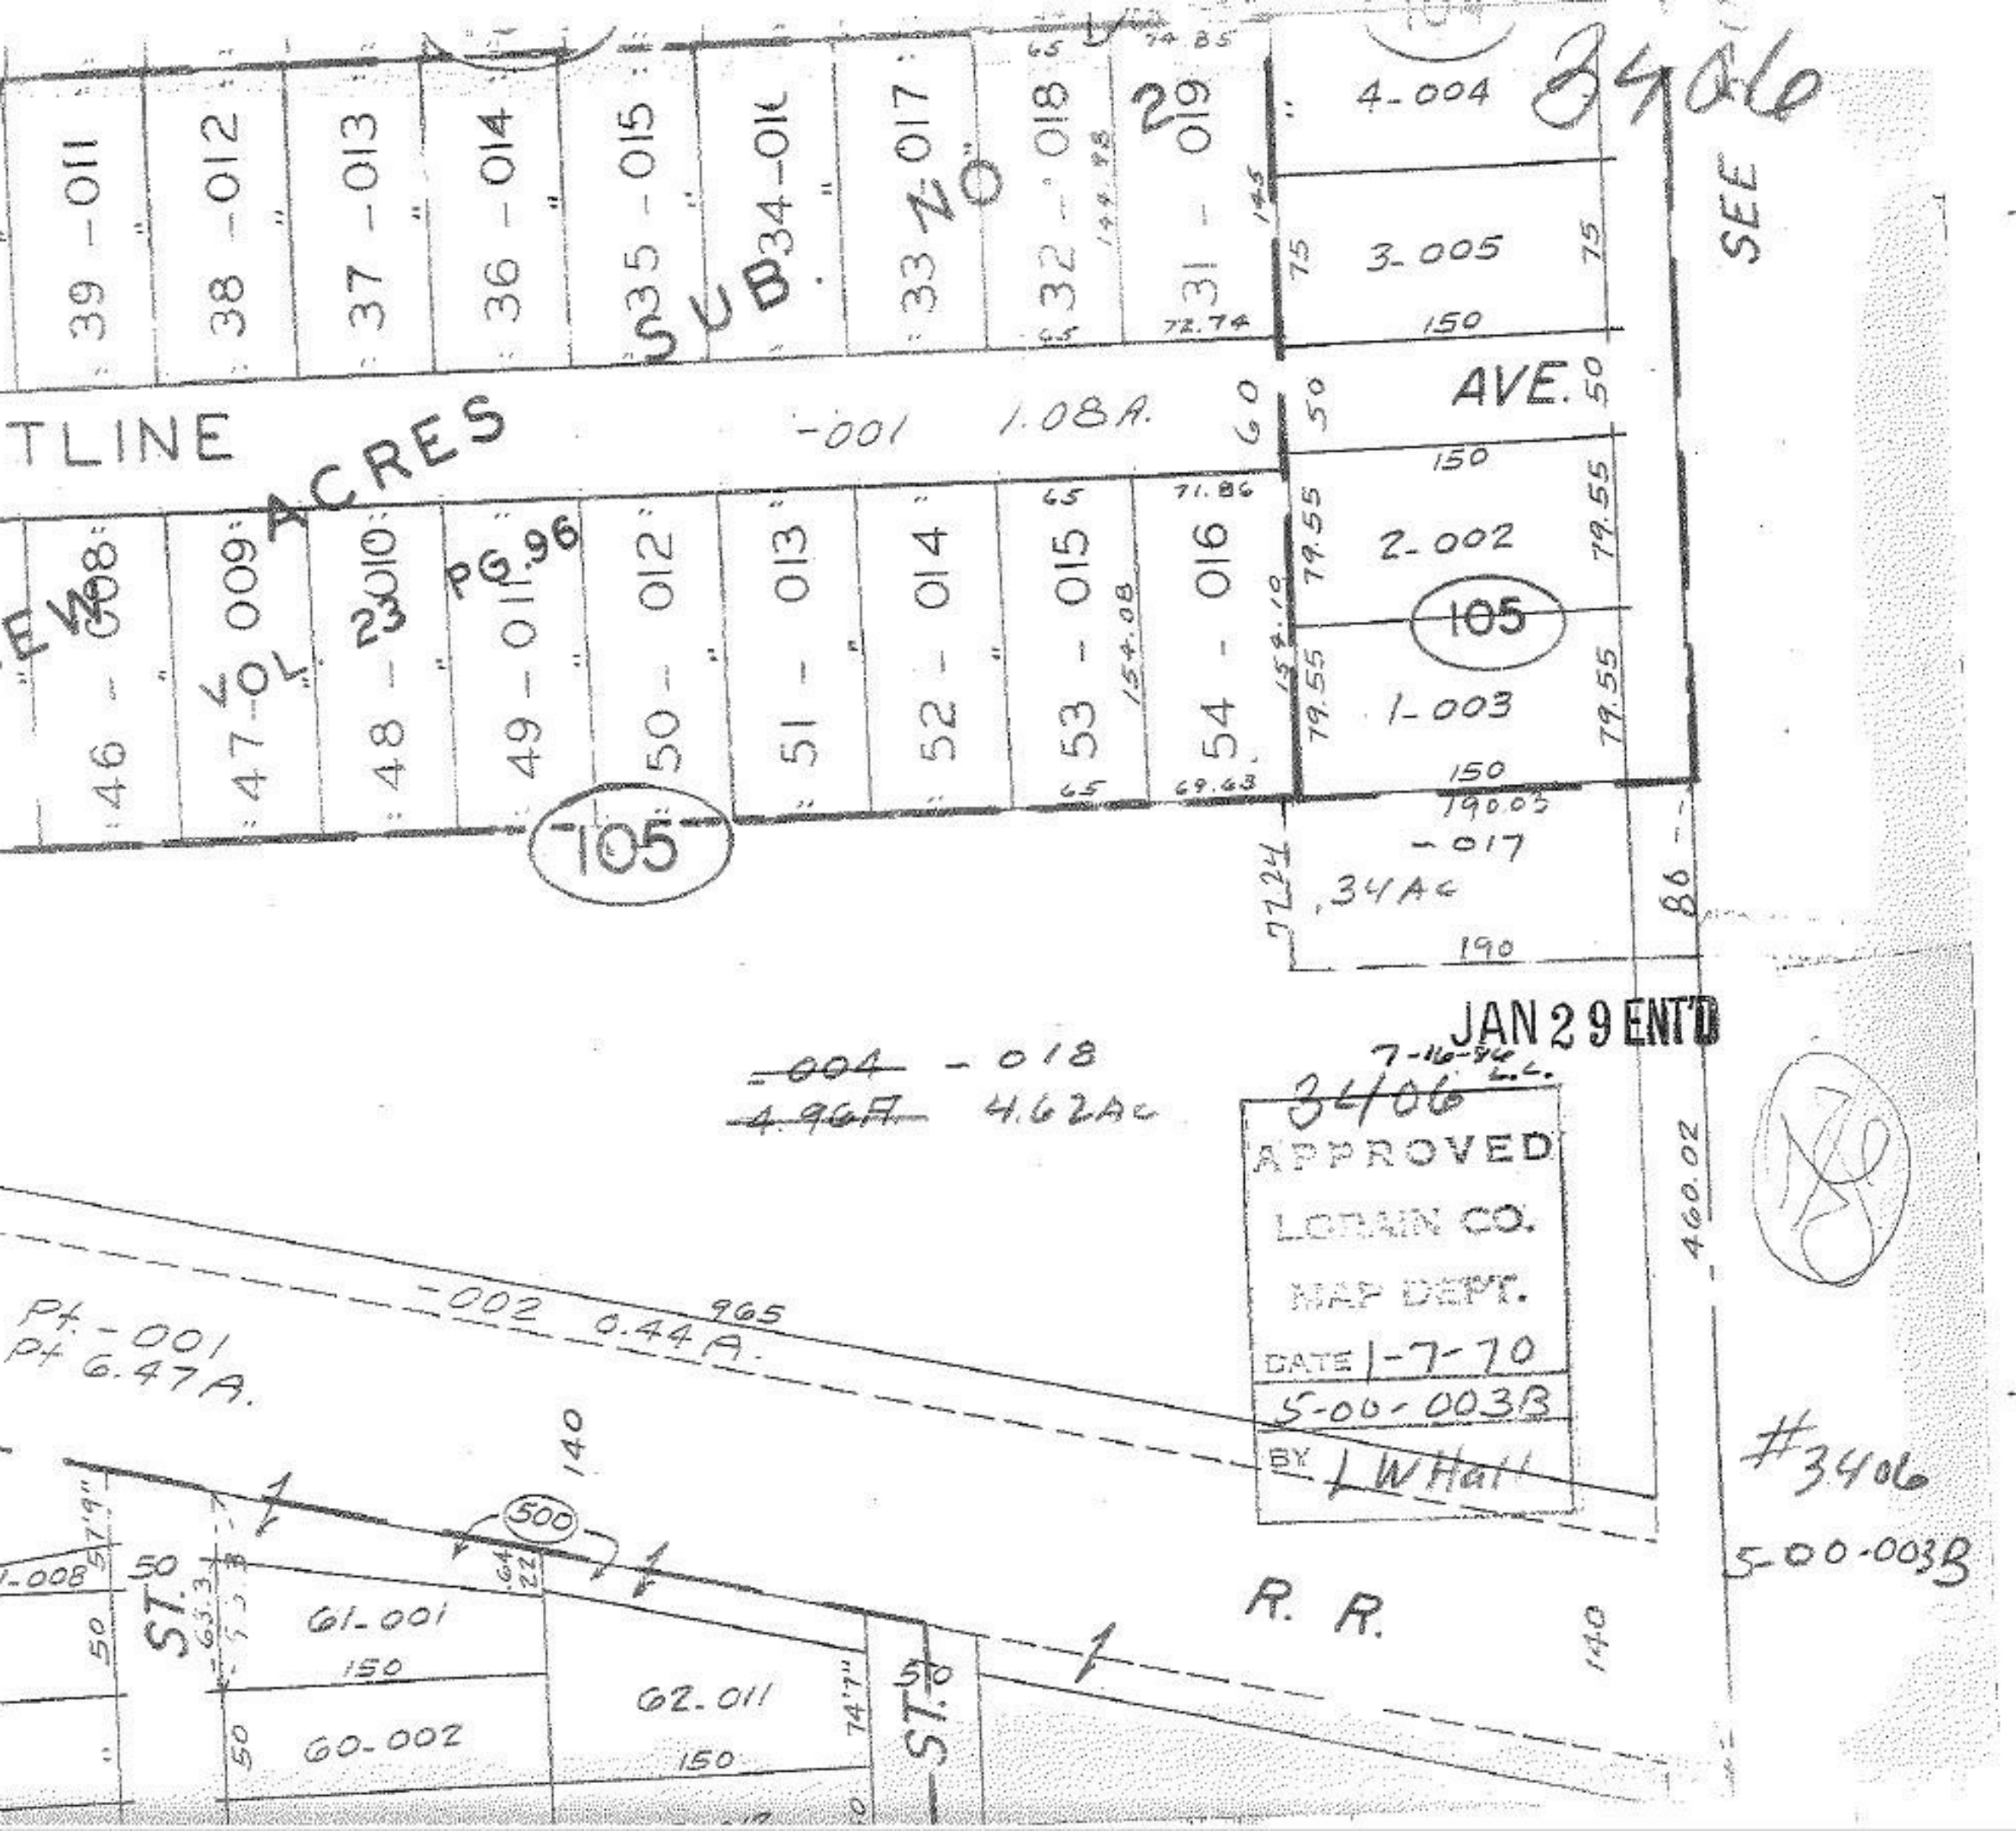

3406
SEE
4-004
3-005
150
AVE.
2-002
105
1-003
150
-017
.34AC
190
JAN 29 ENT'D
7-16-96
3406
APPROVED
LORAIN CO.
MAP DEPT.
DATE 1-7-70
5-00-003B
BY LWHall
#3406
5-00-003B
TLINE
ACRES
-001 1.08A.
SUB. NO 29
39-011
38-012
37-013
36-014
35-015
34-016
33-017
32-018
31-019
46-008
47-009
48-010
49-011
50-012
51-013
52-014
53-015
54-016
VOL 23 PG.96
105
-004 -018
4.96A 4.62Ac
-002 0.44A.
Pt.-001
Pt 6.47A.
500
61-001
150
60-002
62-011
150
ST.
R. R.
460.02